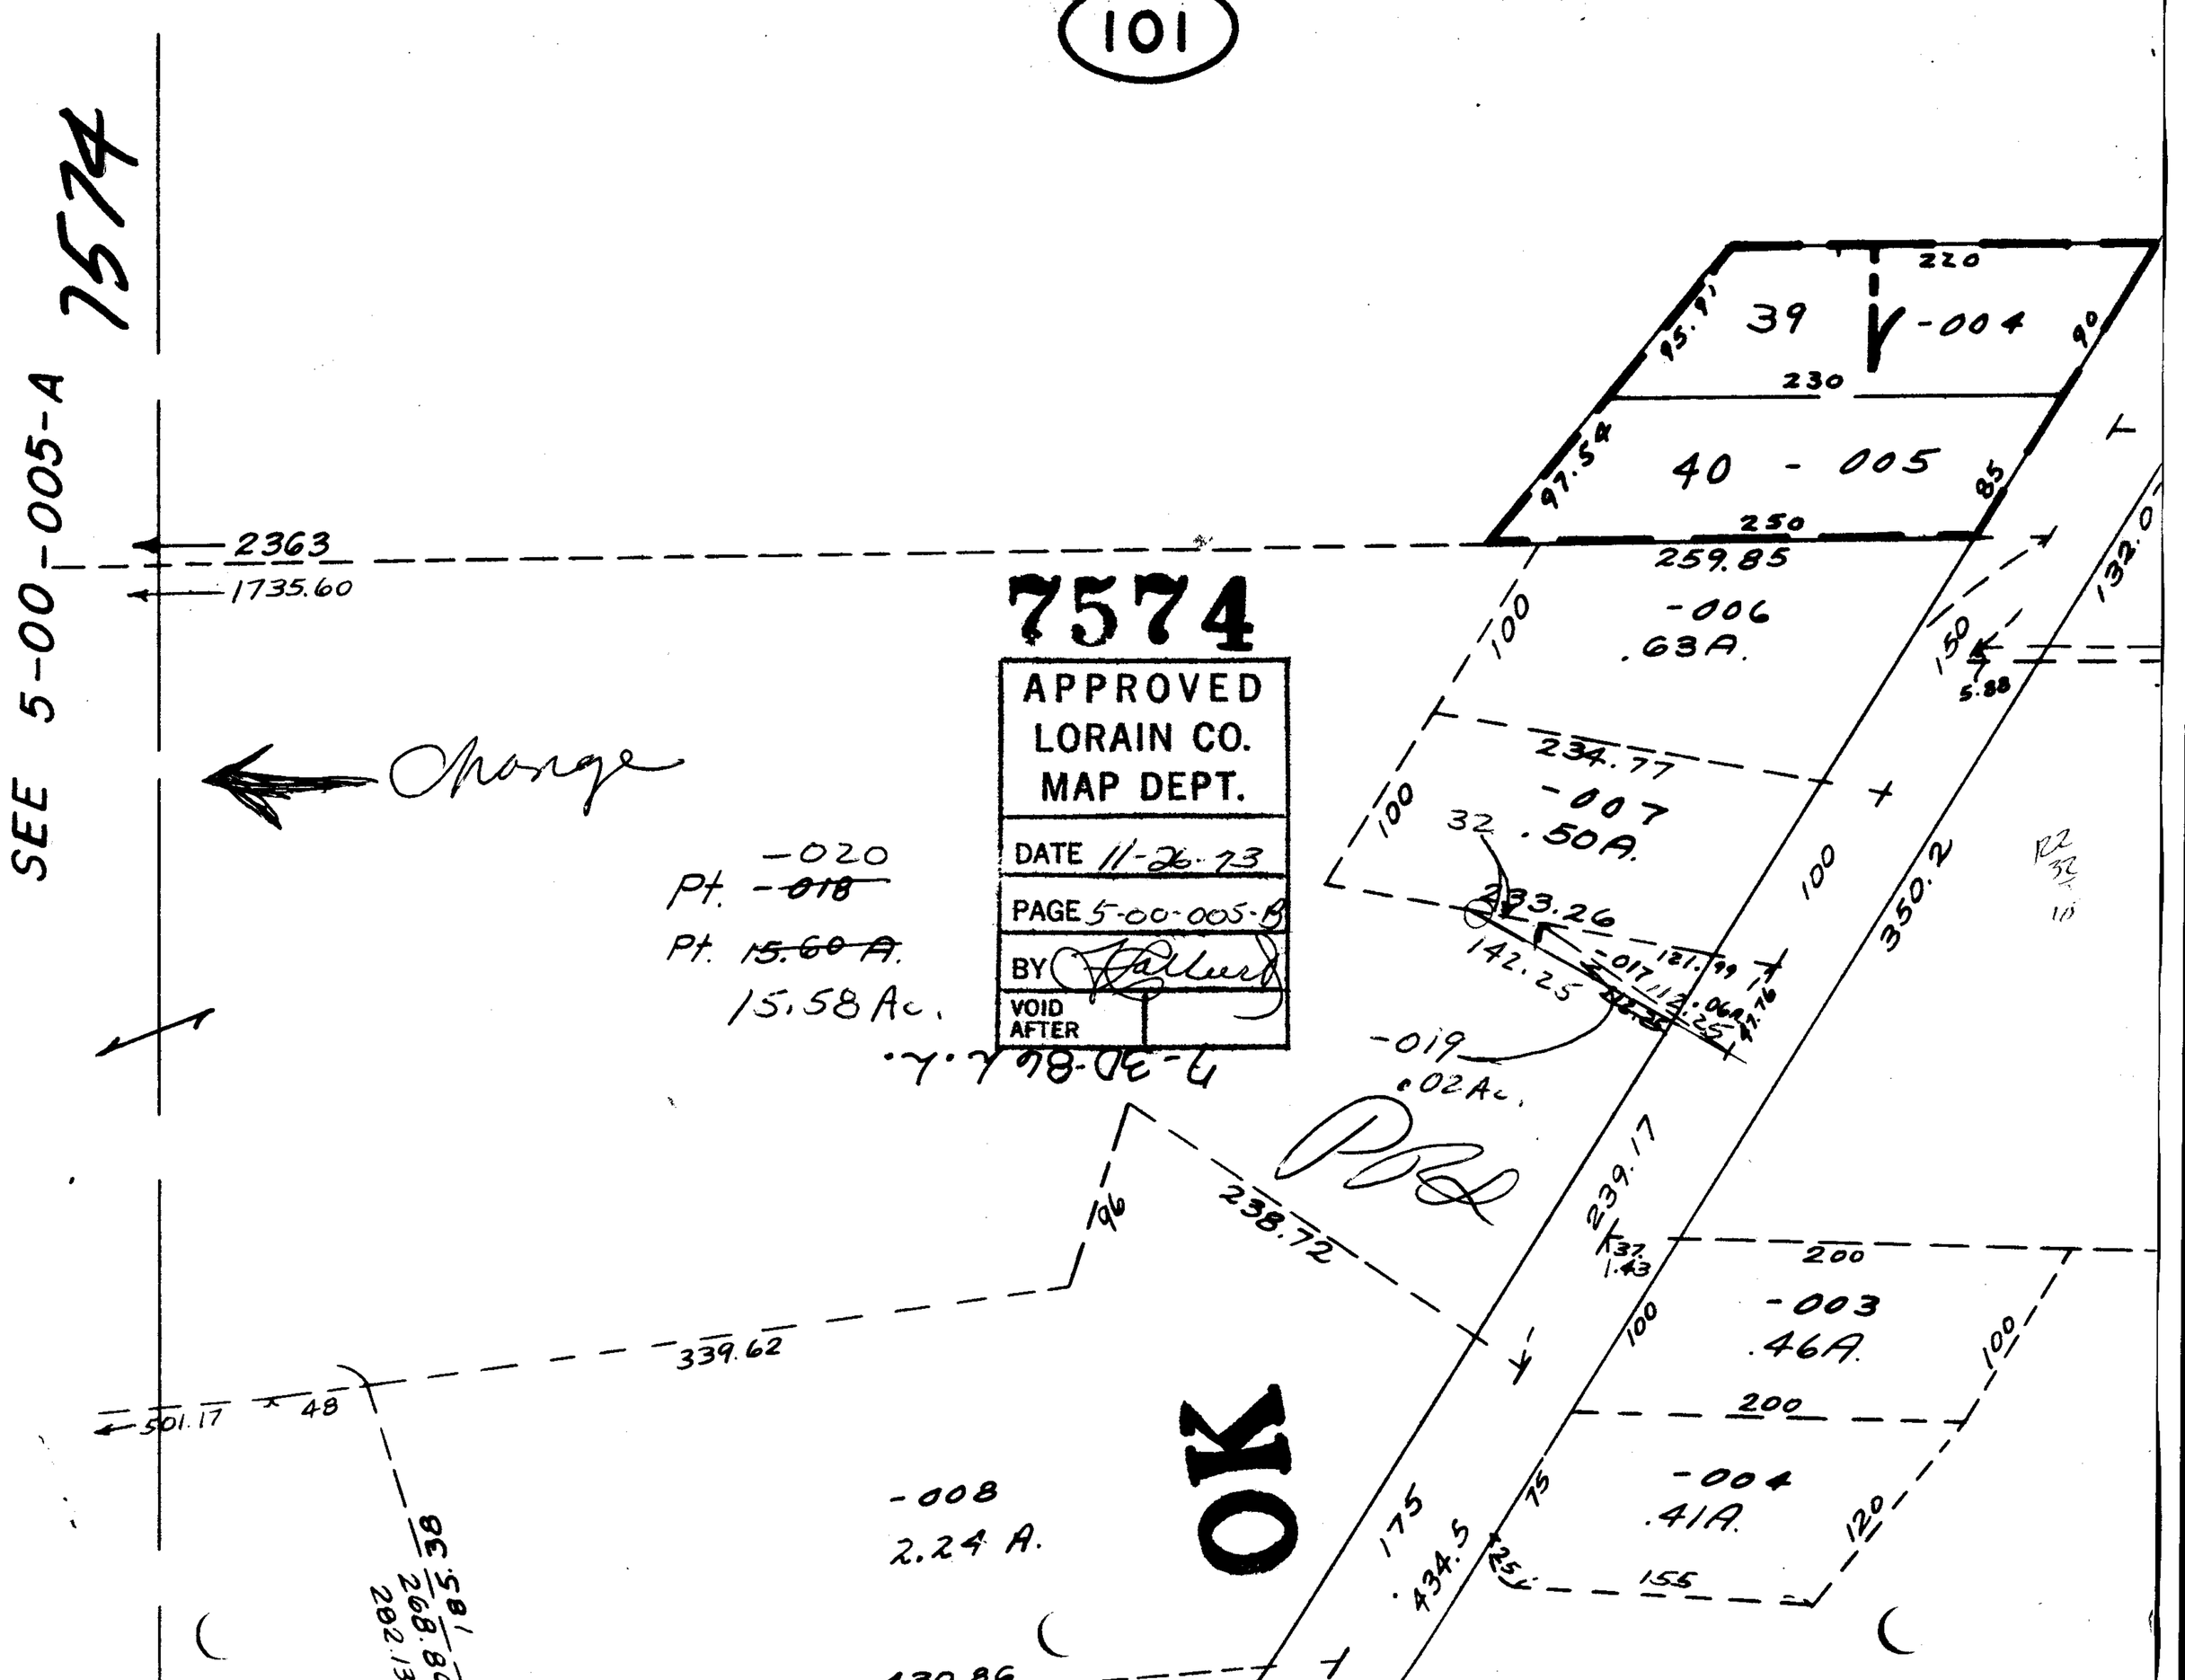
101
7574
SEE 5-00-005-A
2363
1735.60
Change
7574
APPROVED
LORAIN CO.
MAP DEPT.
DATE 11-26-73
PAGE 5-00-005-B
BY
VOID
AFTER
-020
Pt. ~~-018~~
Pt. ~~15.60 A.~~
15.58 Ac.
7-30-86 L.L.
39
-004
40 - 005
220
230
250
259.85
-006
.63A.
234.77
-007
.50A.
233.26
142.25
-019
.02Ac.
238.72
339.62
501.17
-008
2.24 A.
OK
239.17
-003
.46A.
-004
.41A.
434.5
350.2
132.0
200
100
150
75
120
155
175
96
48
95.91
97.54
90
85
5.88
37
1.43
121.99
47.76