


SEE

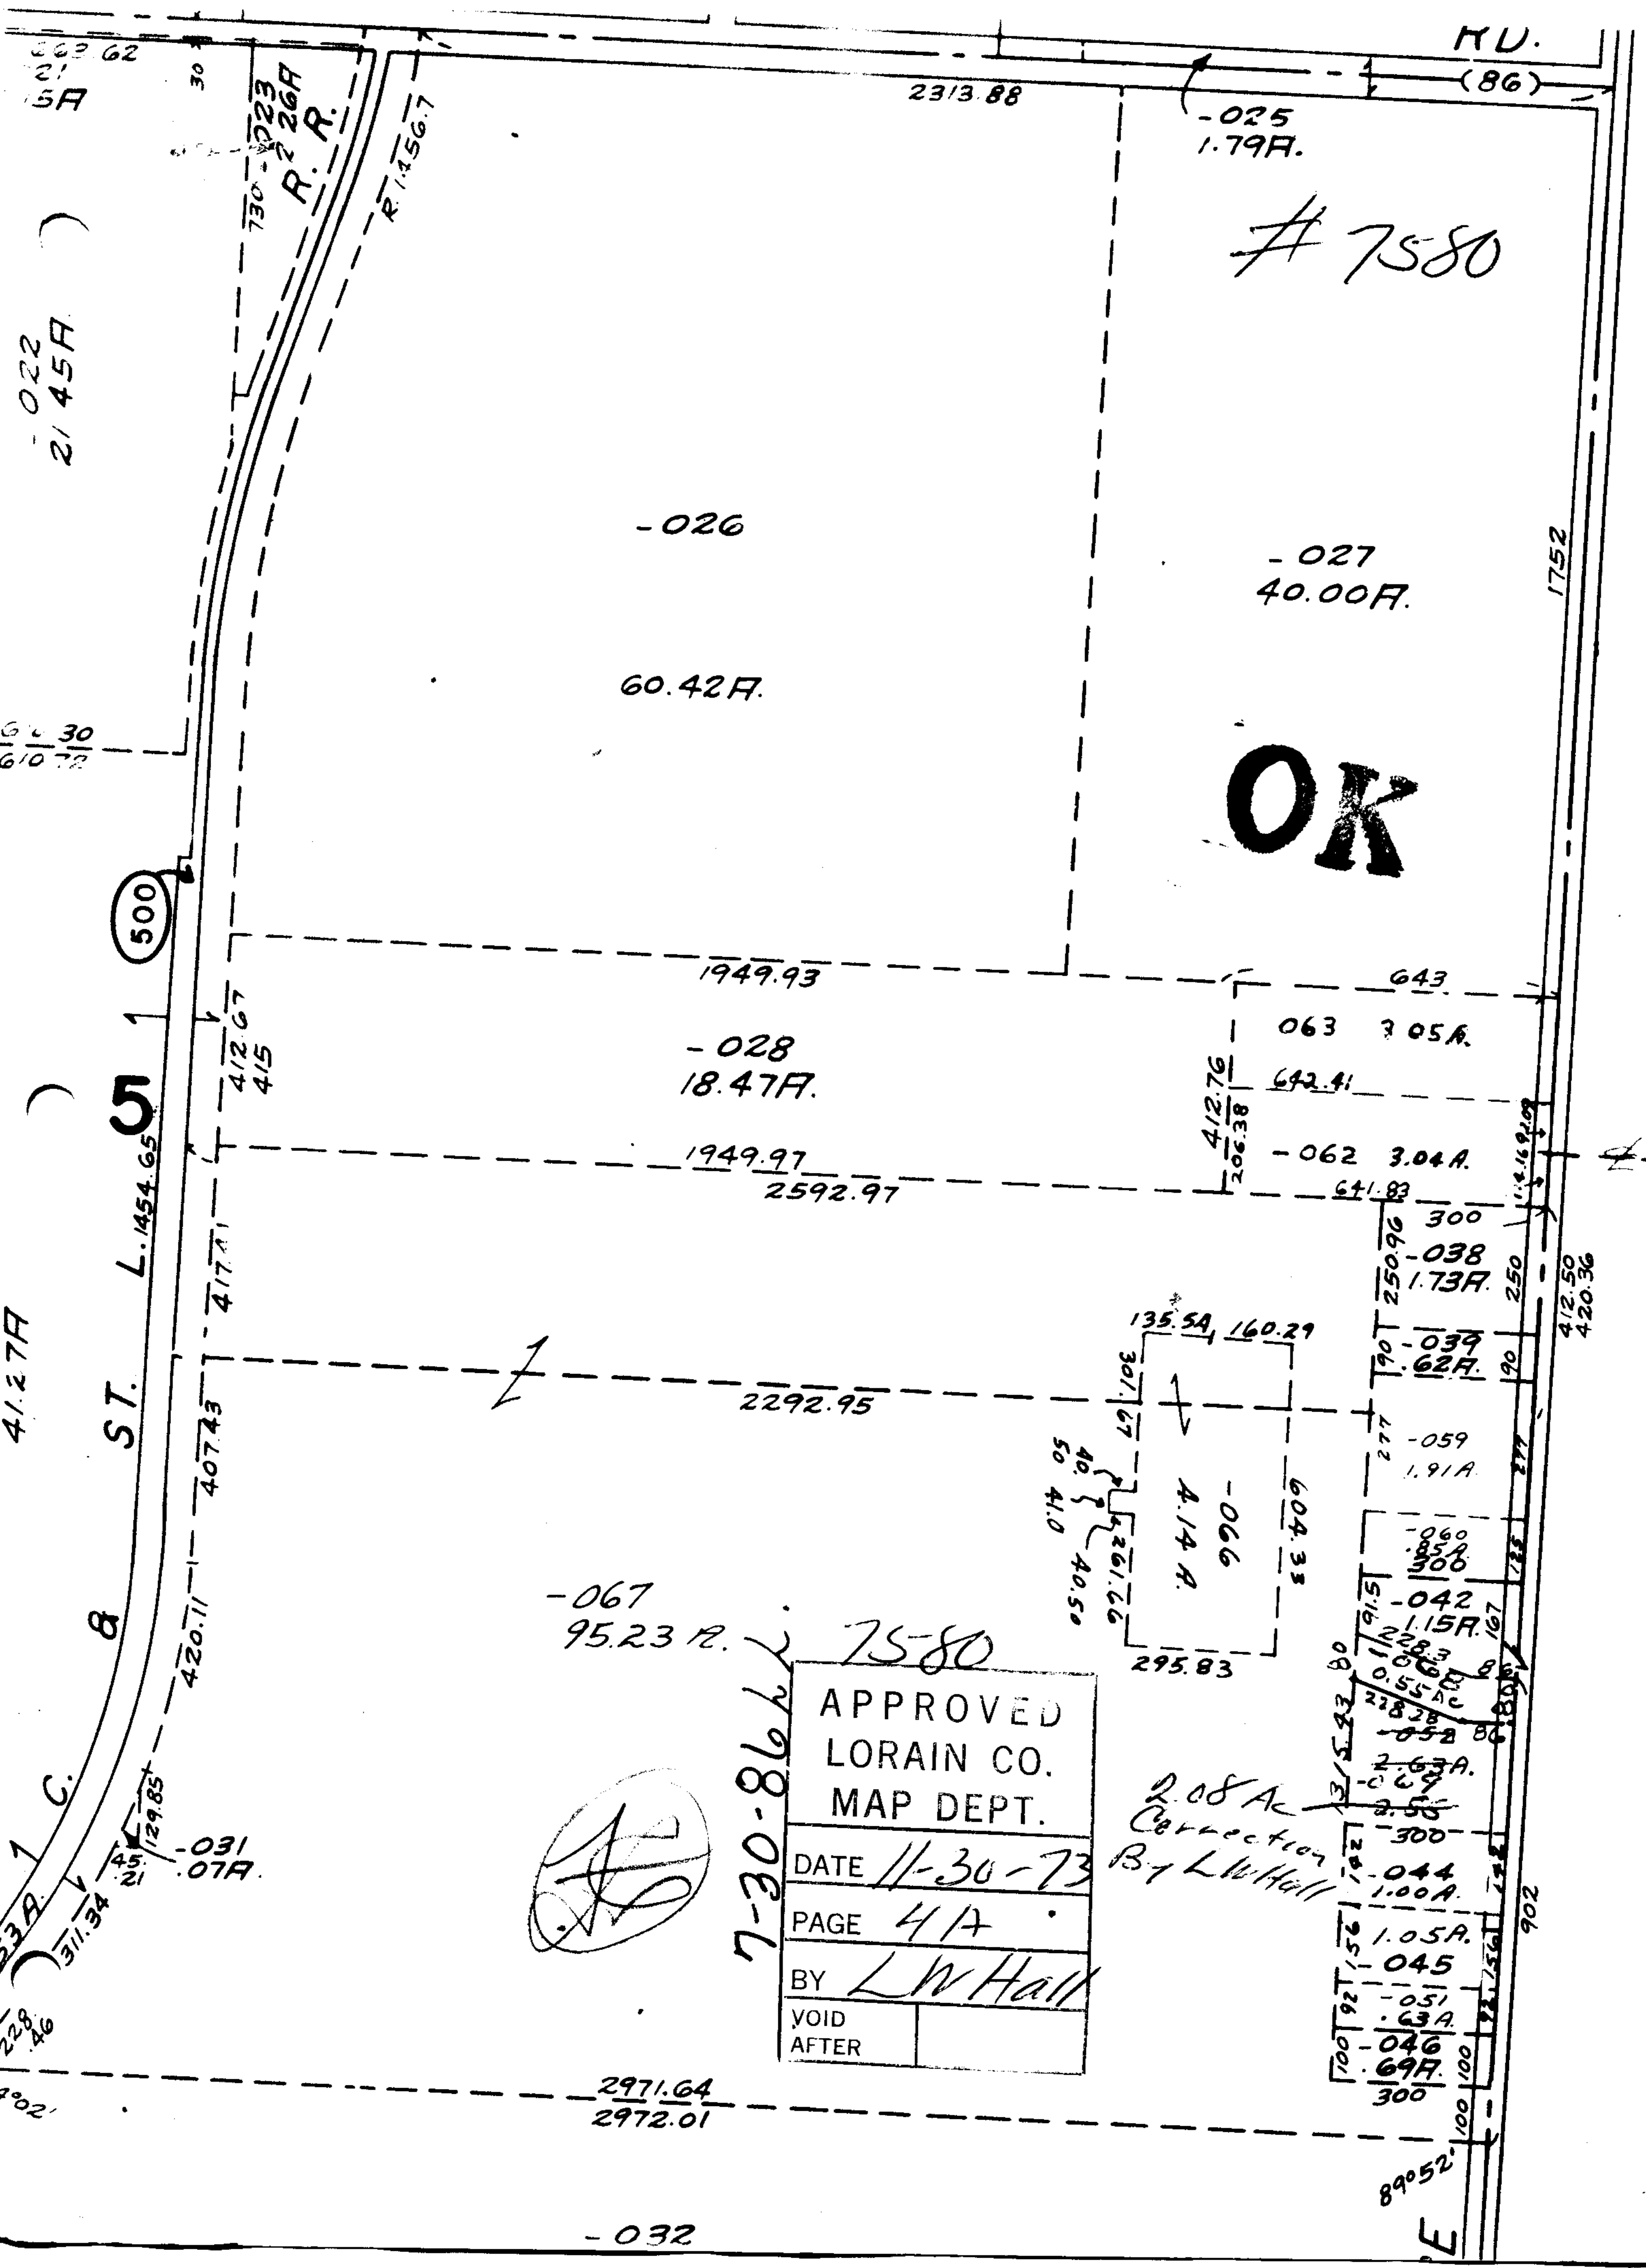

# 7580

OK

7-30-86 L 7580

APPROVED LORAIN CO. MAP DEPT.	
DATE	11-30-73
PAGE	41A
BY	L.W. Hall
VOID AFTER	

W.C.