


SEE 4K

7585

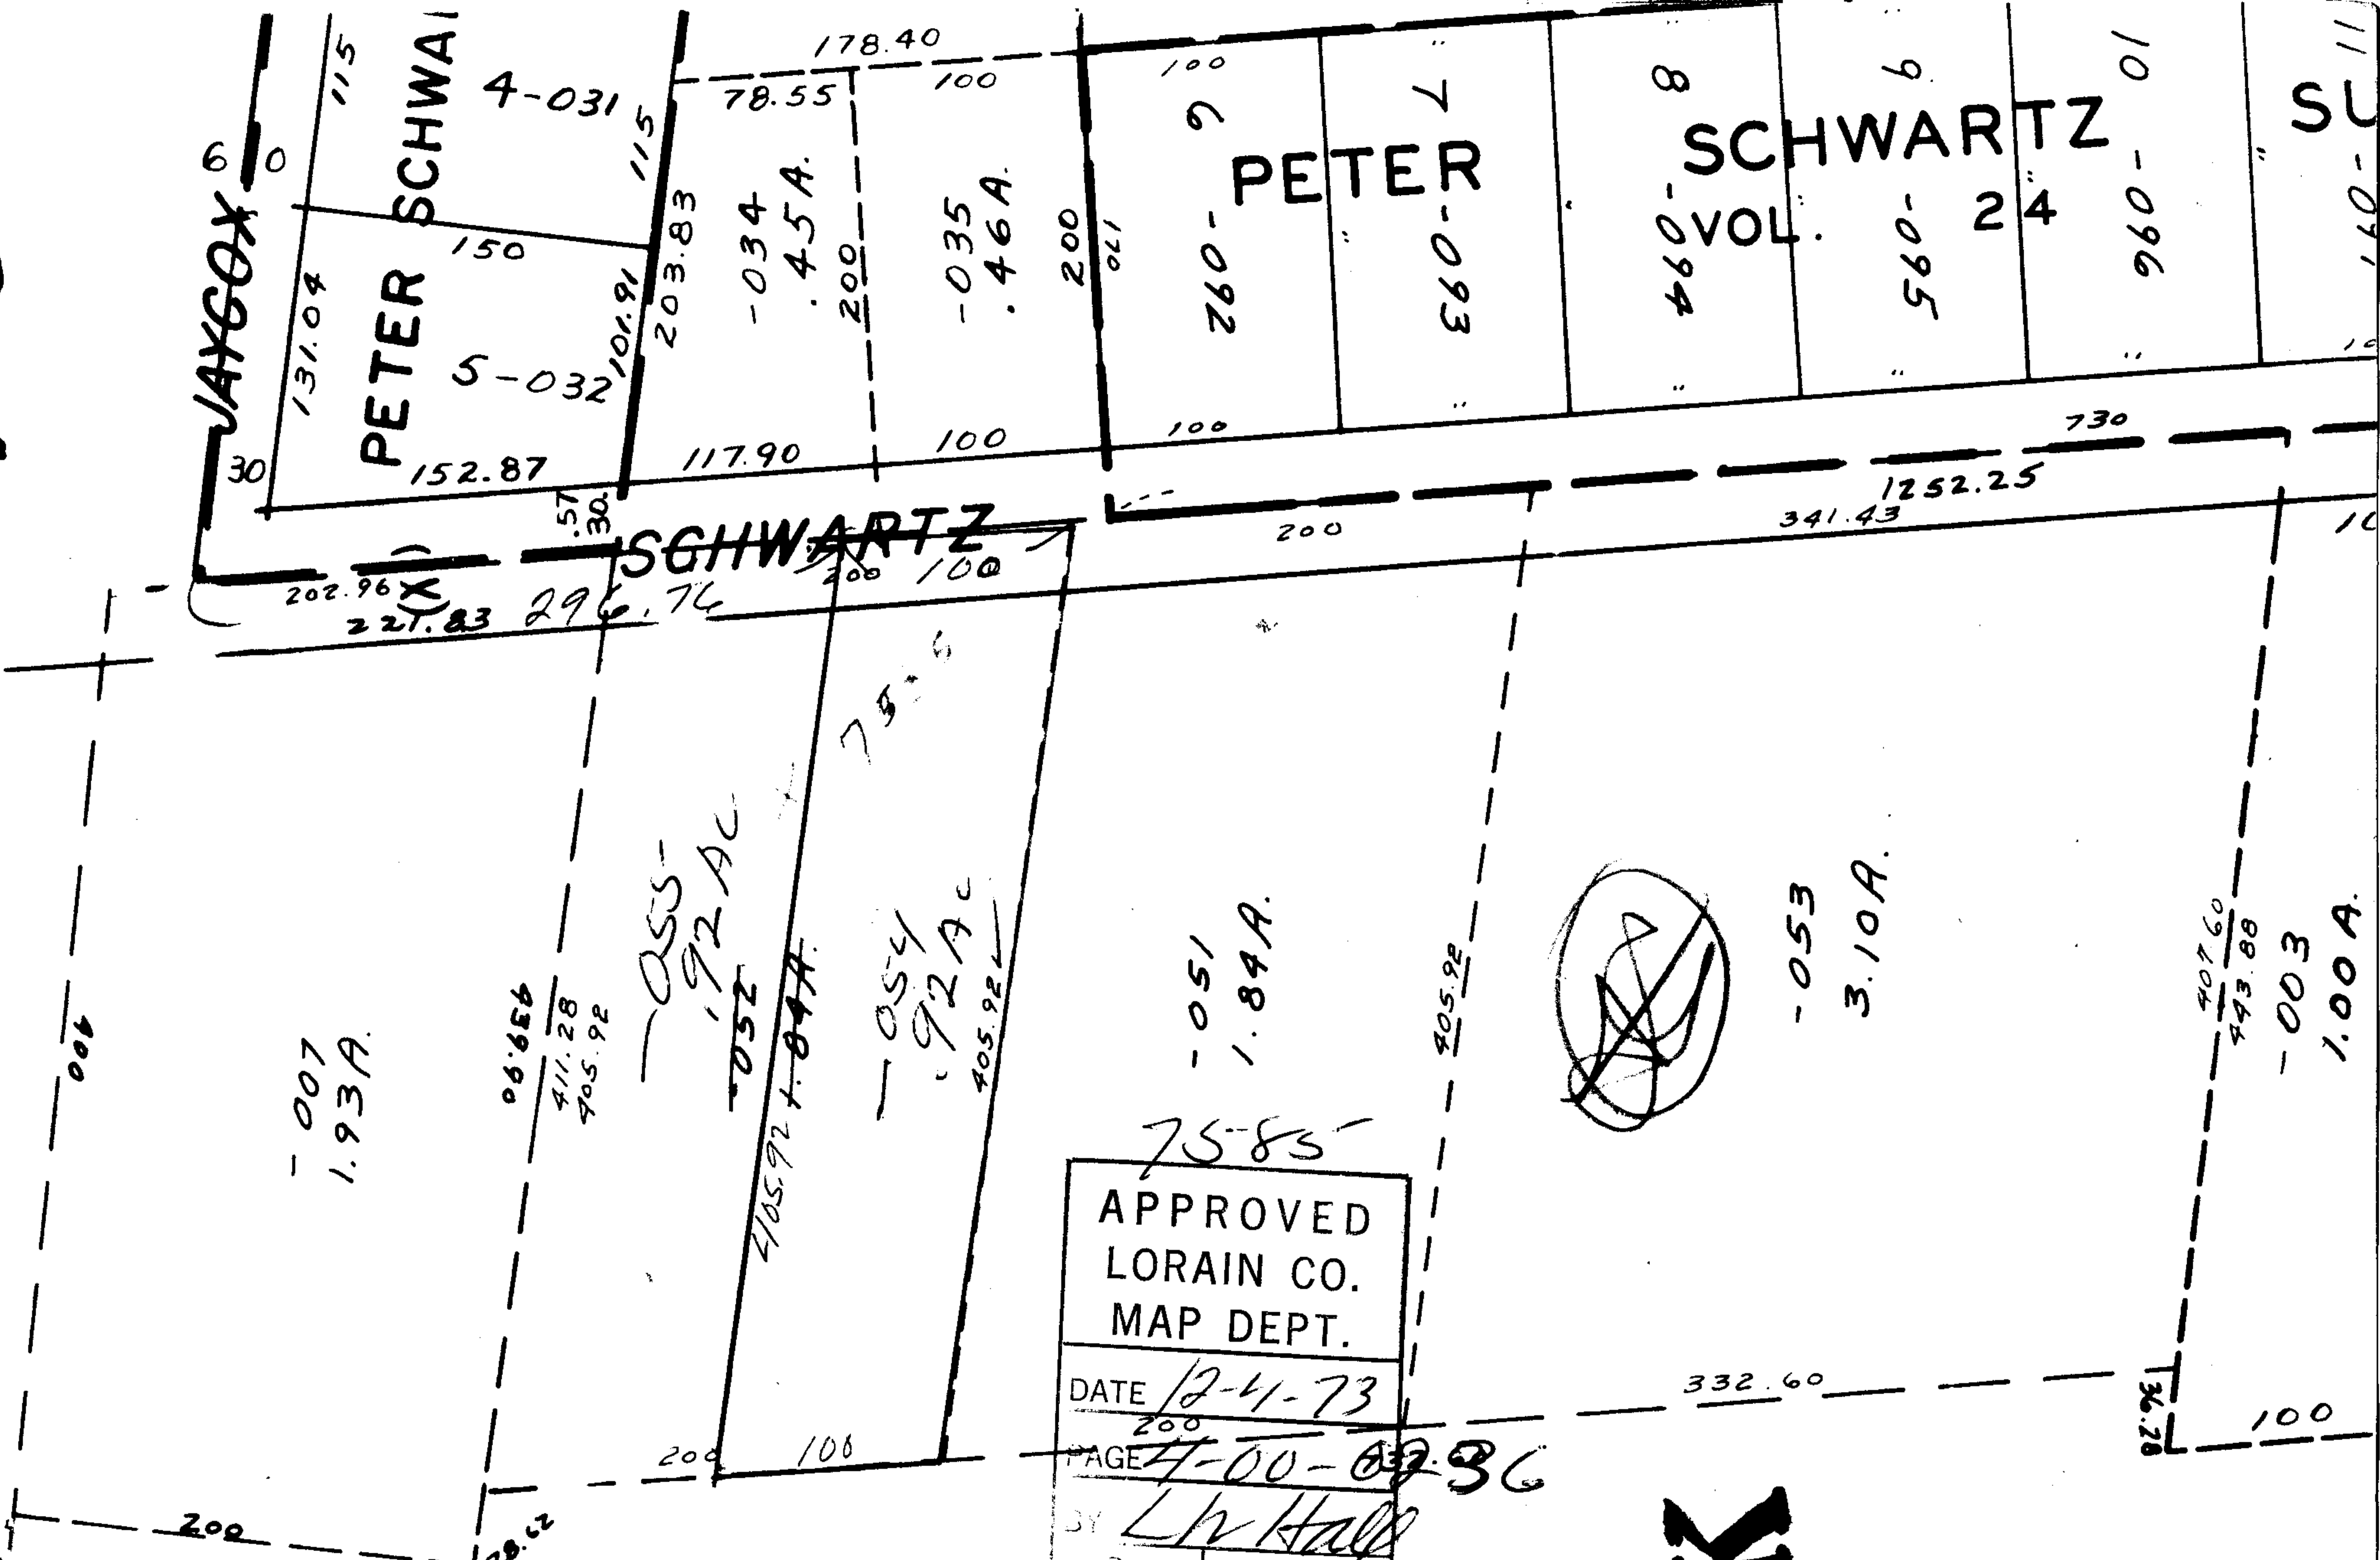

75-85

APPROVED
LORAIN CO.
MAP DEPT.

DATE 12-4-73

PAGE 4-00-032-86

BY L.V. Hall

VOID
AFTER

OK

7-30-86 K.L.