

~~7595~~
7595

7595


APPROVED LORAIN CO. MAP DEPT.	
DATE	12-7-73
PAGE	3-00-107 B
BY	L. W. Hall
VOID AFTER	

OK

102

-012
1.72 A

S. 8-13-86

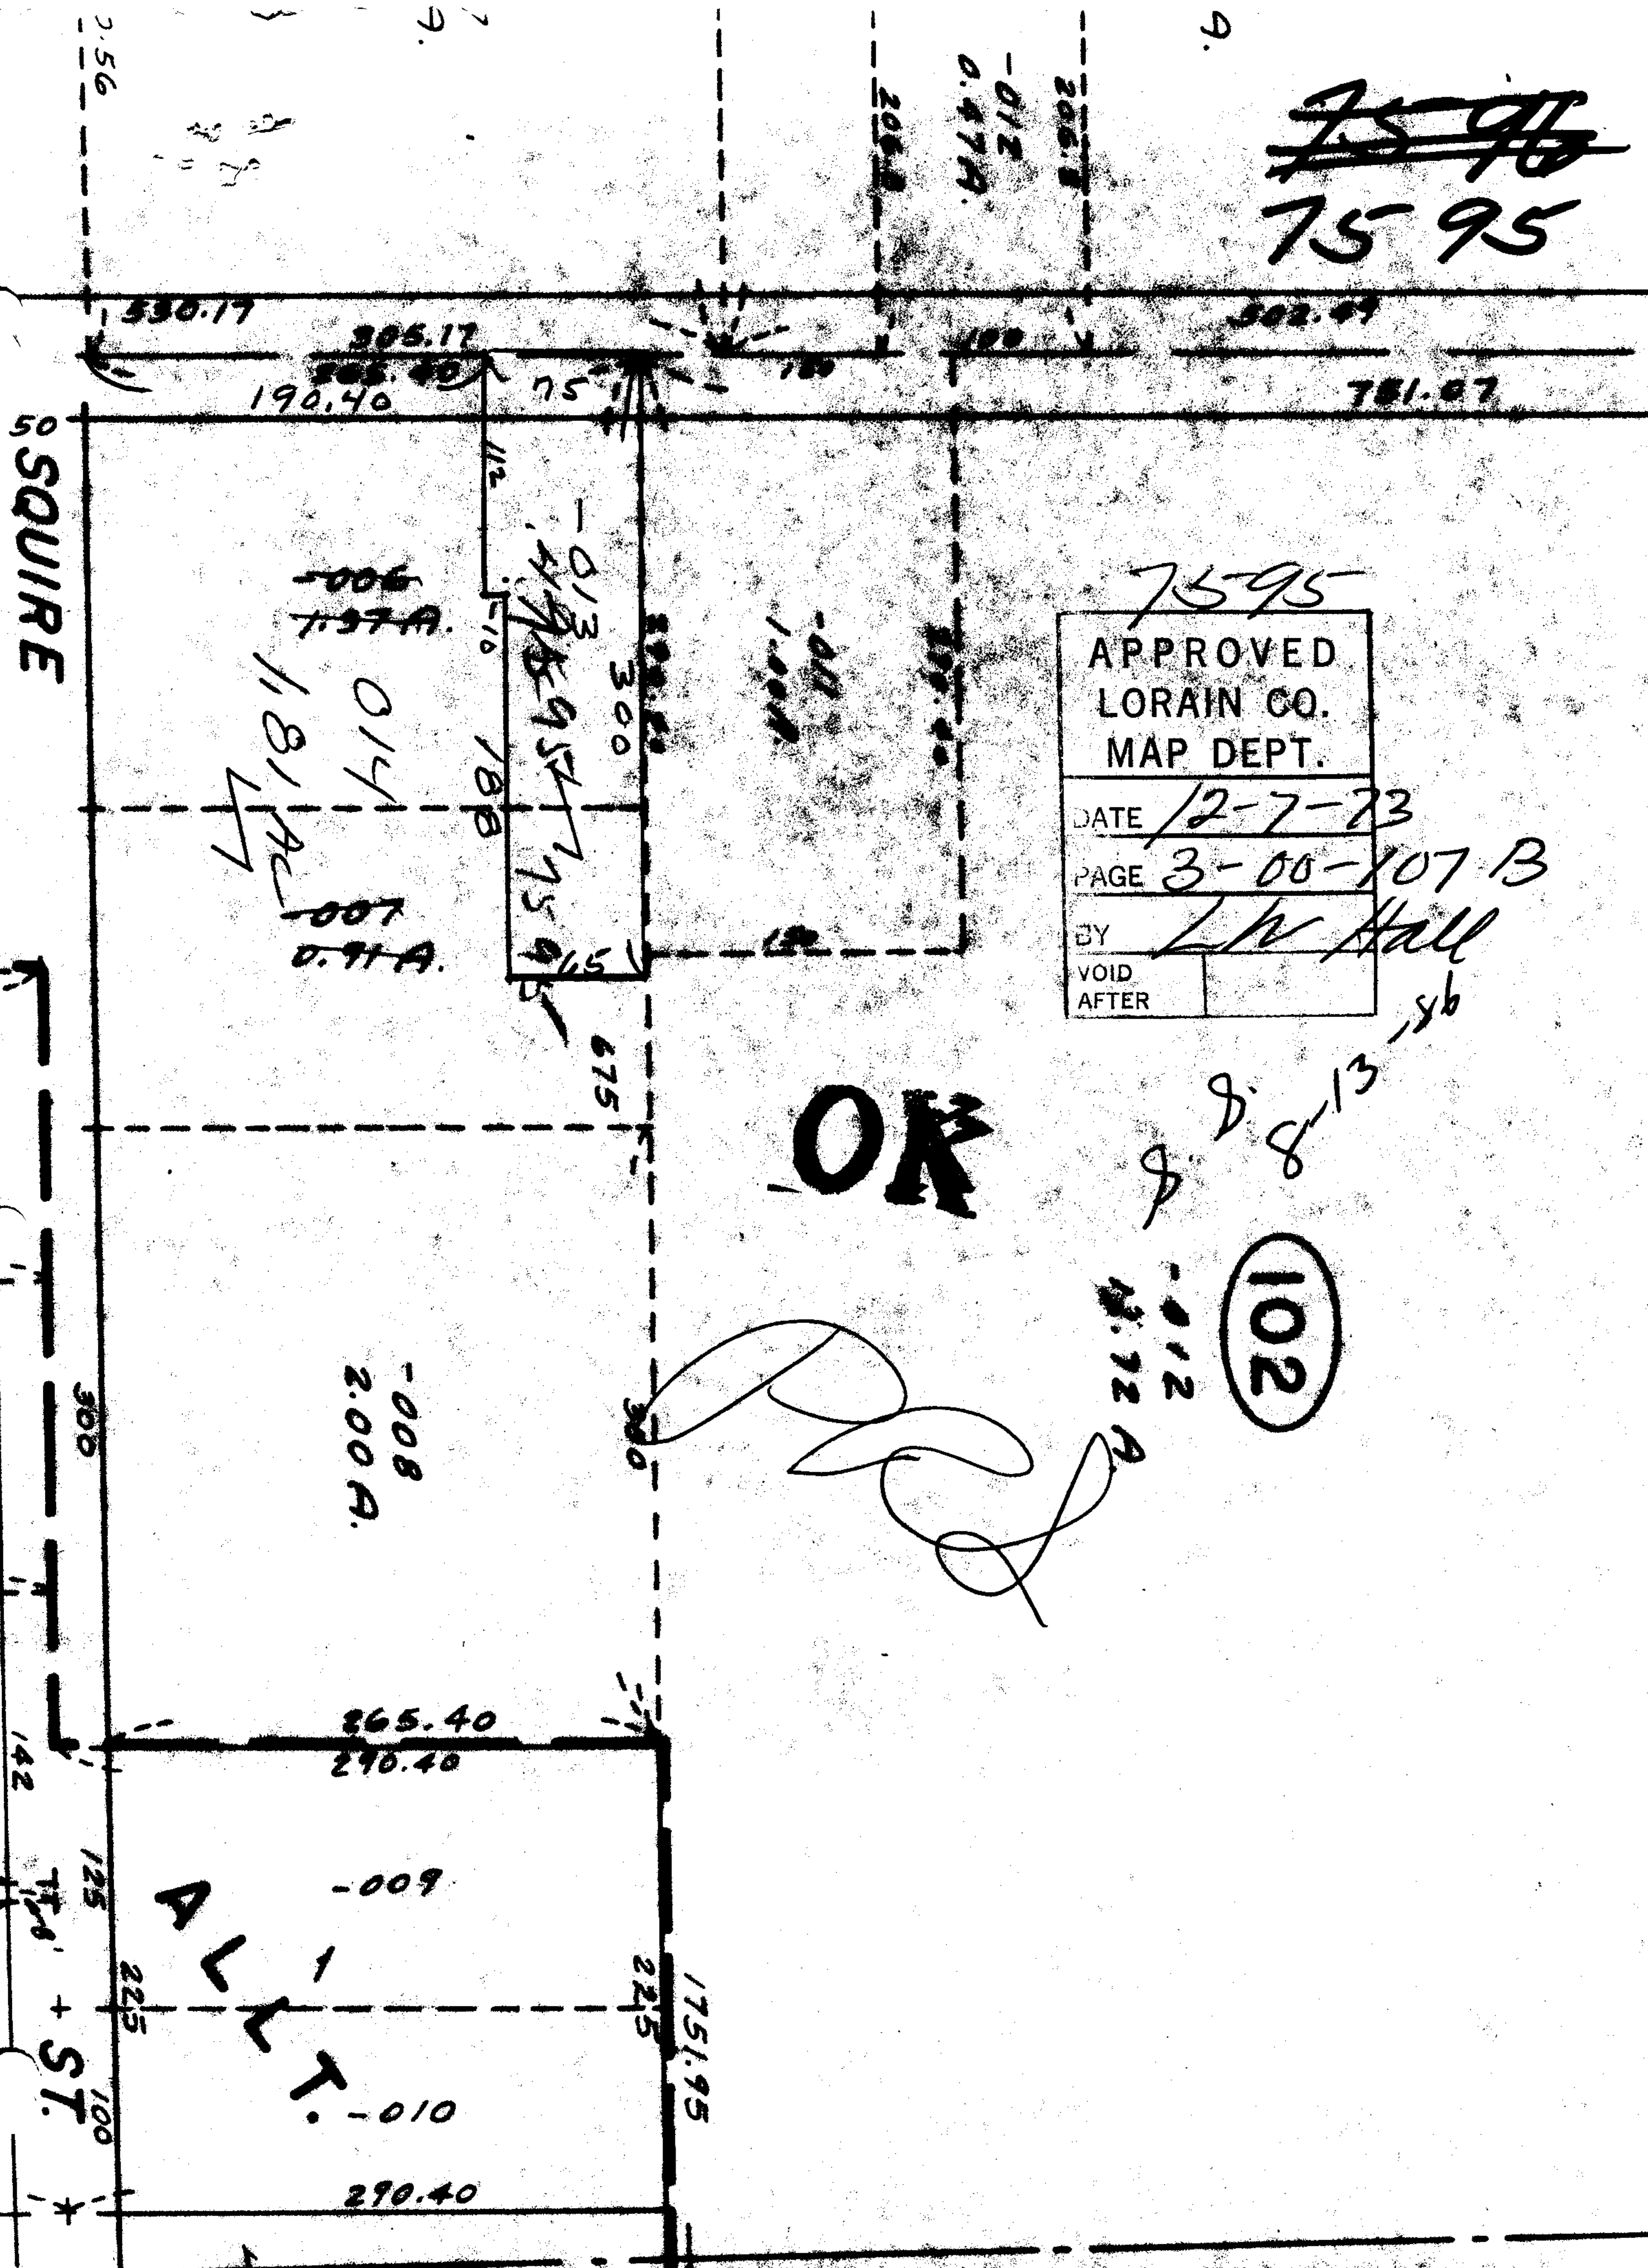



ST.

-008
2.00 A.

-006
1.97 A.
1.81 A.
0.14
-007
0.91 A.

-013
1.95 A.
1.75 A.

-011
1.00 A.

-012

365.40
290.40

-009

-010

290.40

1751.95

675

300

180

112

190.40

305.17

530.17

781.07

-012
0.47 A.

306.8

206.8

2.56

7

9.

300

150

300

125

225

100

142