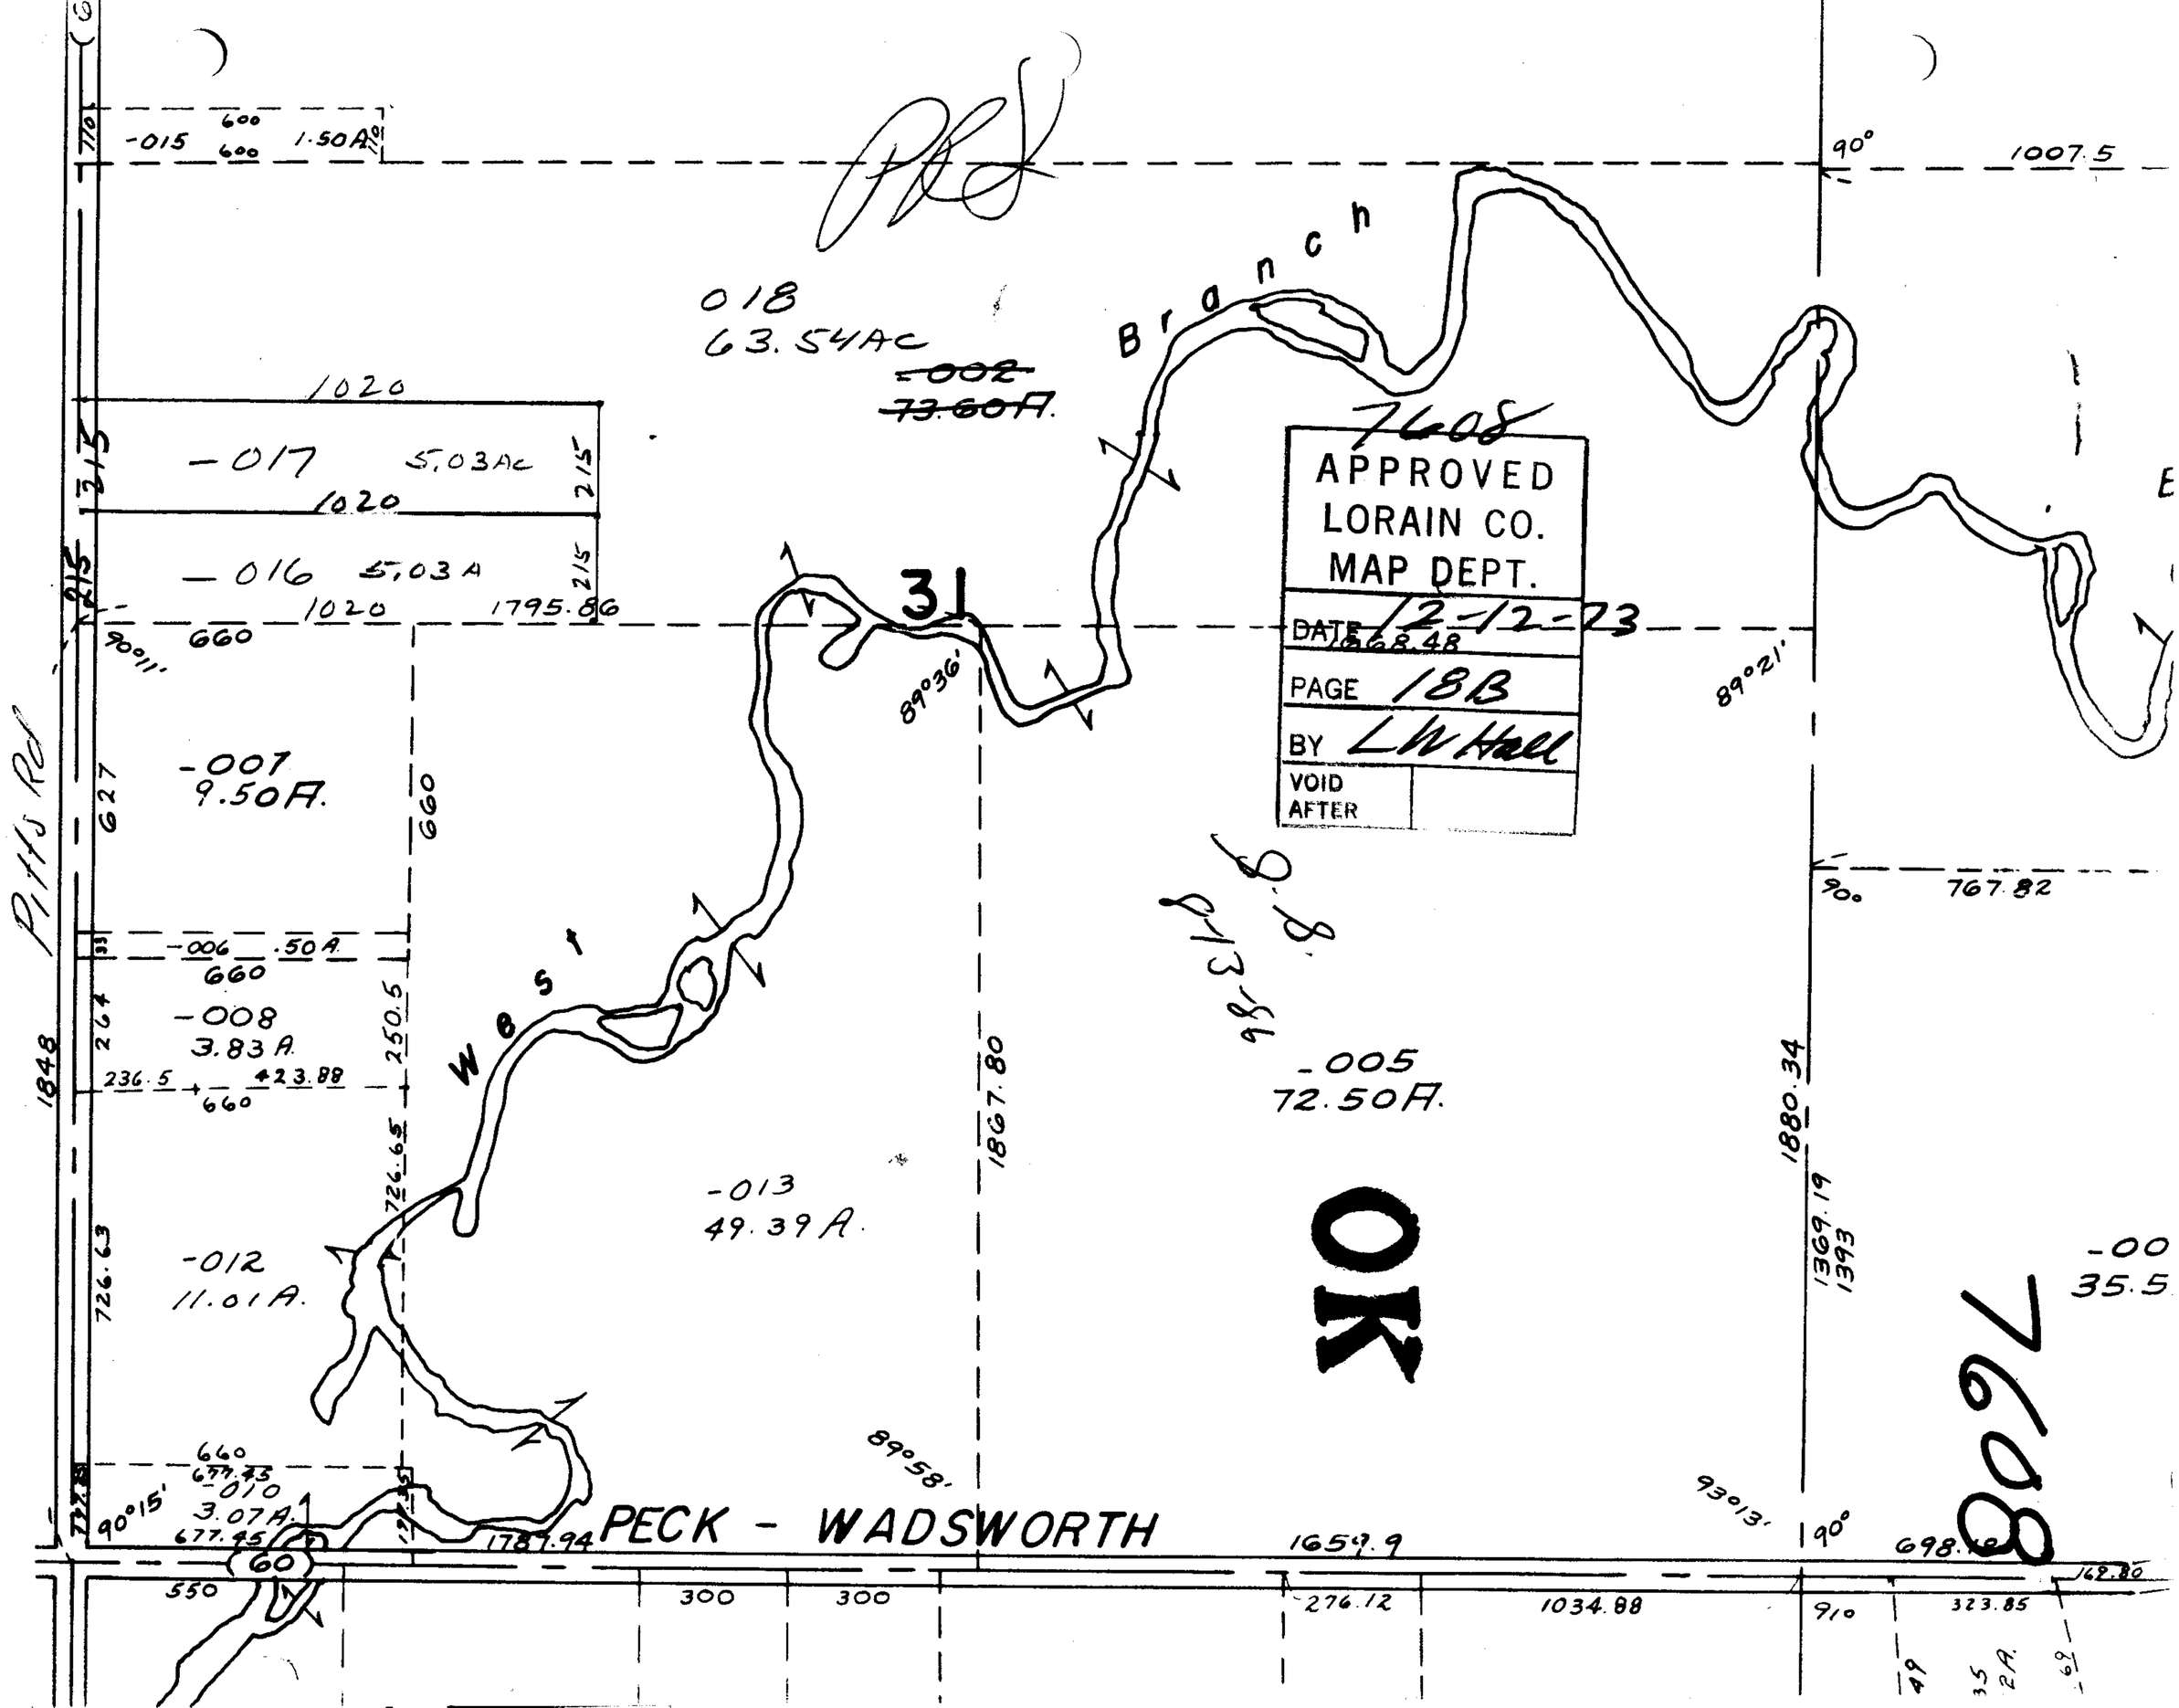

-015 600 600 1.50A
90°
1007.5
018
63.54AC
~~-002~~
~~73.60A.~~
Branch
1020
-017 5.03Ac
215
1020
-016 5.03A
215
1020 1795.86
660
90°11'
31
89°36'
7608
APPROVED
LORAIN CO.
MAP DEPT.
DATE 12-12-73
PAGE 18B
BY LW Hall
VOID
AFTER
89°21'
-007
9.50A.
627
660
Pitts Rd
-006 .50A.
660
-008
3.83A.
264
250.5
236.5 423.88
660
1848
West
1867.80
-005
72.50A.
90°
767.82
1880.34
1369.19
1393
-013
49.39A.
726.65
726.63
-012
11.01A.
OK
-00
35.5
7608
660
677.45
-010
3.07A.
90°15'
677.45
1787.94
PECK - WADSWORTH
89°58'
93°13'
90°
1659.9
698.
60
550
300
300
276.12
1034.88
910
323.85
169.80