

7609

061
~~065~~
~~24.57A.~~
22.31Ac


NO

-041
4.14A

7609

APPROVED
LORAIN CO.
MAP DEPT.
DATE 12-12-73
PAGE 10-00-024F
BY L V HAN
VOID AFTER

\$ 813

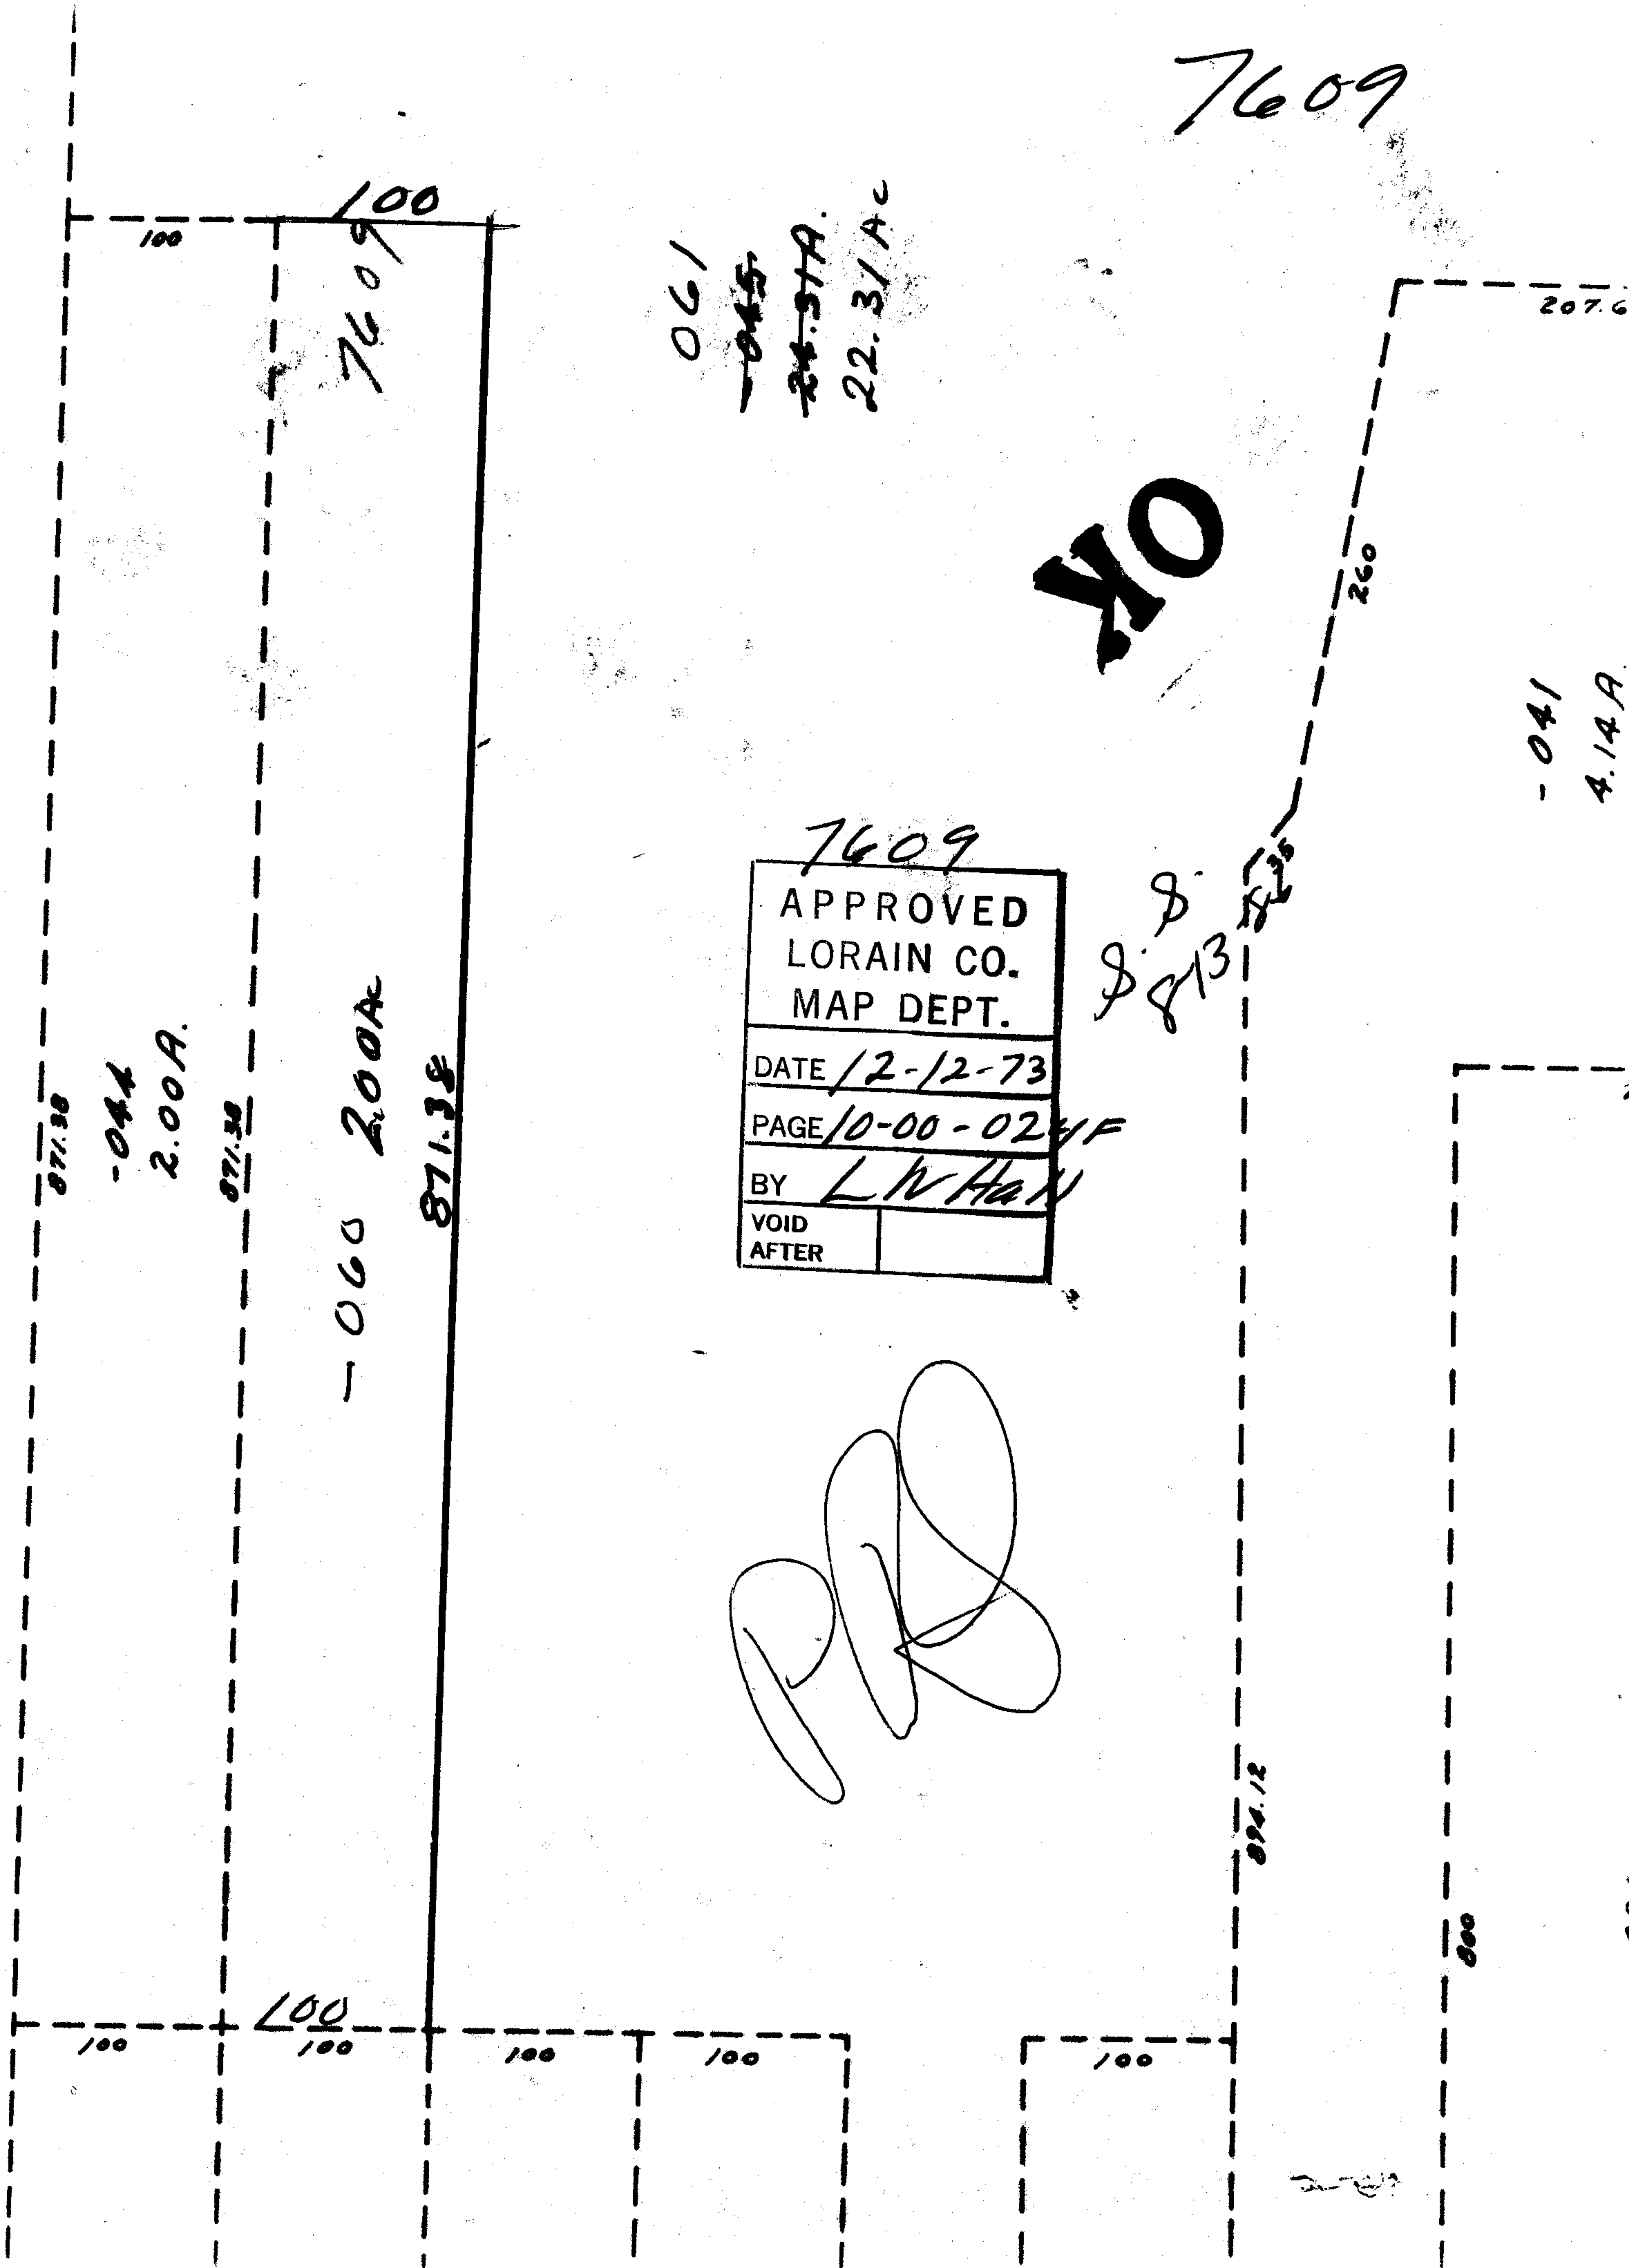

7609

-060 2.00Ac
871.38