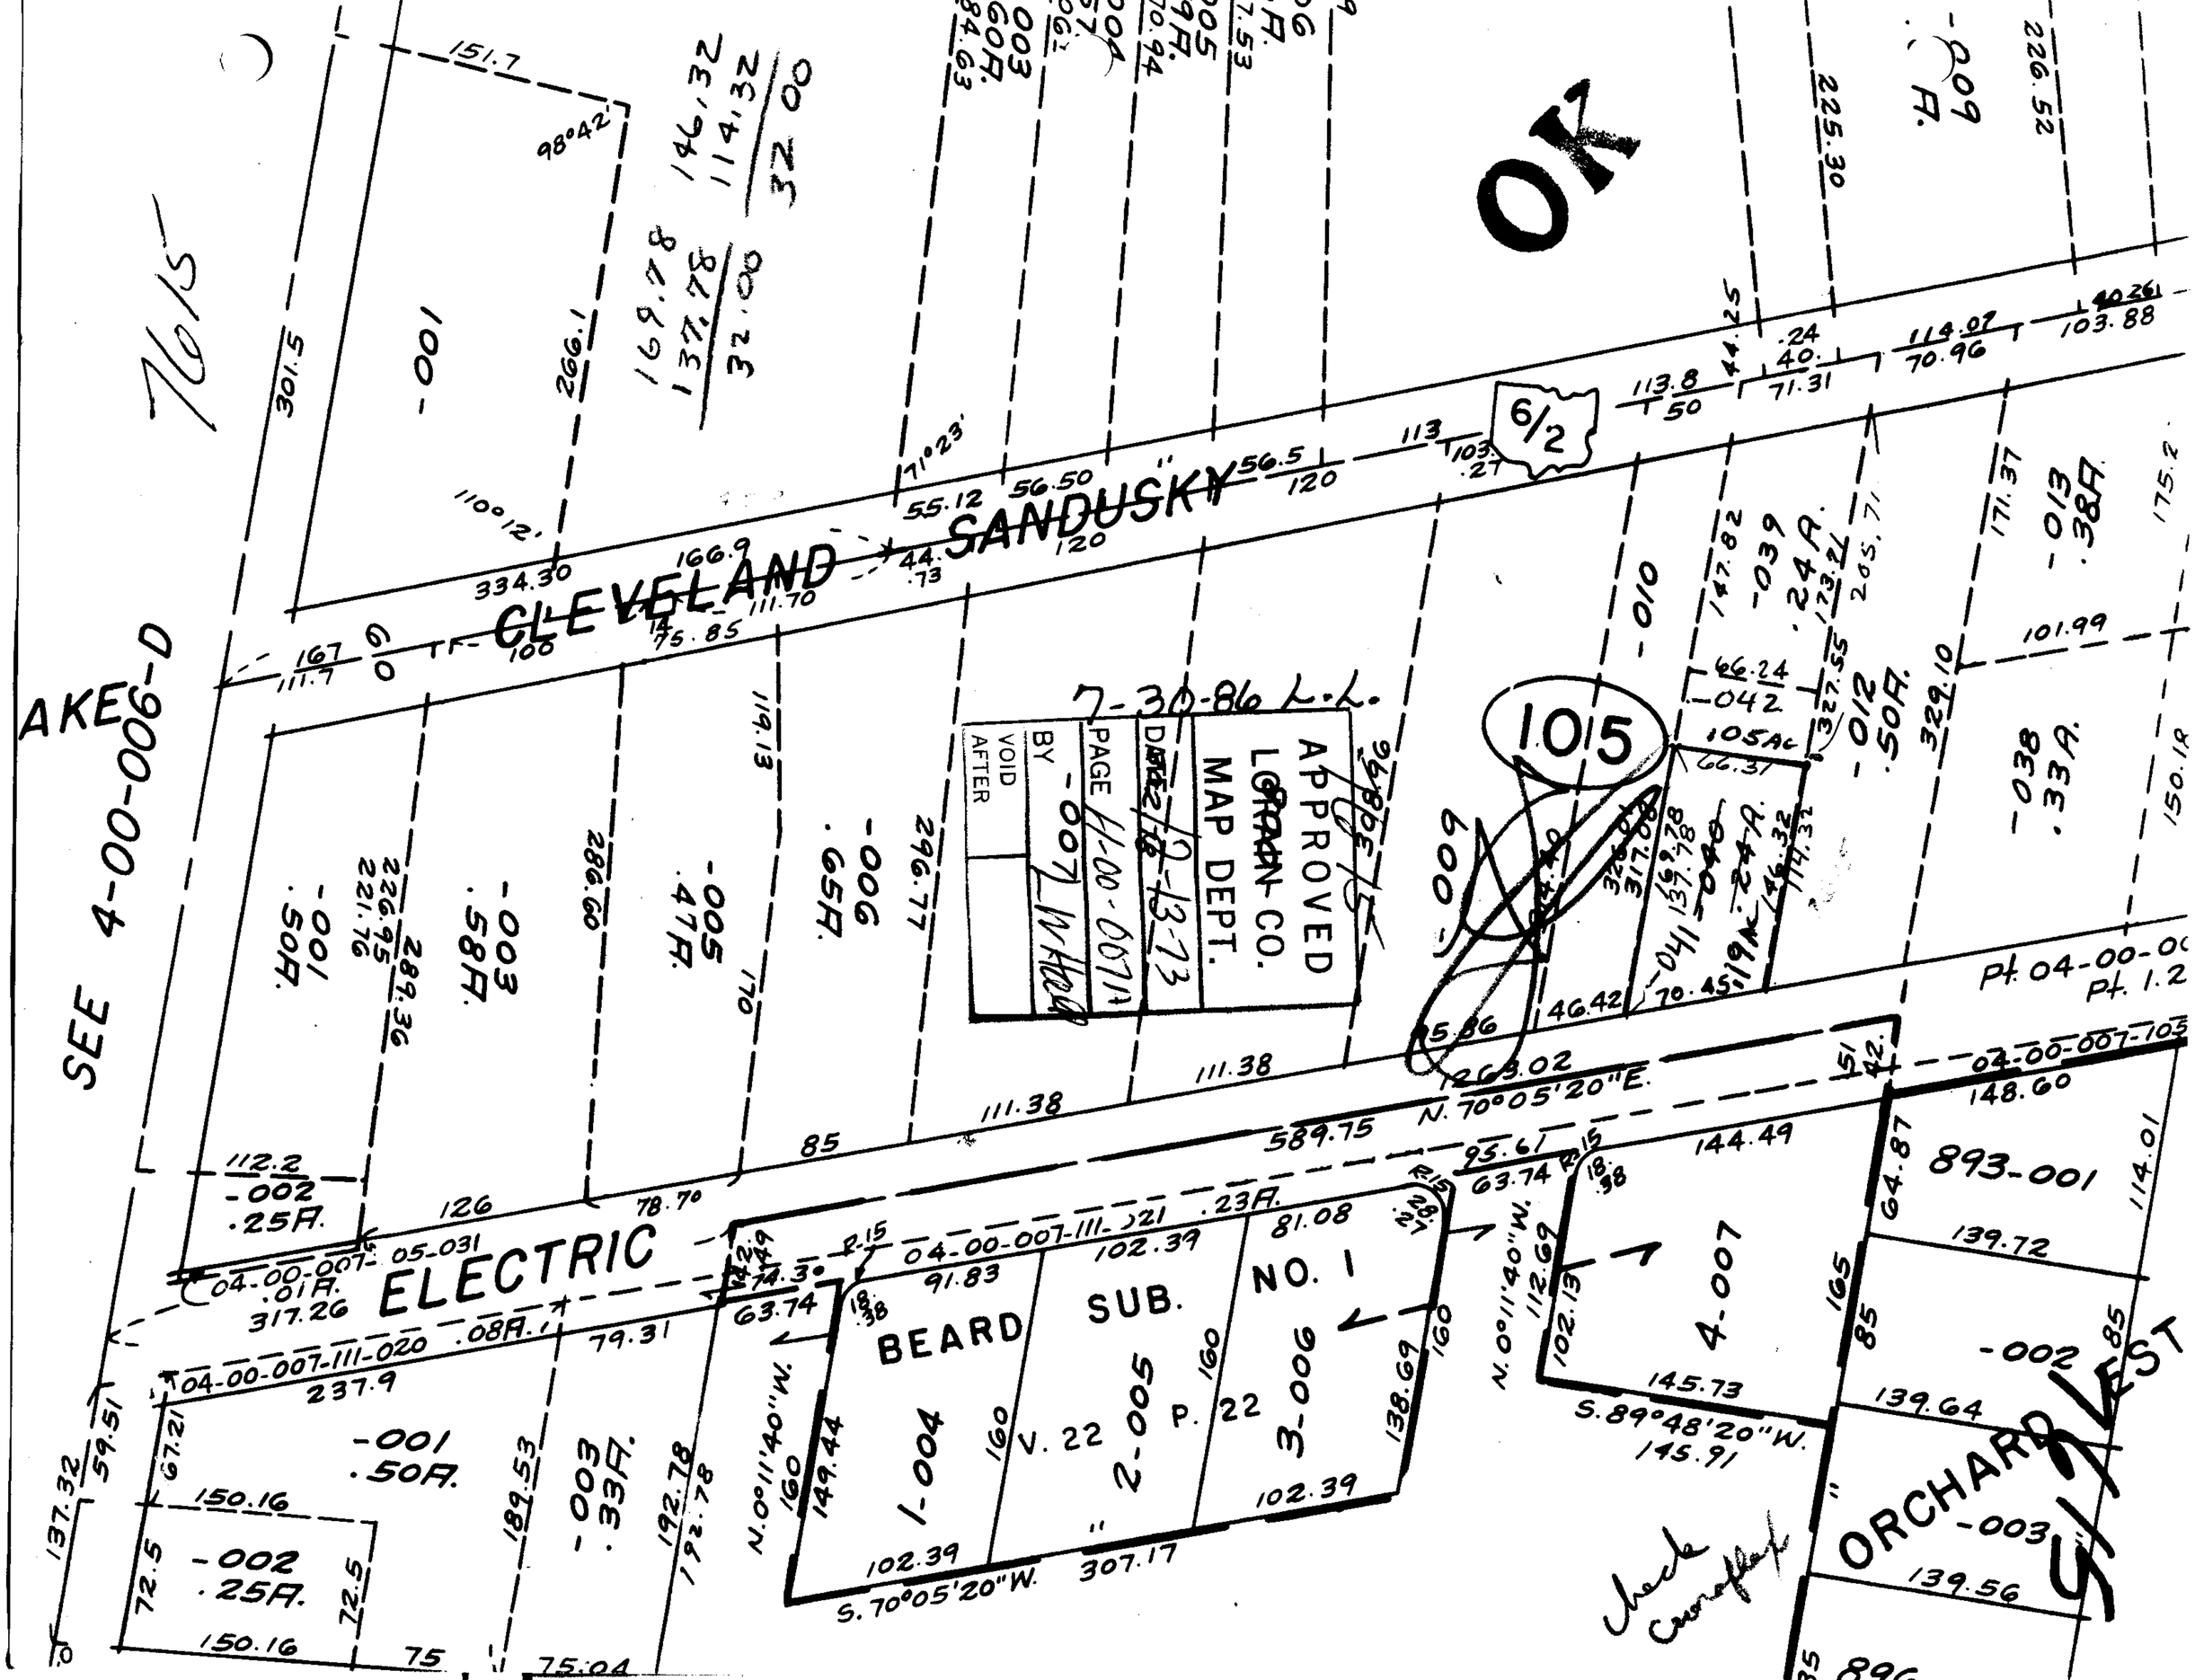

OK
7615
SEE 4-00-006-D
AKE
CLEVELAND SANDUSKY
ELECTRIC
7-30-86 L.L.
APPROVED
LORAIN CO.
MAP DEPT.
DATE 2-13-73
PAGE 4-00-007
BY
VOID AFTER
105
6/2
BEARD SUB. NO. 1
V. 22 P. 22
1-004
2-005
3-006
4-007
893-001
ORCHARD EST
S. 70°05'20"W.
N. 70°05'20"E.
S. 89°48'20"W.
N. 0°11'40"W.
04-00-007-111-021 .23A.
04-00-007-111-020 .08A.
04-00-007-05-031 .01A.
Pt. 04-00-00
Pt. 1.2