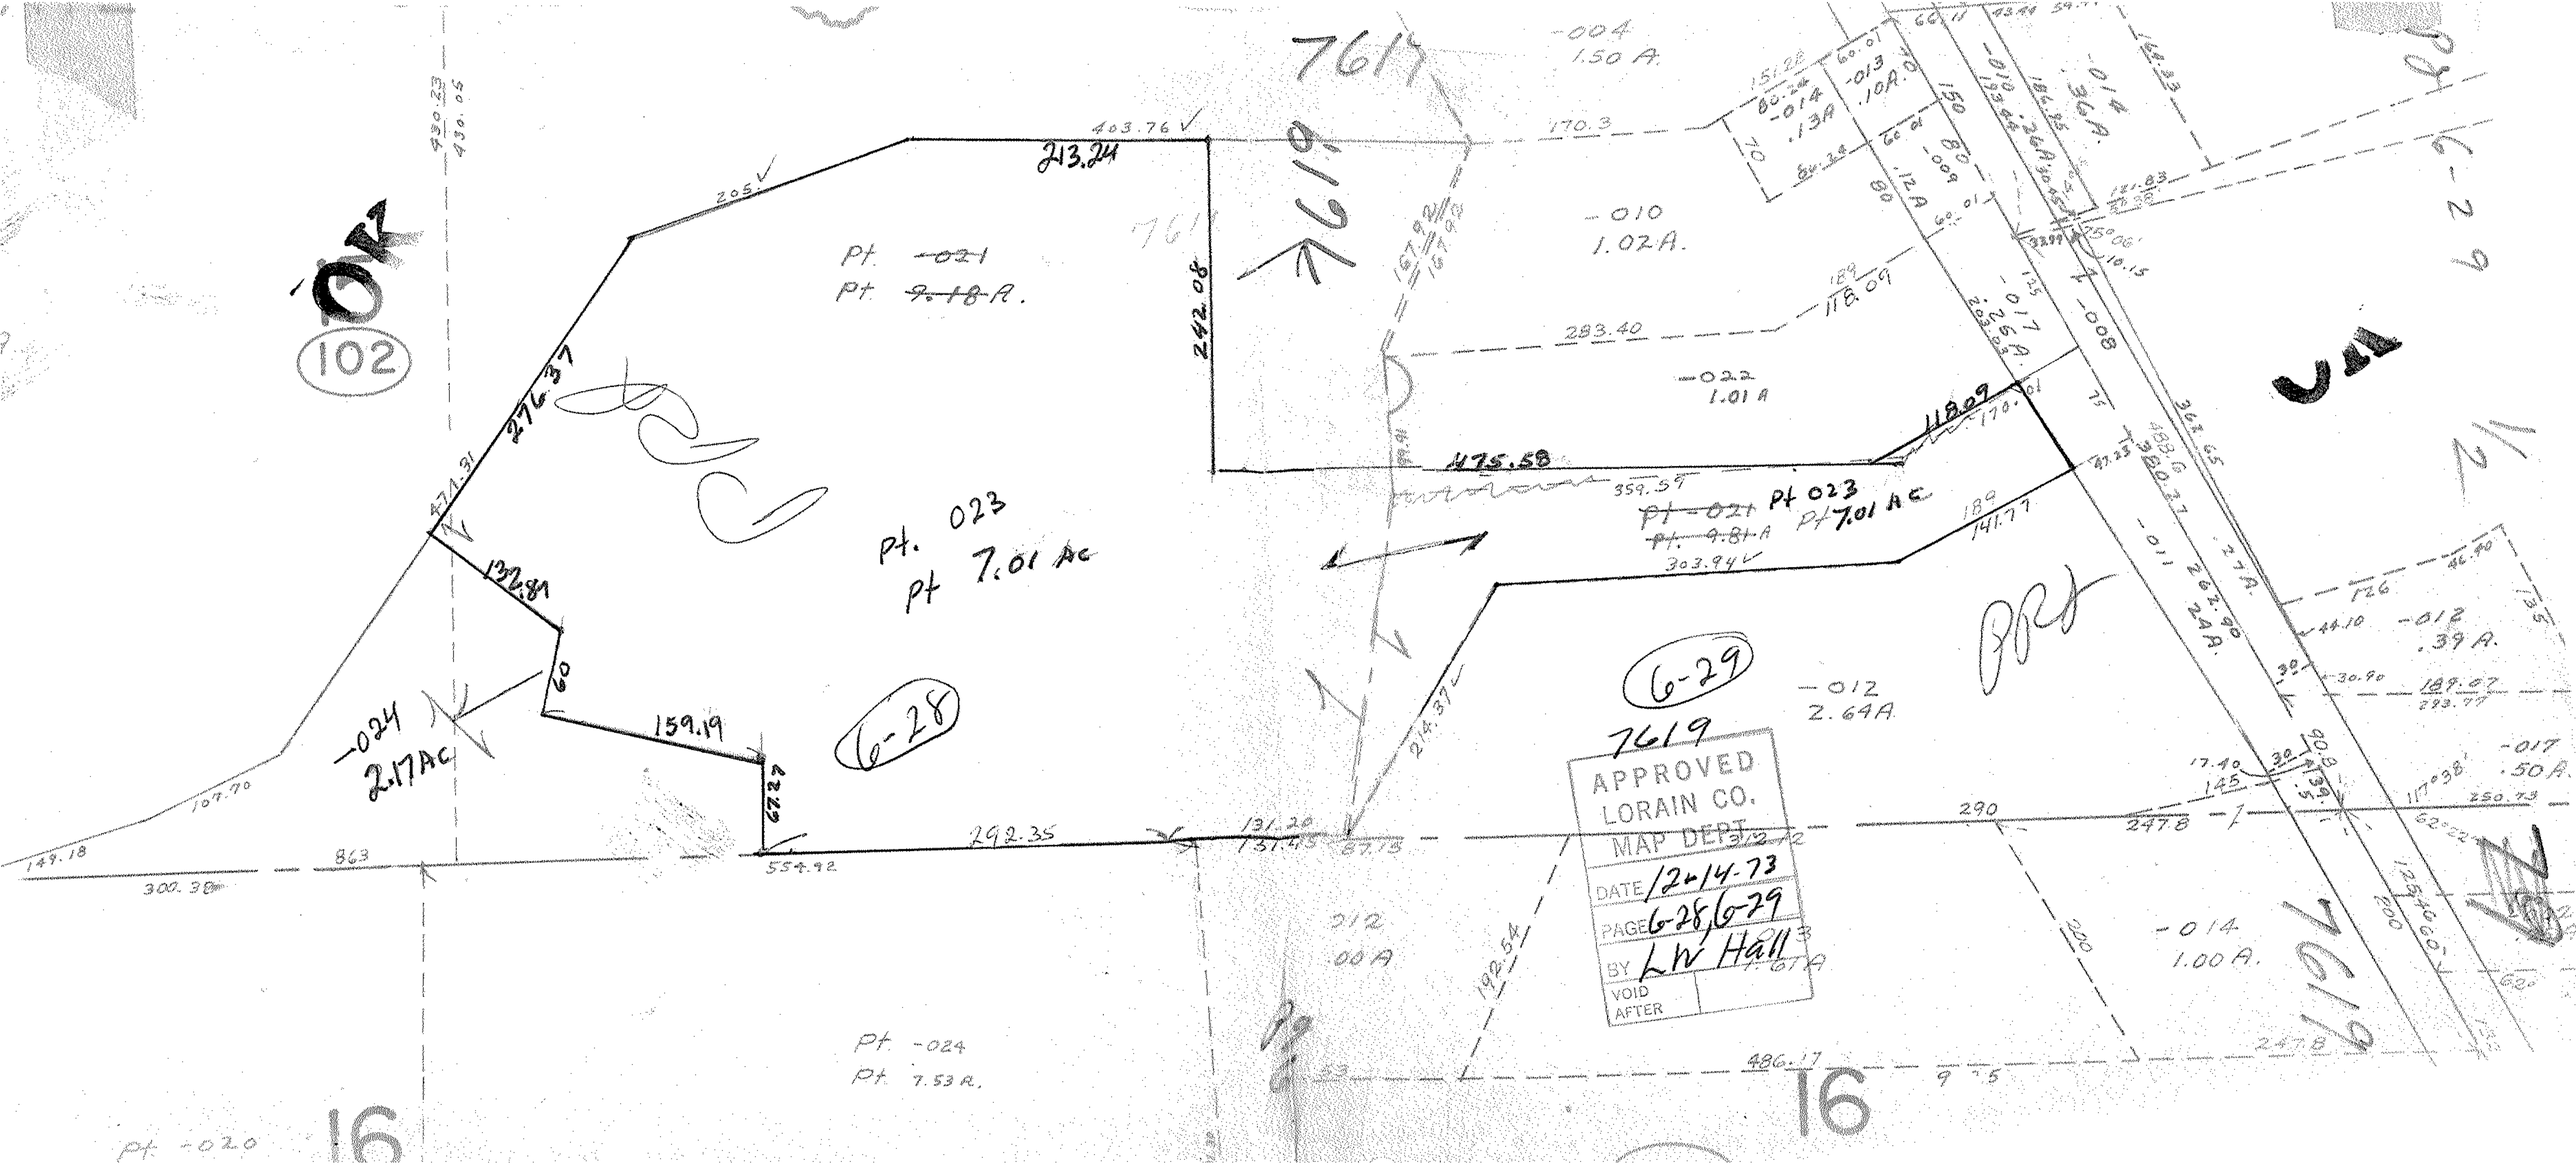

7619
-004
1.50 A.
-010
1.02 A.
-022
1.01 A
-012
2.64 A
-014
1.00 A.
-012
.39 A.
-017
.50 A.
-024
2.17 AC
Pt. -021
Pt. 9.18 A.
Pt. 023
Pt 7.01 AC
Pt -021
Pt. 9.81 A
Pt 023
Pt 7.01 AC
Pt. -024
Pt. 7.53 A.
Pt. -020
213.24
242.08
276.37
132.81
159.19
475.58
118.09
292.35
6-28
6-29
102
16
APPROVED
LORAIN CO.
MAP DEPT.
DATE 12-14-73
PAGE 6-28, 6-29
BY LW Hall
VOID
AFTER