


SEE 10-0

State of Ohio 10-16-70

7621

7621

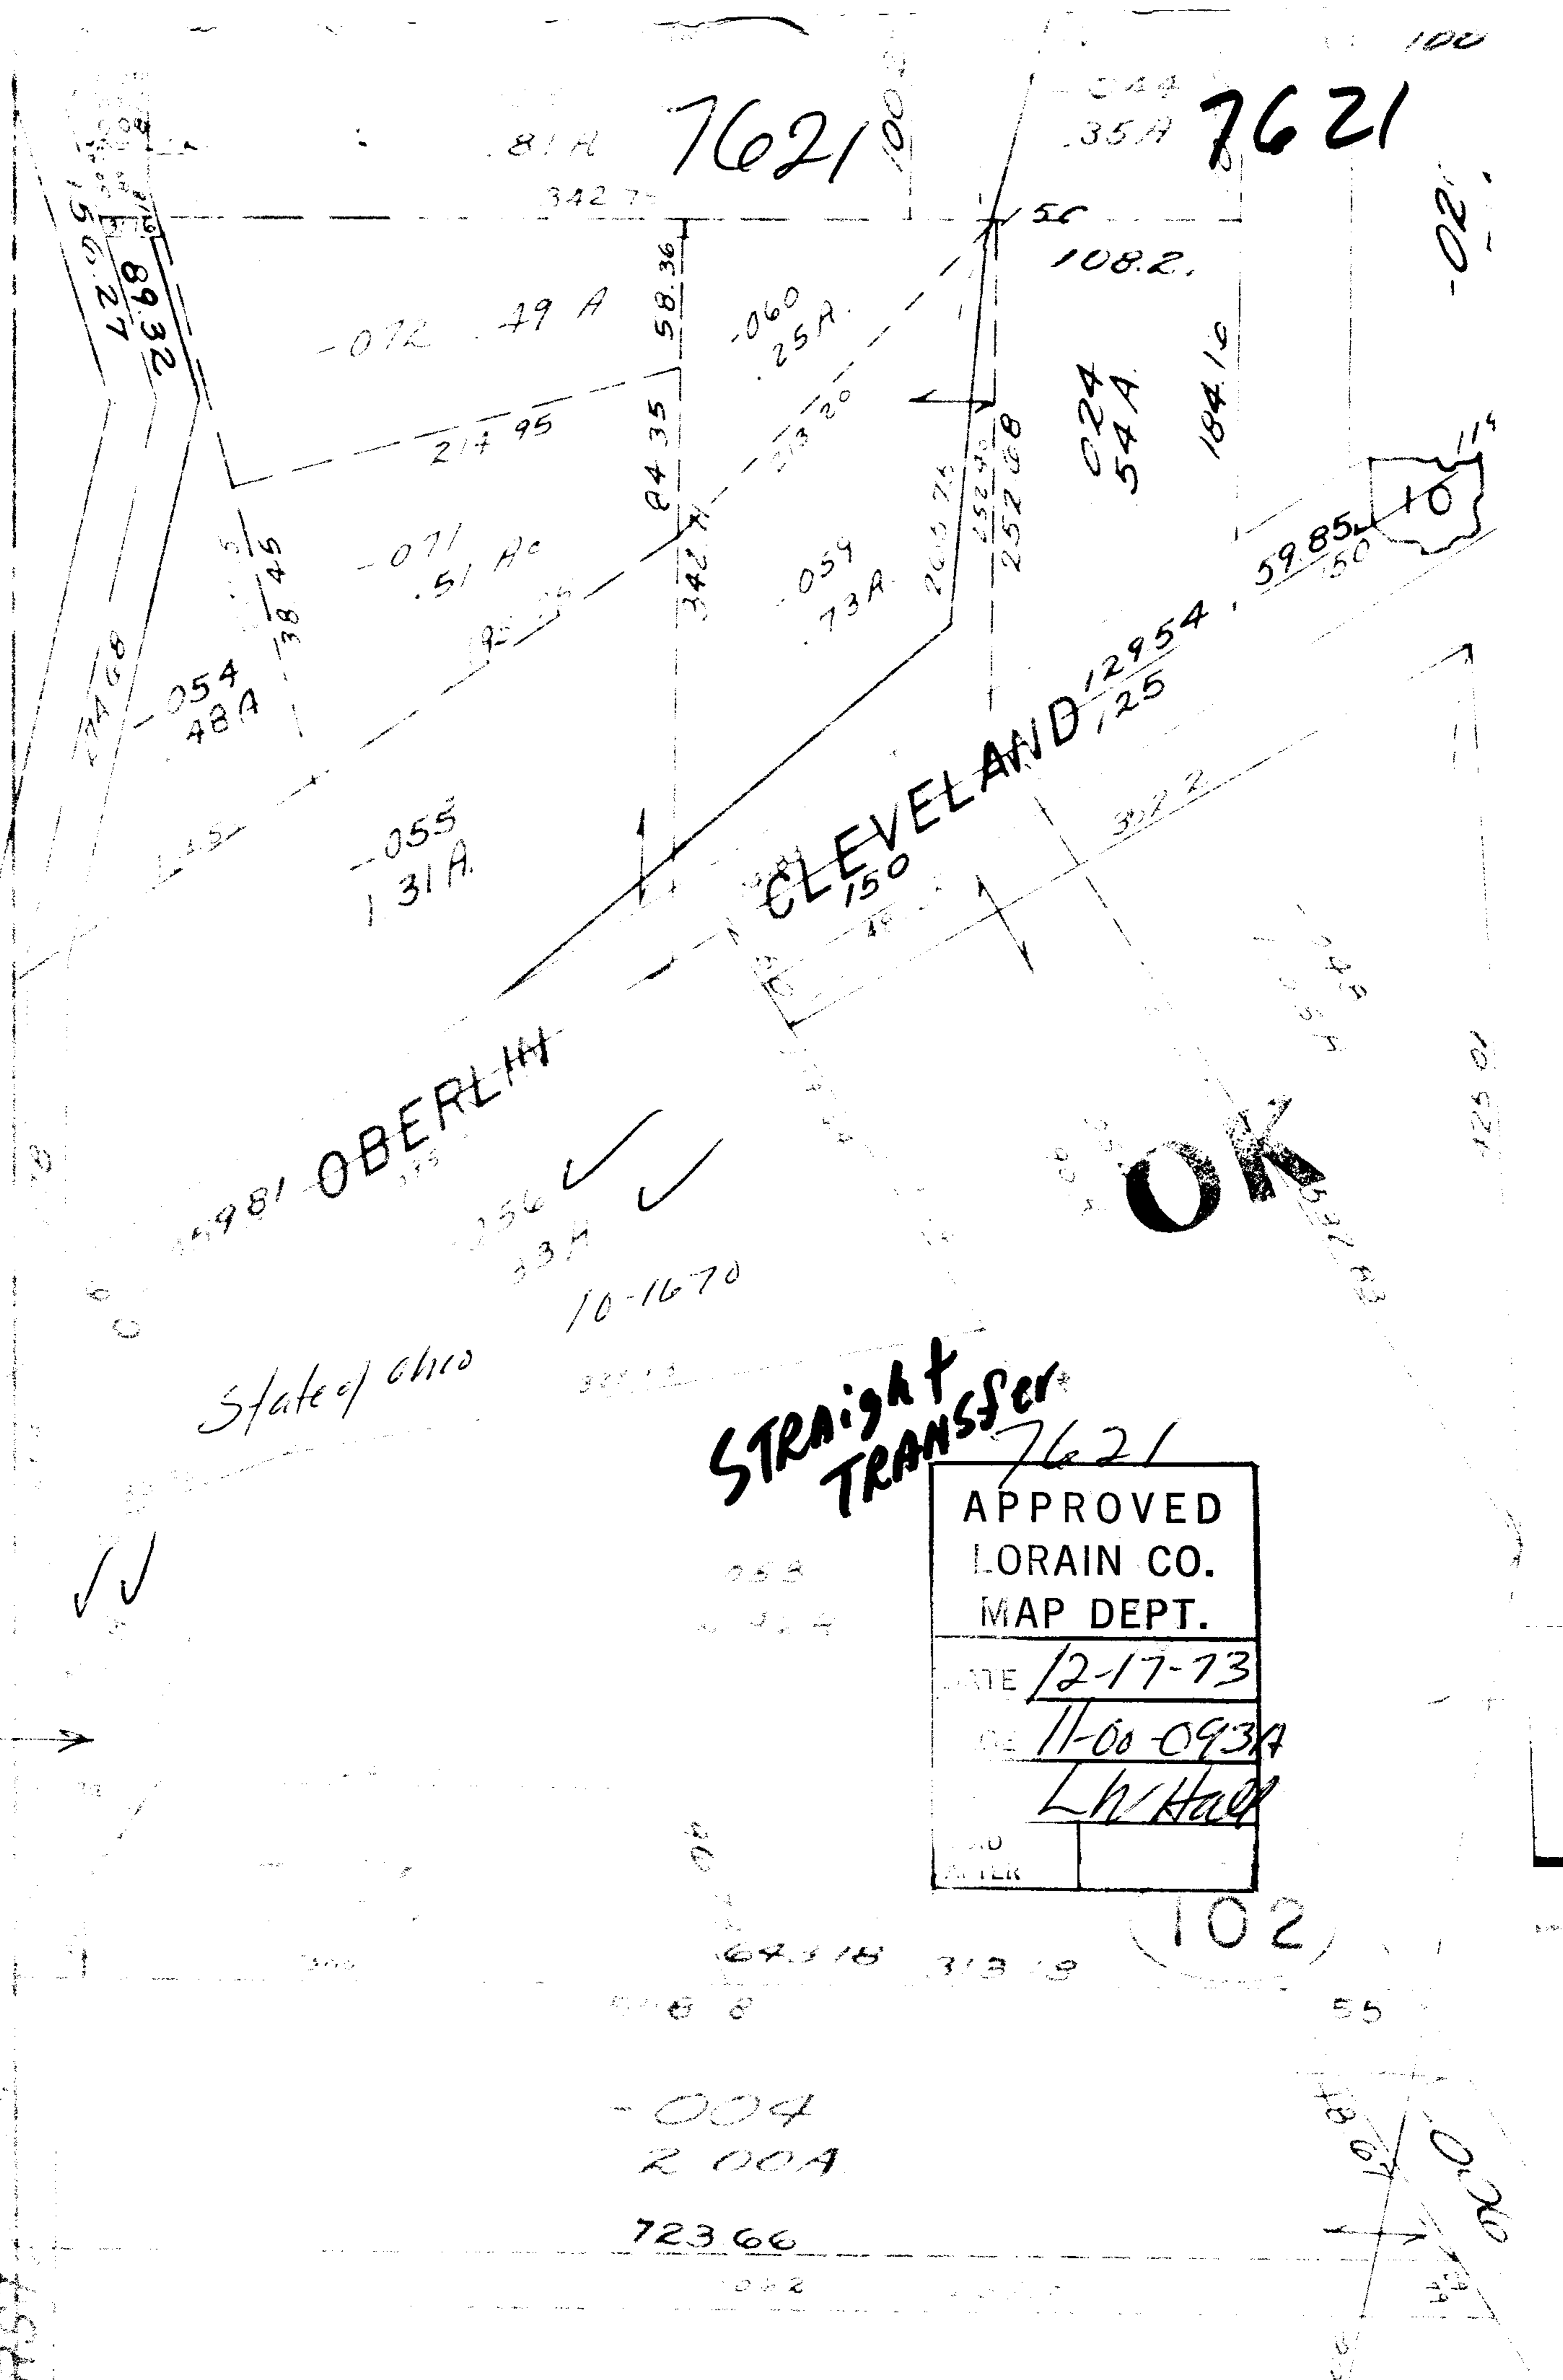

OBERLIN

CLEVELAND

OK

APPROVED  
 LORAIN CO.  
 MAP DEPT.  
 DATE 12-17-73  
 BY 11-00-093A  
 LW Hall

STRAIGHT TRANSFER

004  
200A  
723 66

102