

See Also 4I ↑

7624


7624
APPROVED LORAIN CO. MAP DEPT.
DATE 2-18-73
PAGE 4-00-002H
BY L. W. Hall
VOID AFTER

7-30-86 L.L.L.

4 HI

Pt. -024
Pt. 35.0A.

4-00-002H

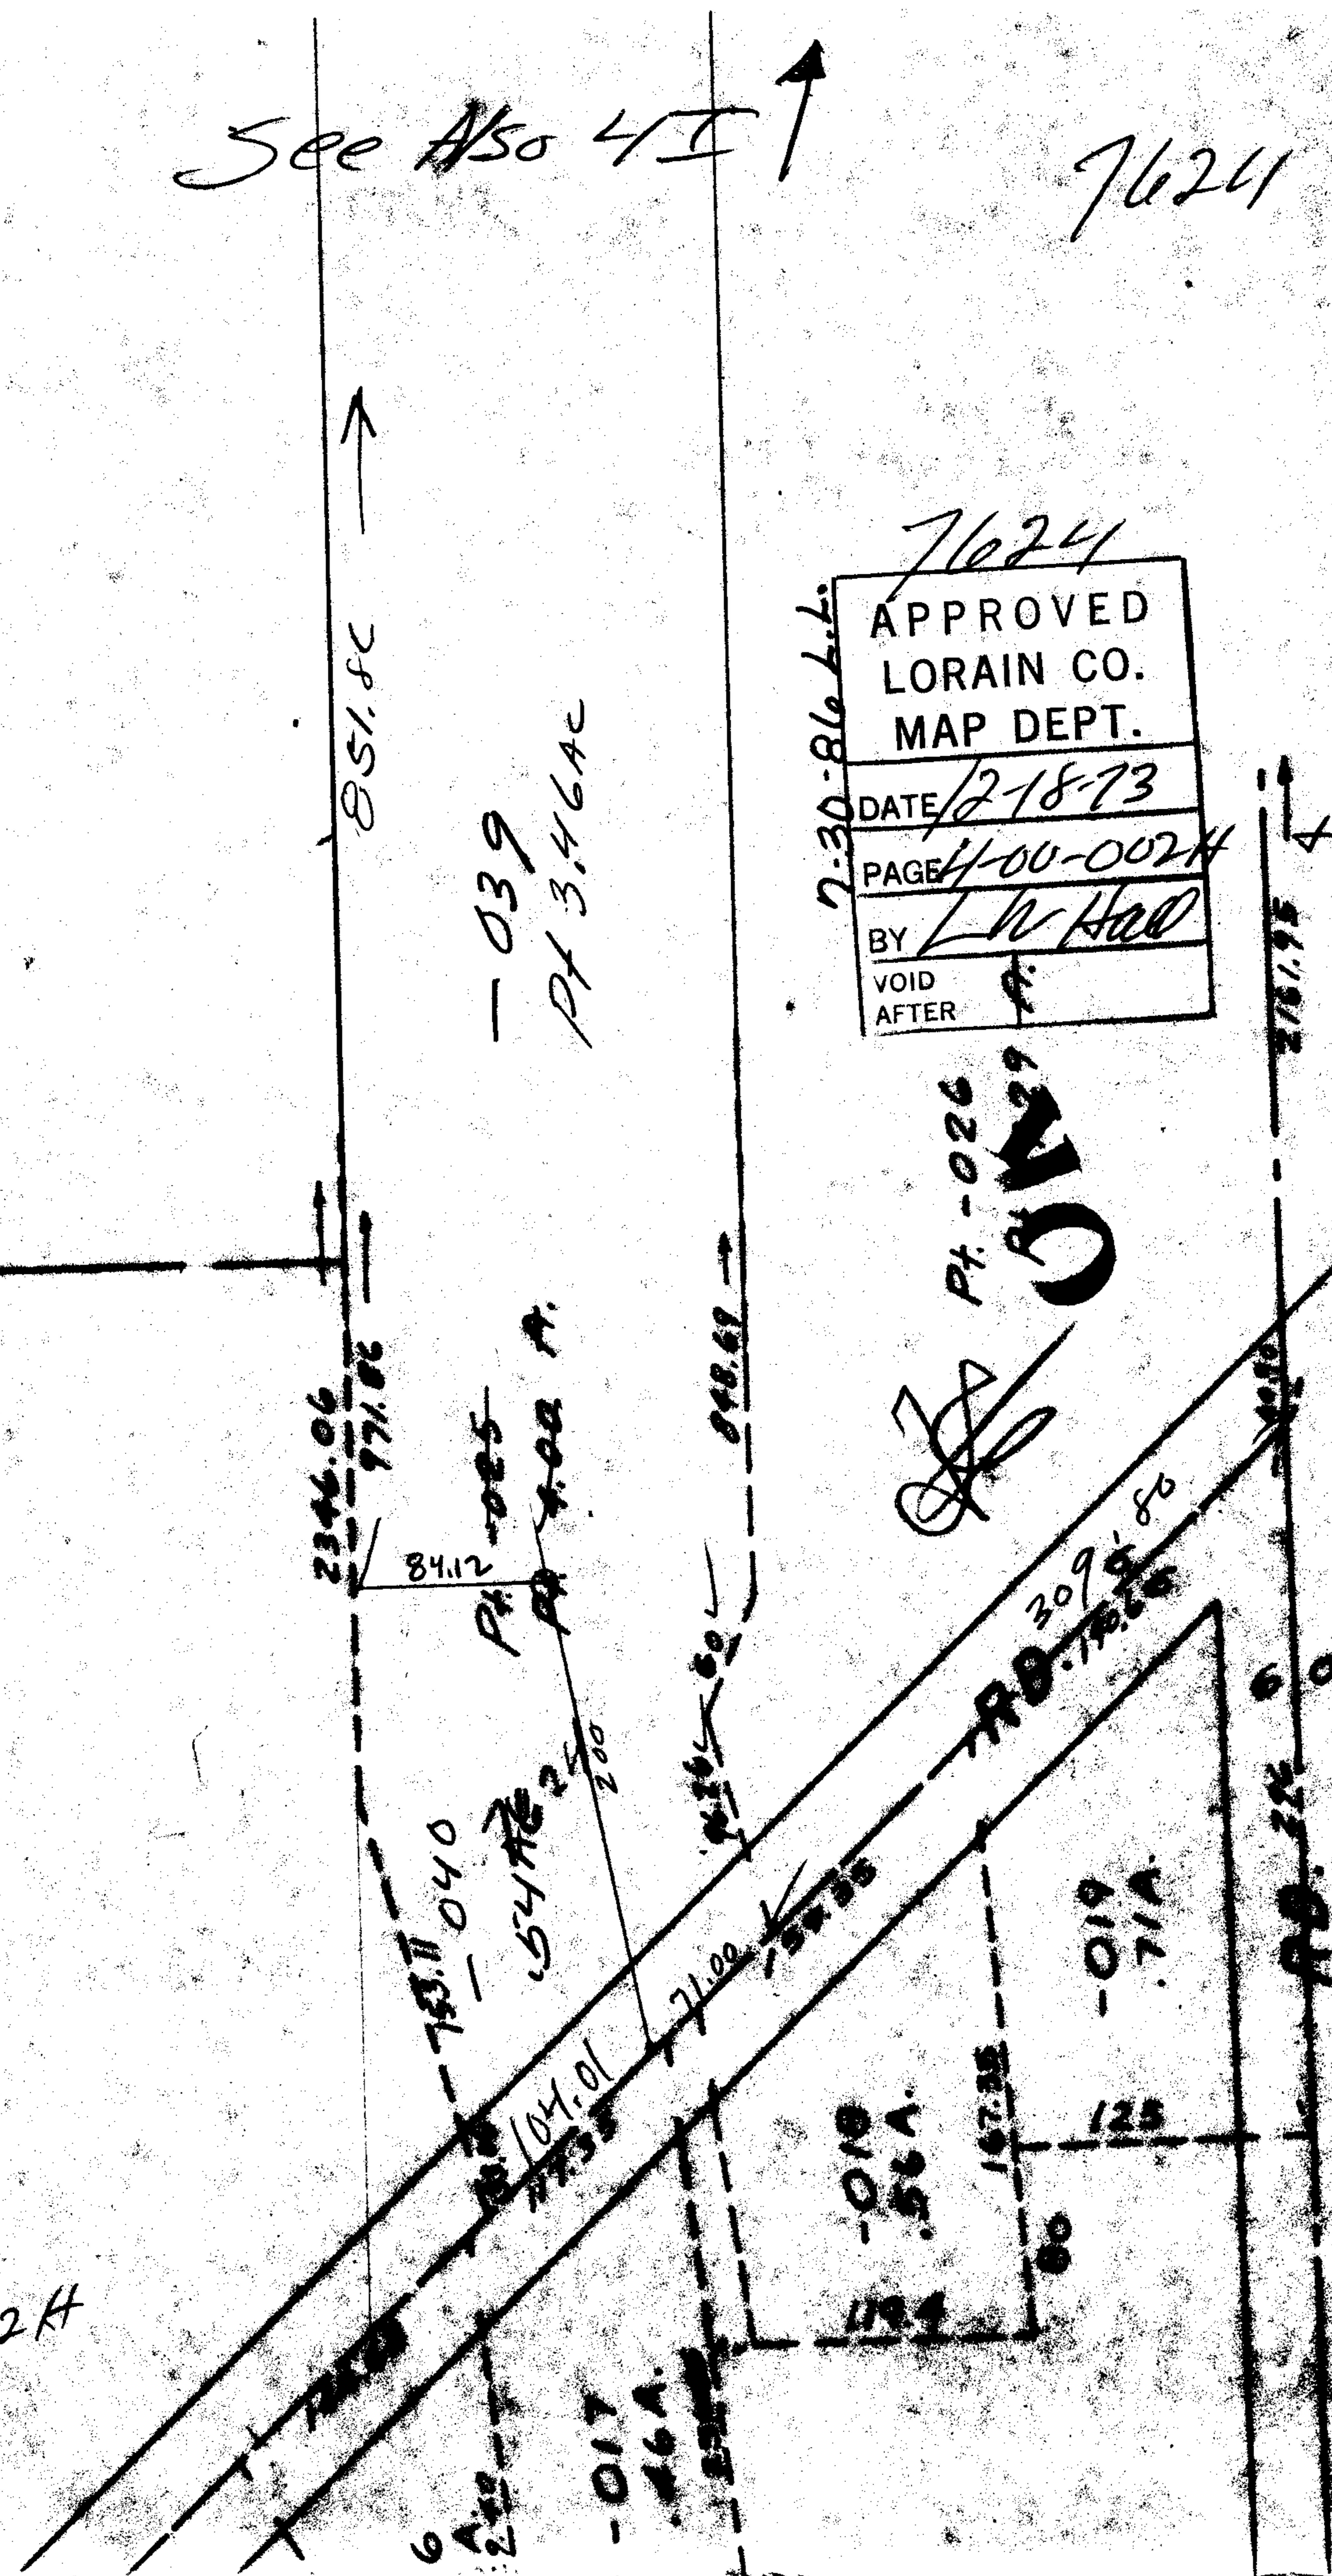

Pt. -026
J. W. Hall