

7628

COOPER FOSTER

254 211.39


-016
.92A.

10

101

PRD

Pt. -018
Pt. 10.89 A.

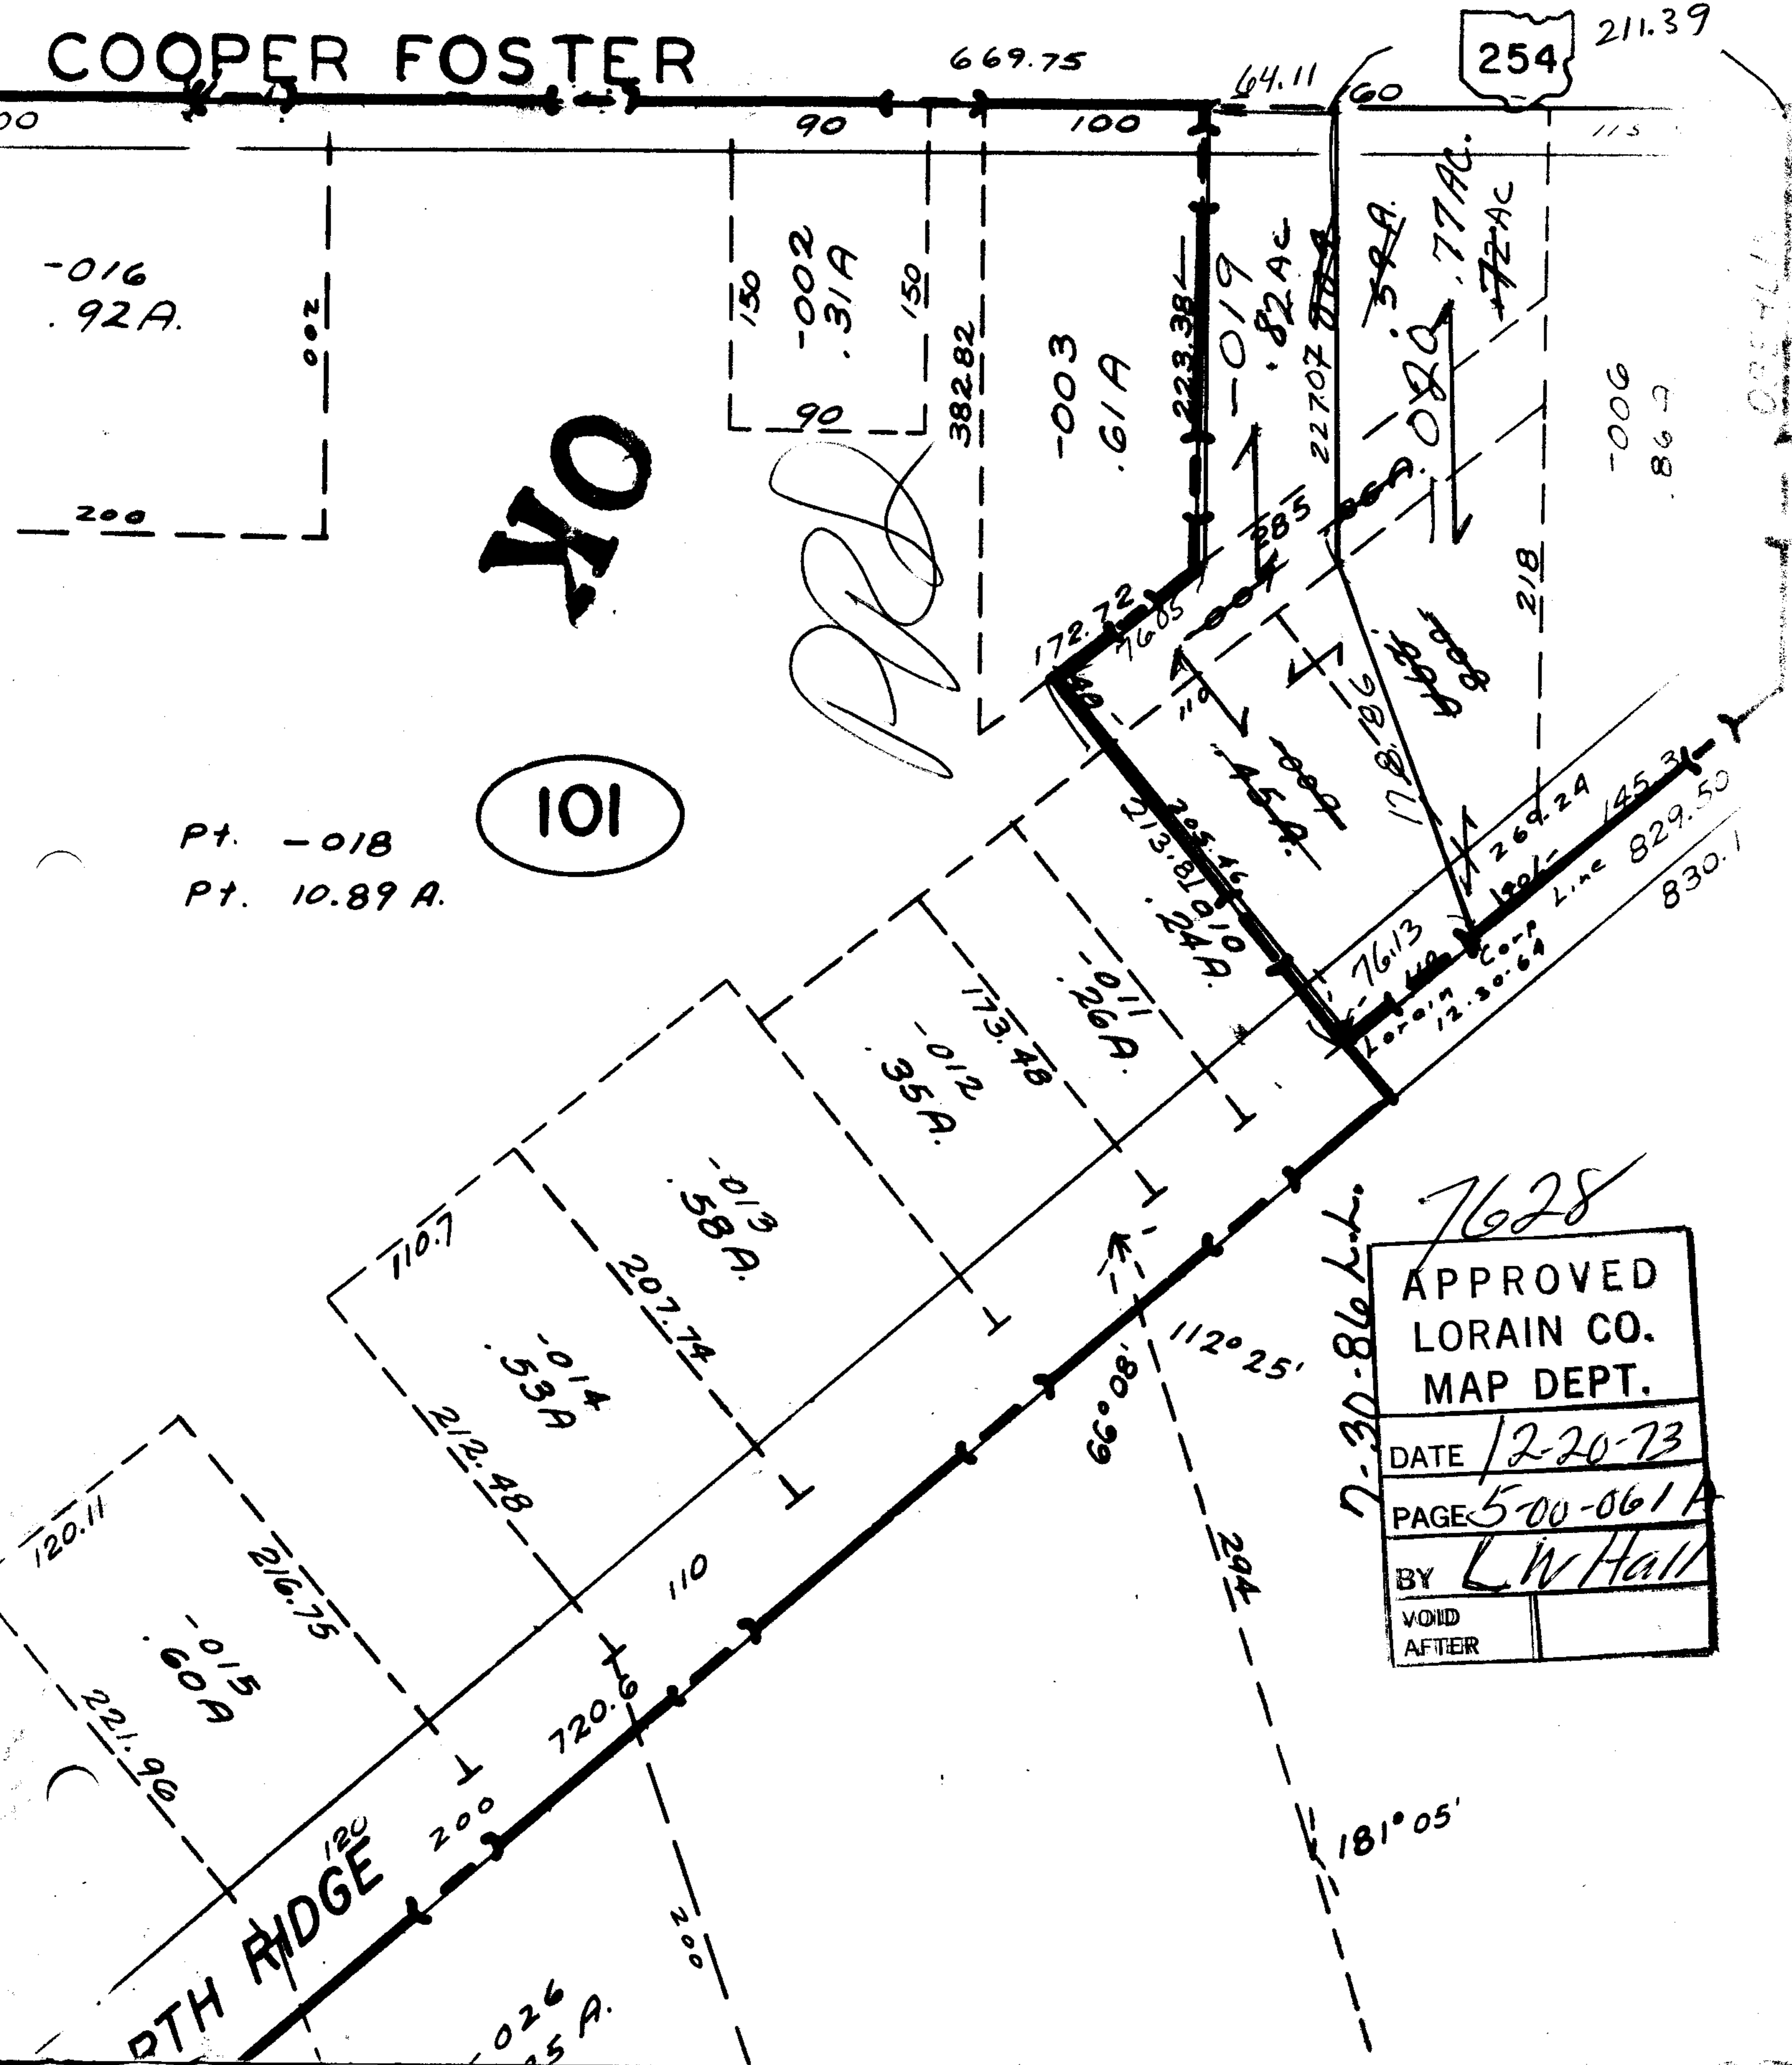

7628

APPROVED
LORAIN CO.
MAP DEPT.

DATE 12-20-73

PAGE 500-061A

BY L.W. Hall

VOID
AFTER

7-30-86

181°05'