


7629

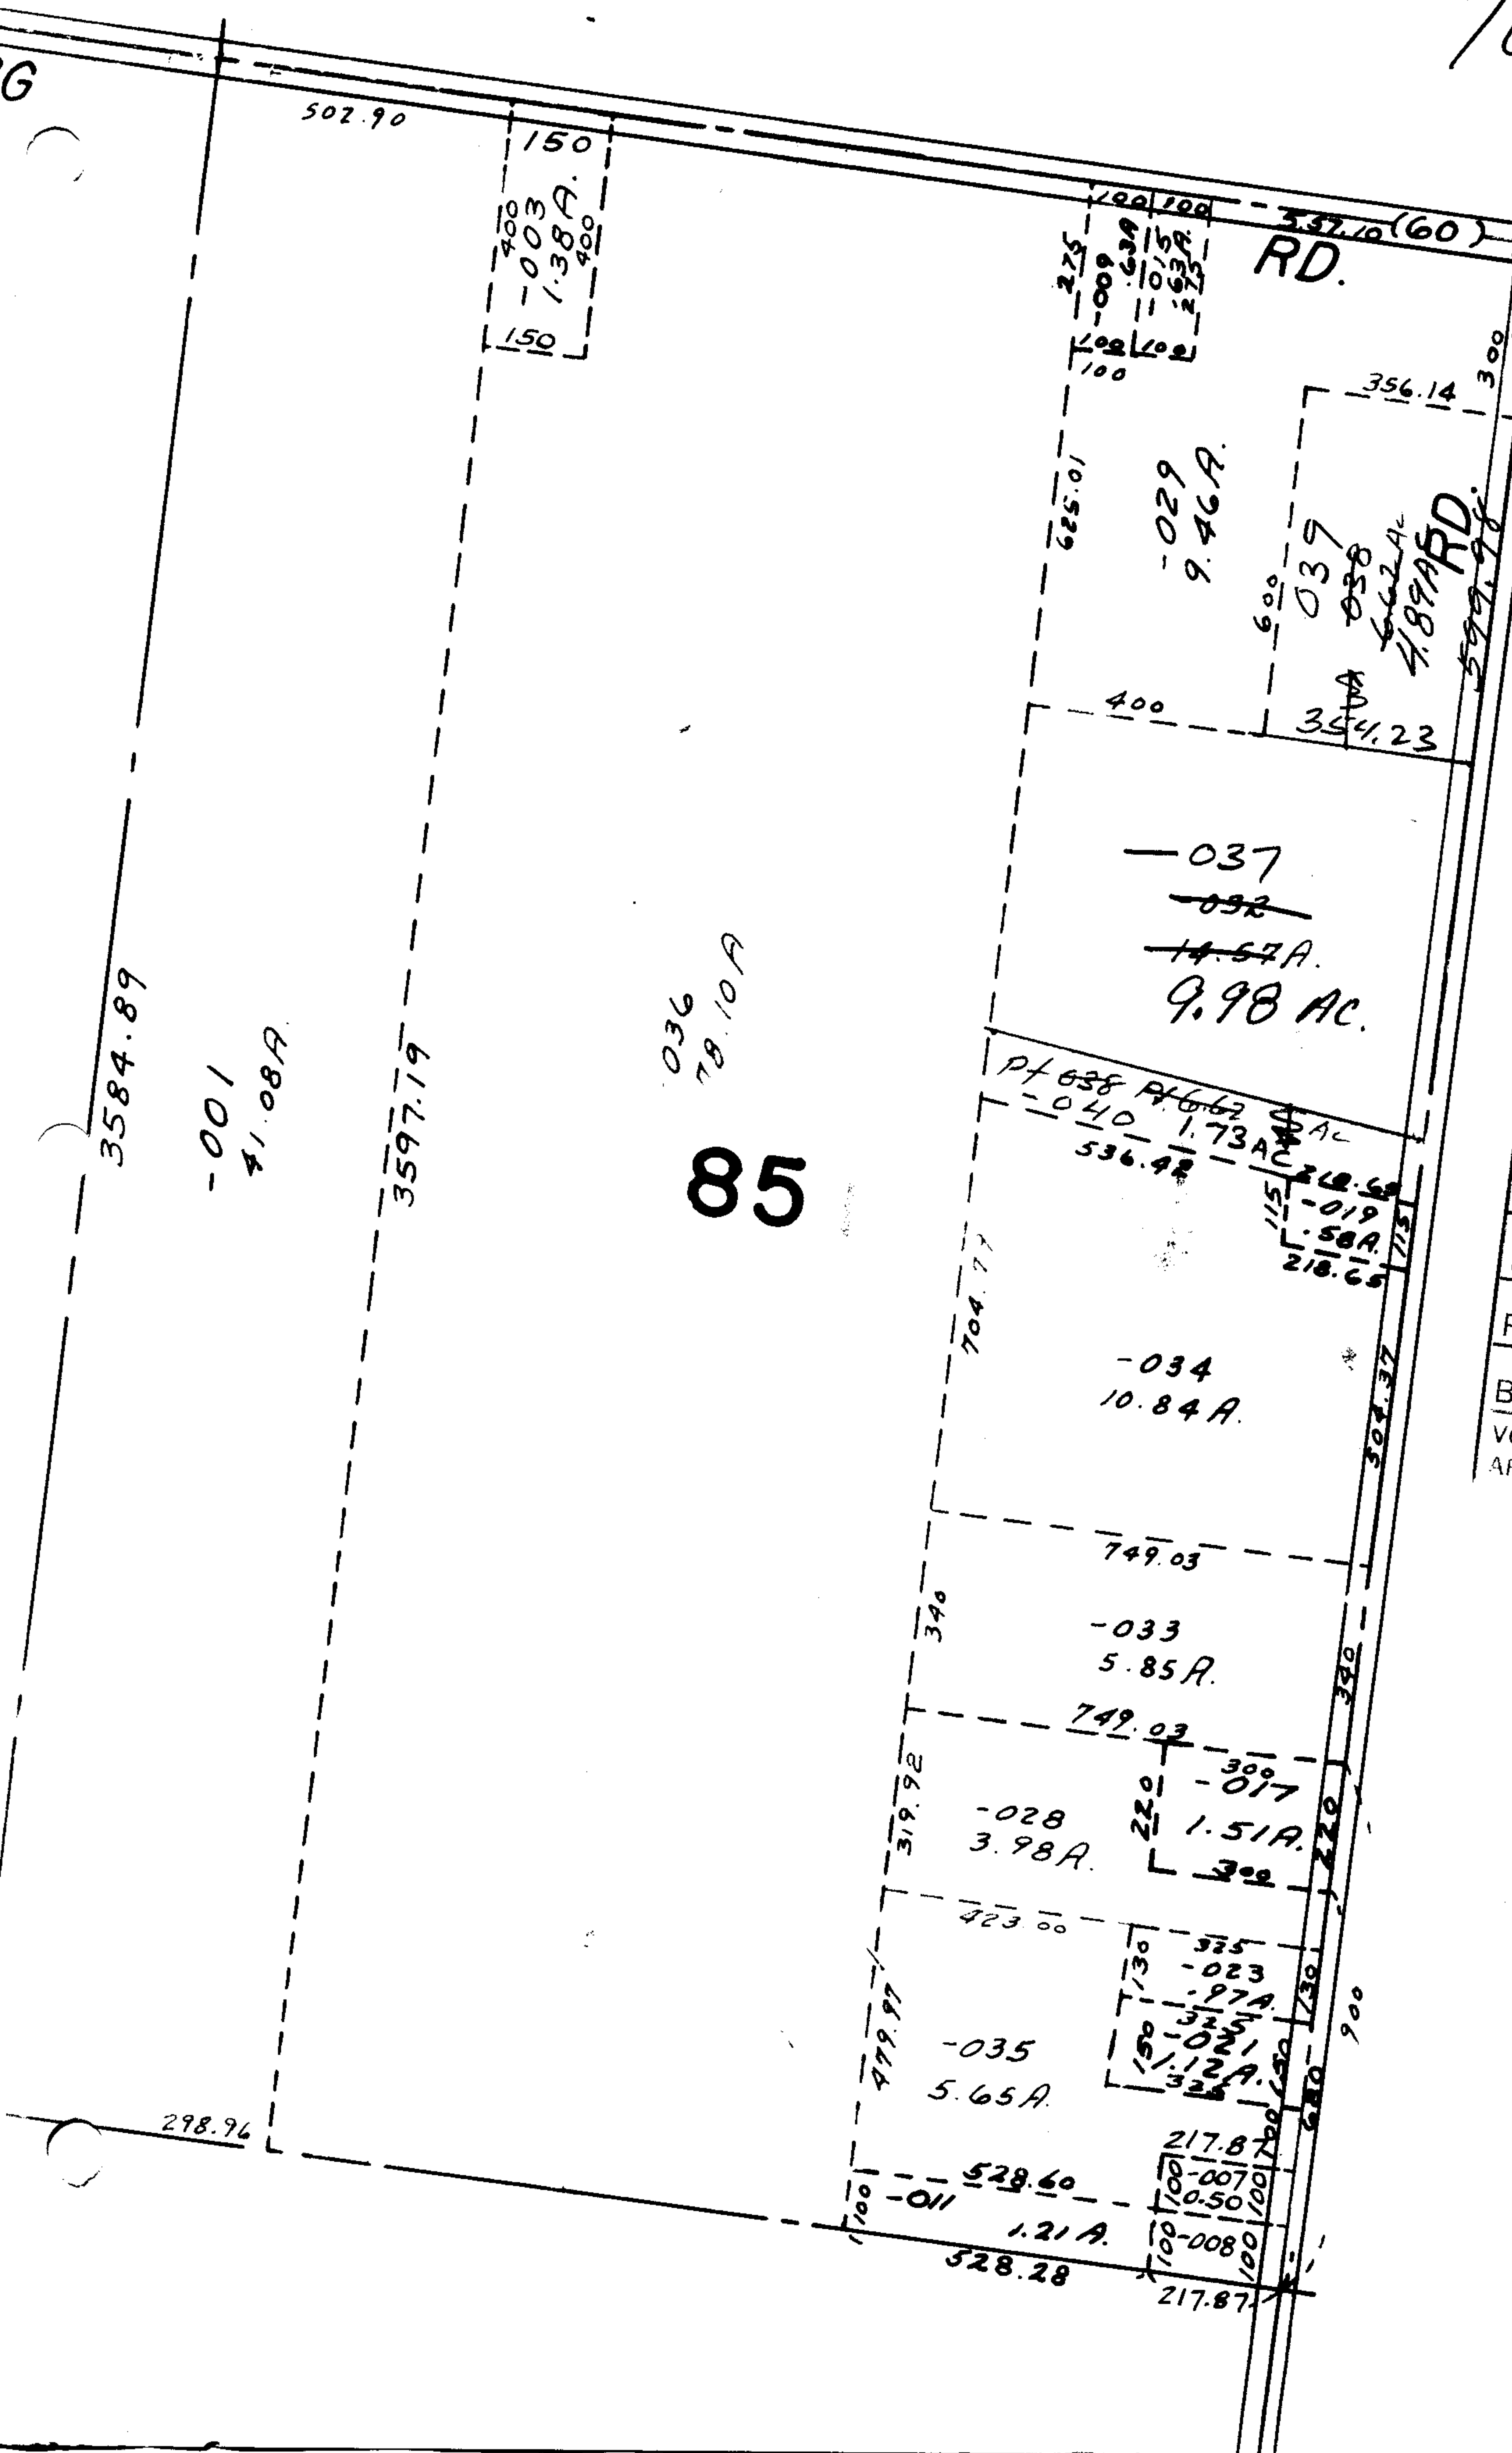

82

85

7629

APPROVED  
LORAIN CO.  
MAP DEPT.

DATE 12-20-73

PAGE 1/E North Pl

BY L W Hall

VOID  
AFTER

8/13/86

OK