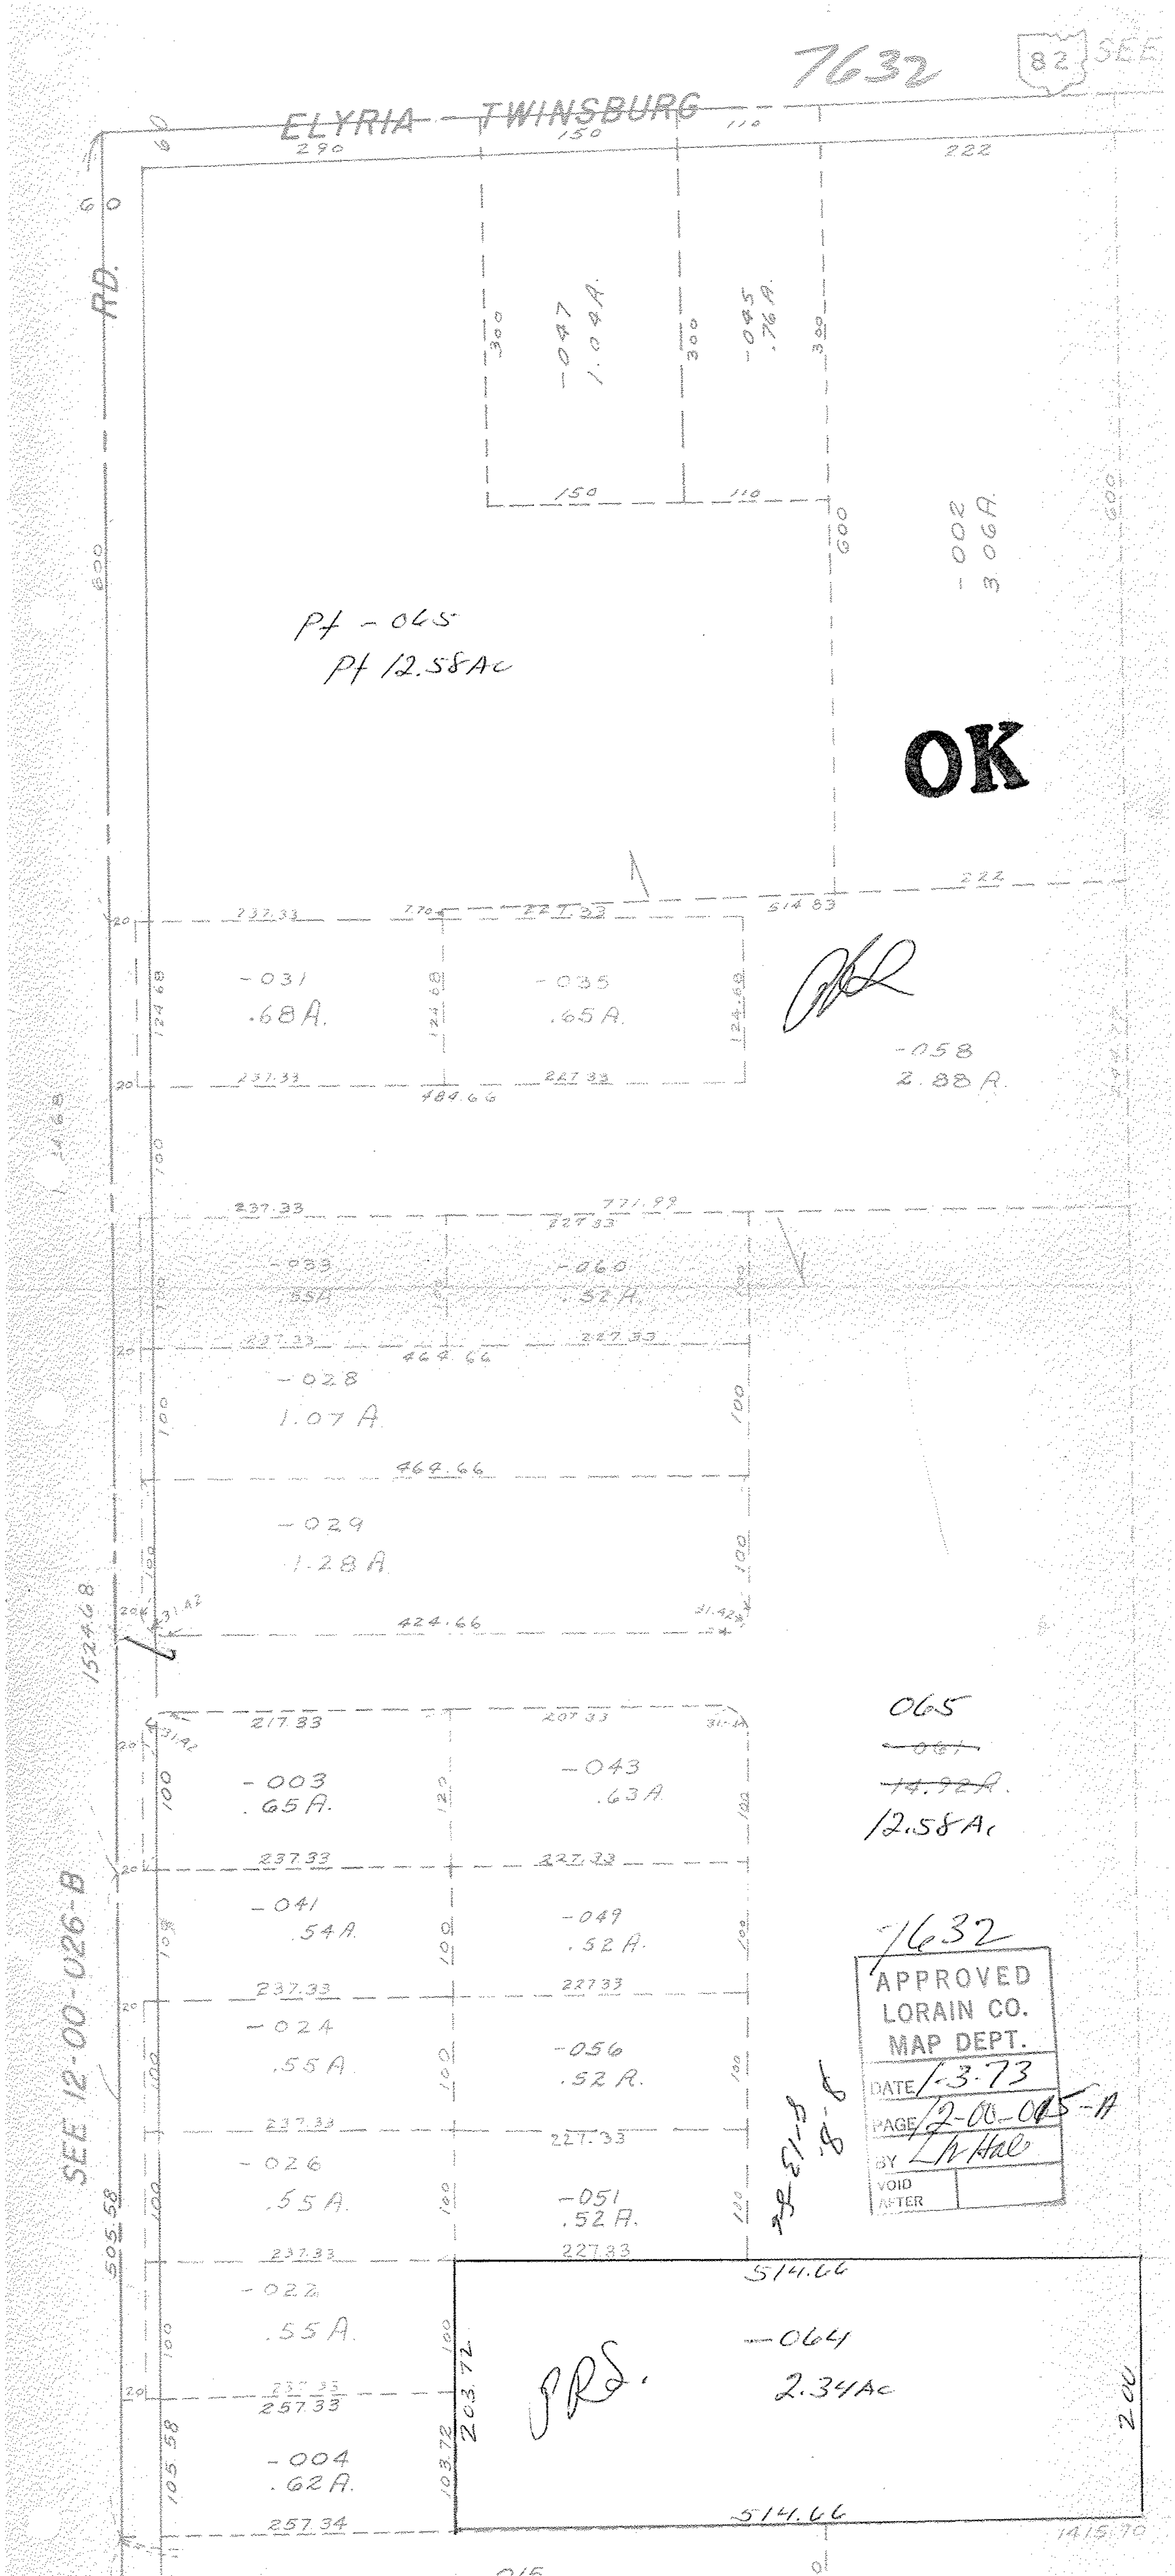
7632
82
SEE
ELYRIA - TWINSBURG
RD.
-047
1.04A.
-045
.76A.
-002
3.06A.
Pt -065
Pt 12.58Ac
OK
-031
.68A.
-035
.65A.
-058
2.88A.
-033
.55A.
-060
.52A.
-028
1.07A.
-029
1.28A.
065
~~-061~~
~~14.92A.~~
12.58Ac
-003
.65A.
-043
.63A.
-041
.54A.
-049
.52A.
-024
.55A.
-056
.52A.
-026
.55A.
-051
.52A.
-022
.55A.
-064
2.34Ac
-004
.62A.
7632
APPROVED
LORAIN CO.
MAP DEPT.
DATE 1-3-73
PAGE 12-00-015-A
BY
VOID
AFTER
SEE 12-00-026-B
514.66
514.66
203.72
103.72
105.58
505.58
1524.68
1415.70