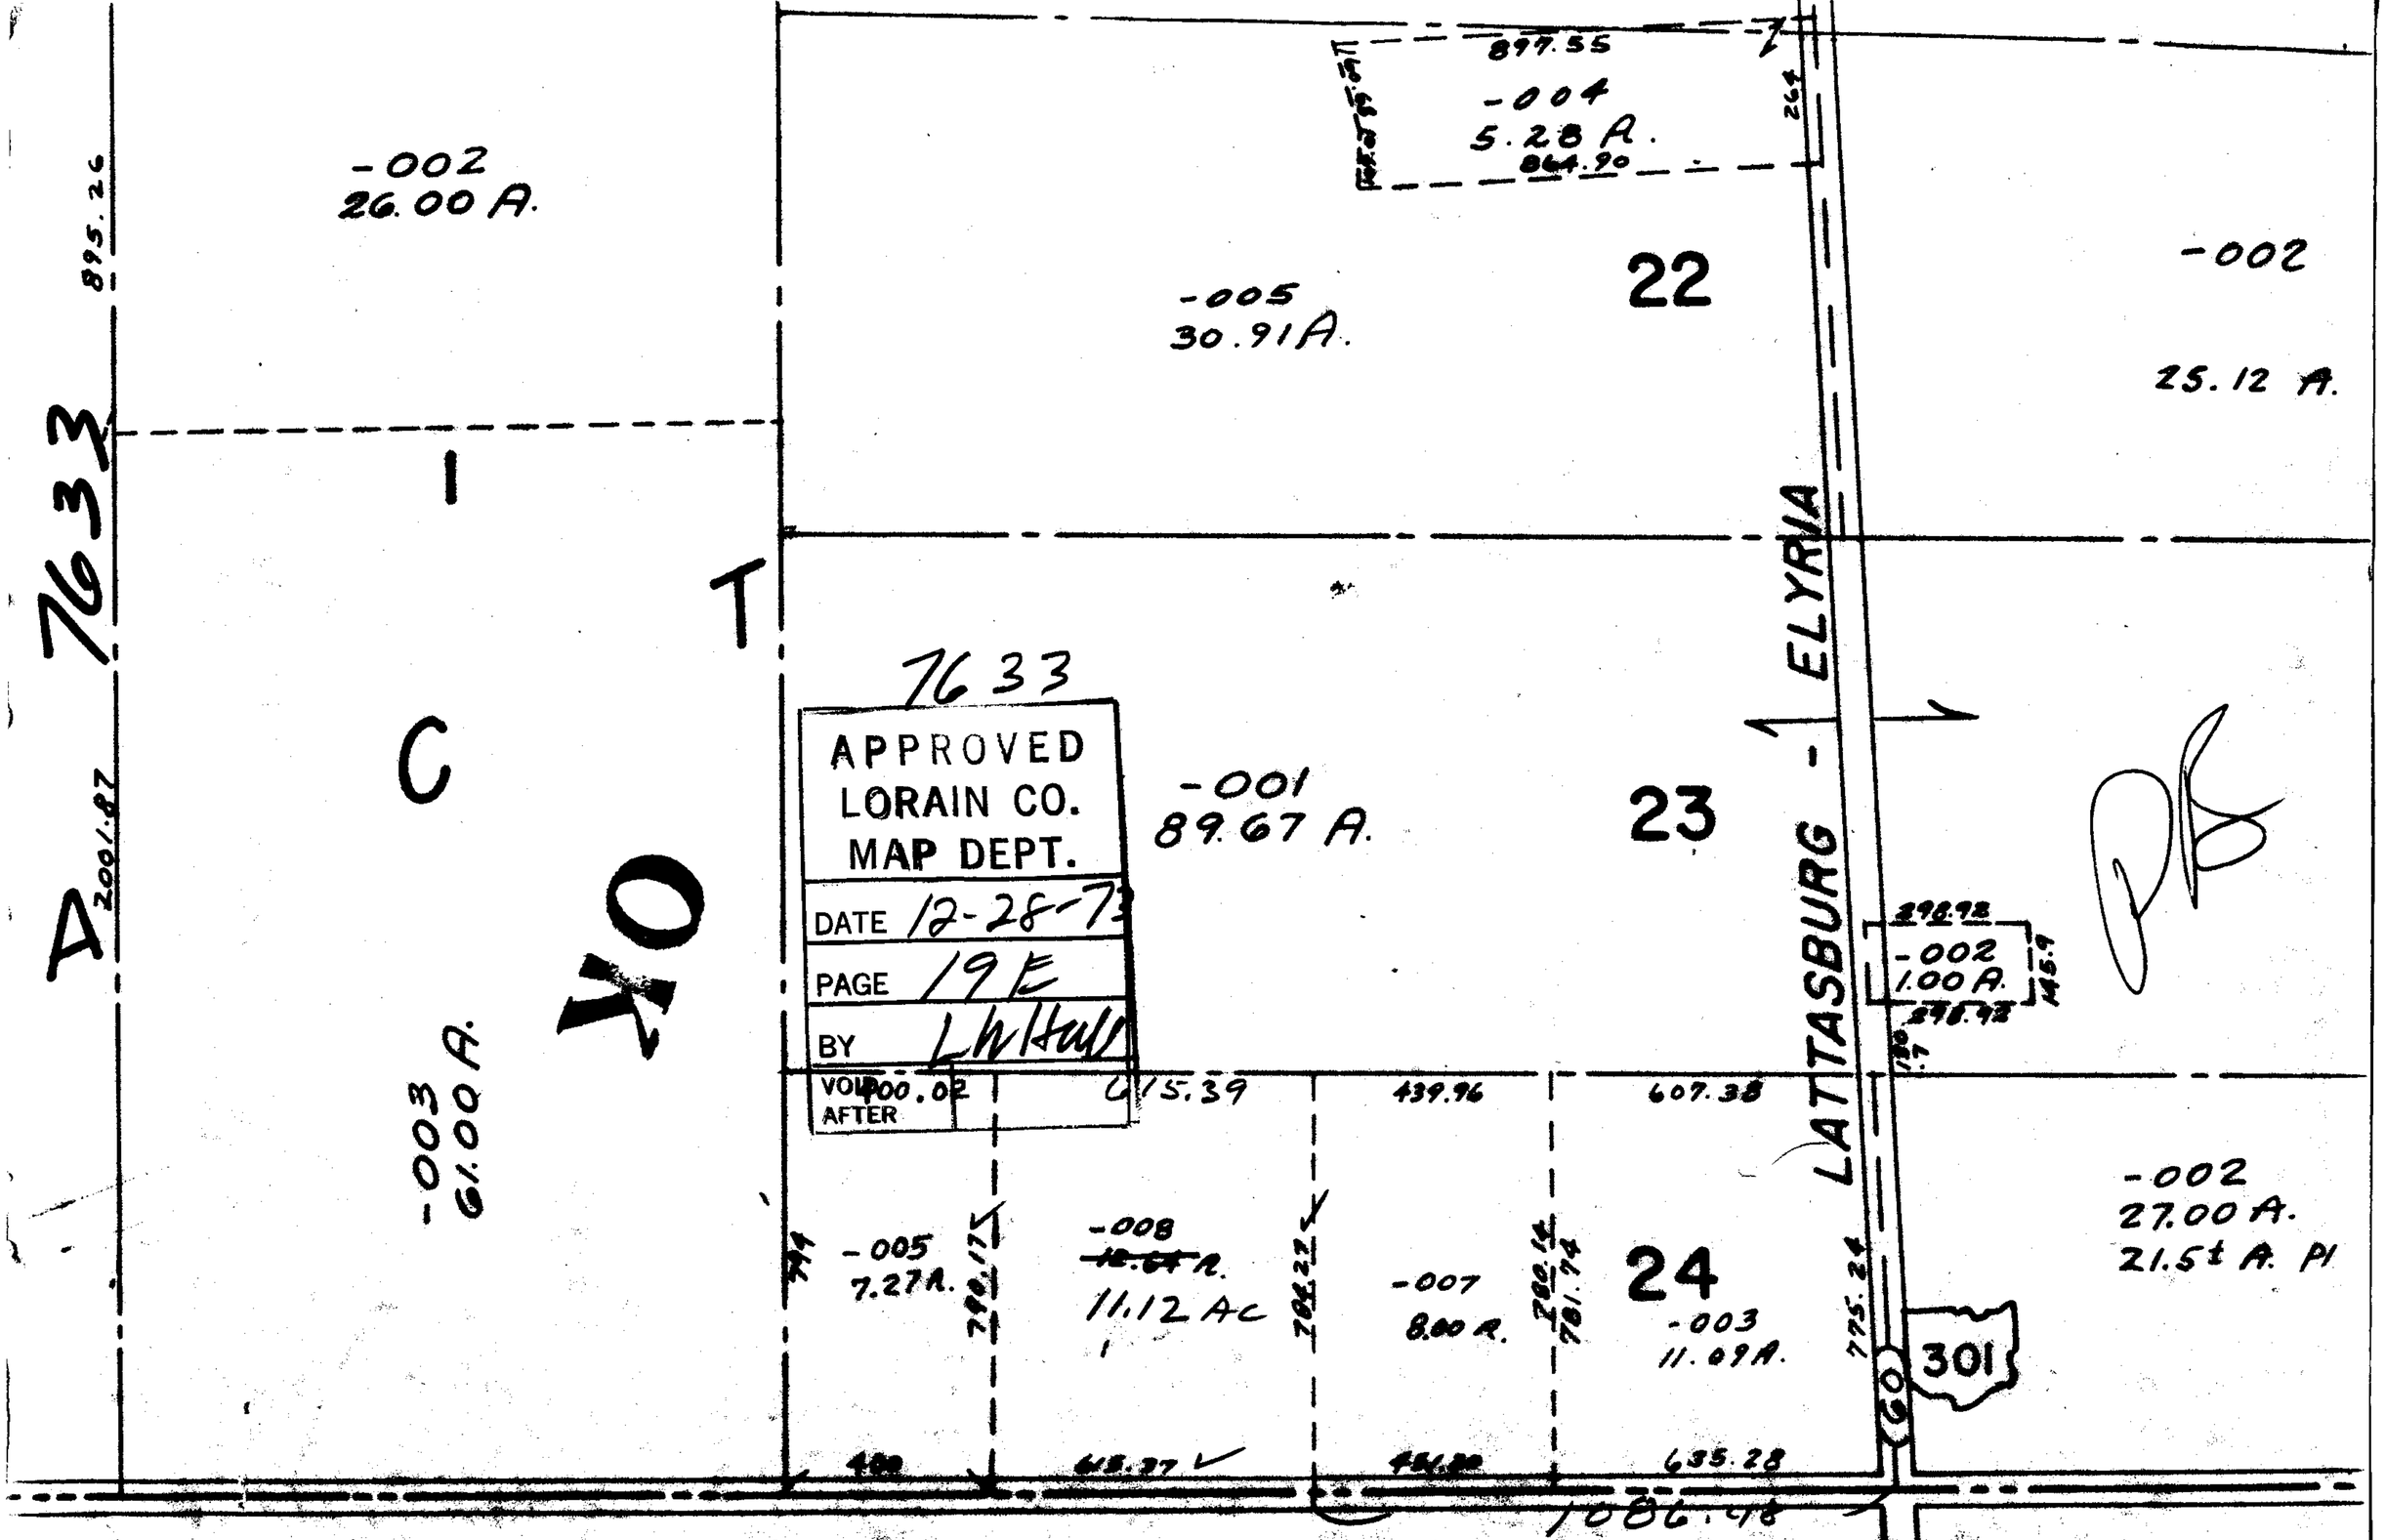

APPROVED
LORAIN CO.
MAP DEPT.
DATE 12-28-73
PAGE 19E
BY LWHall
VOL
AFTER

TRACT 1 LOTS 1, 2, 3, 21 THR
" 2 " 1, 2, 3, 17 "
" 3 " 9