

JOB NO. 1
35

7643


05-00-038B

7-30-86 L

APPROVED	
LORAIN CO.	
MAP DEPT.	
DATE	1-7-74
PAGE	05-00-038B
BY	L. W. Hall
VOID AFTER	

SEE 5-00-039-B

AVE

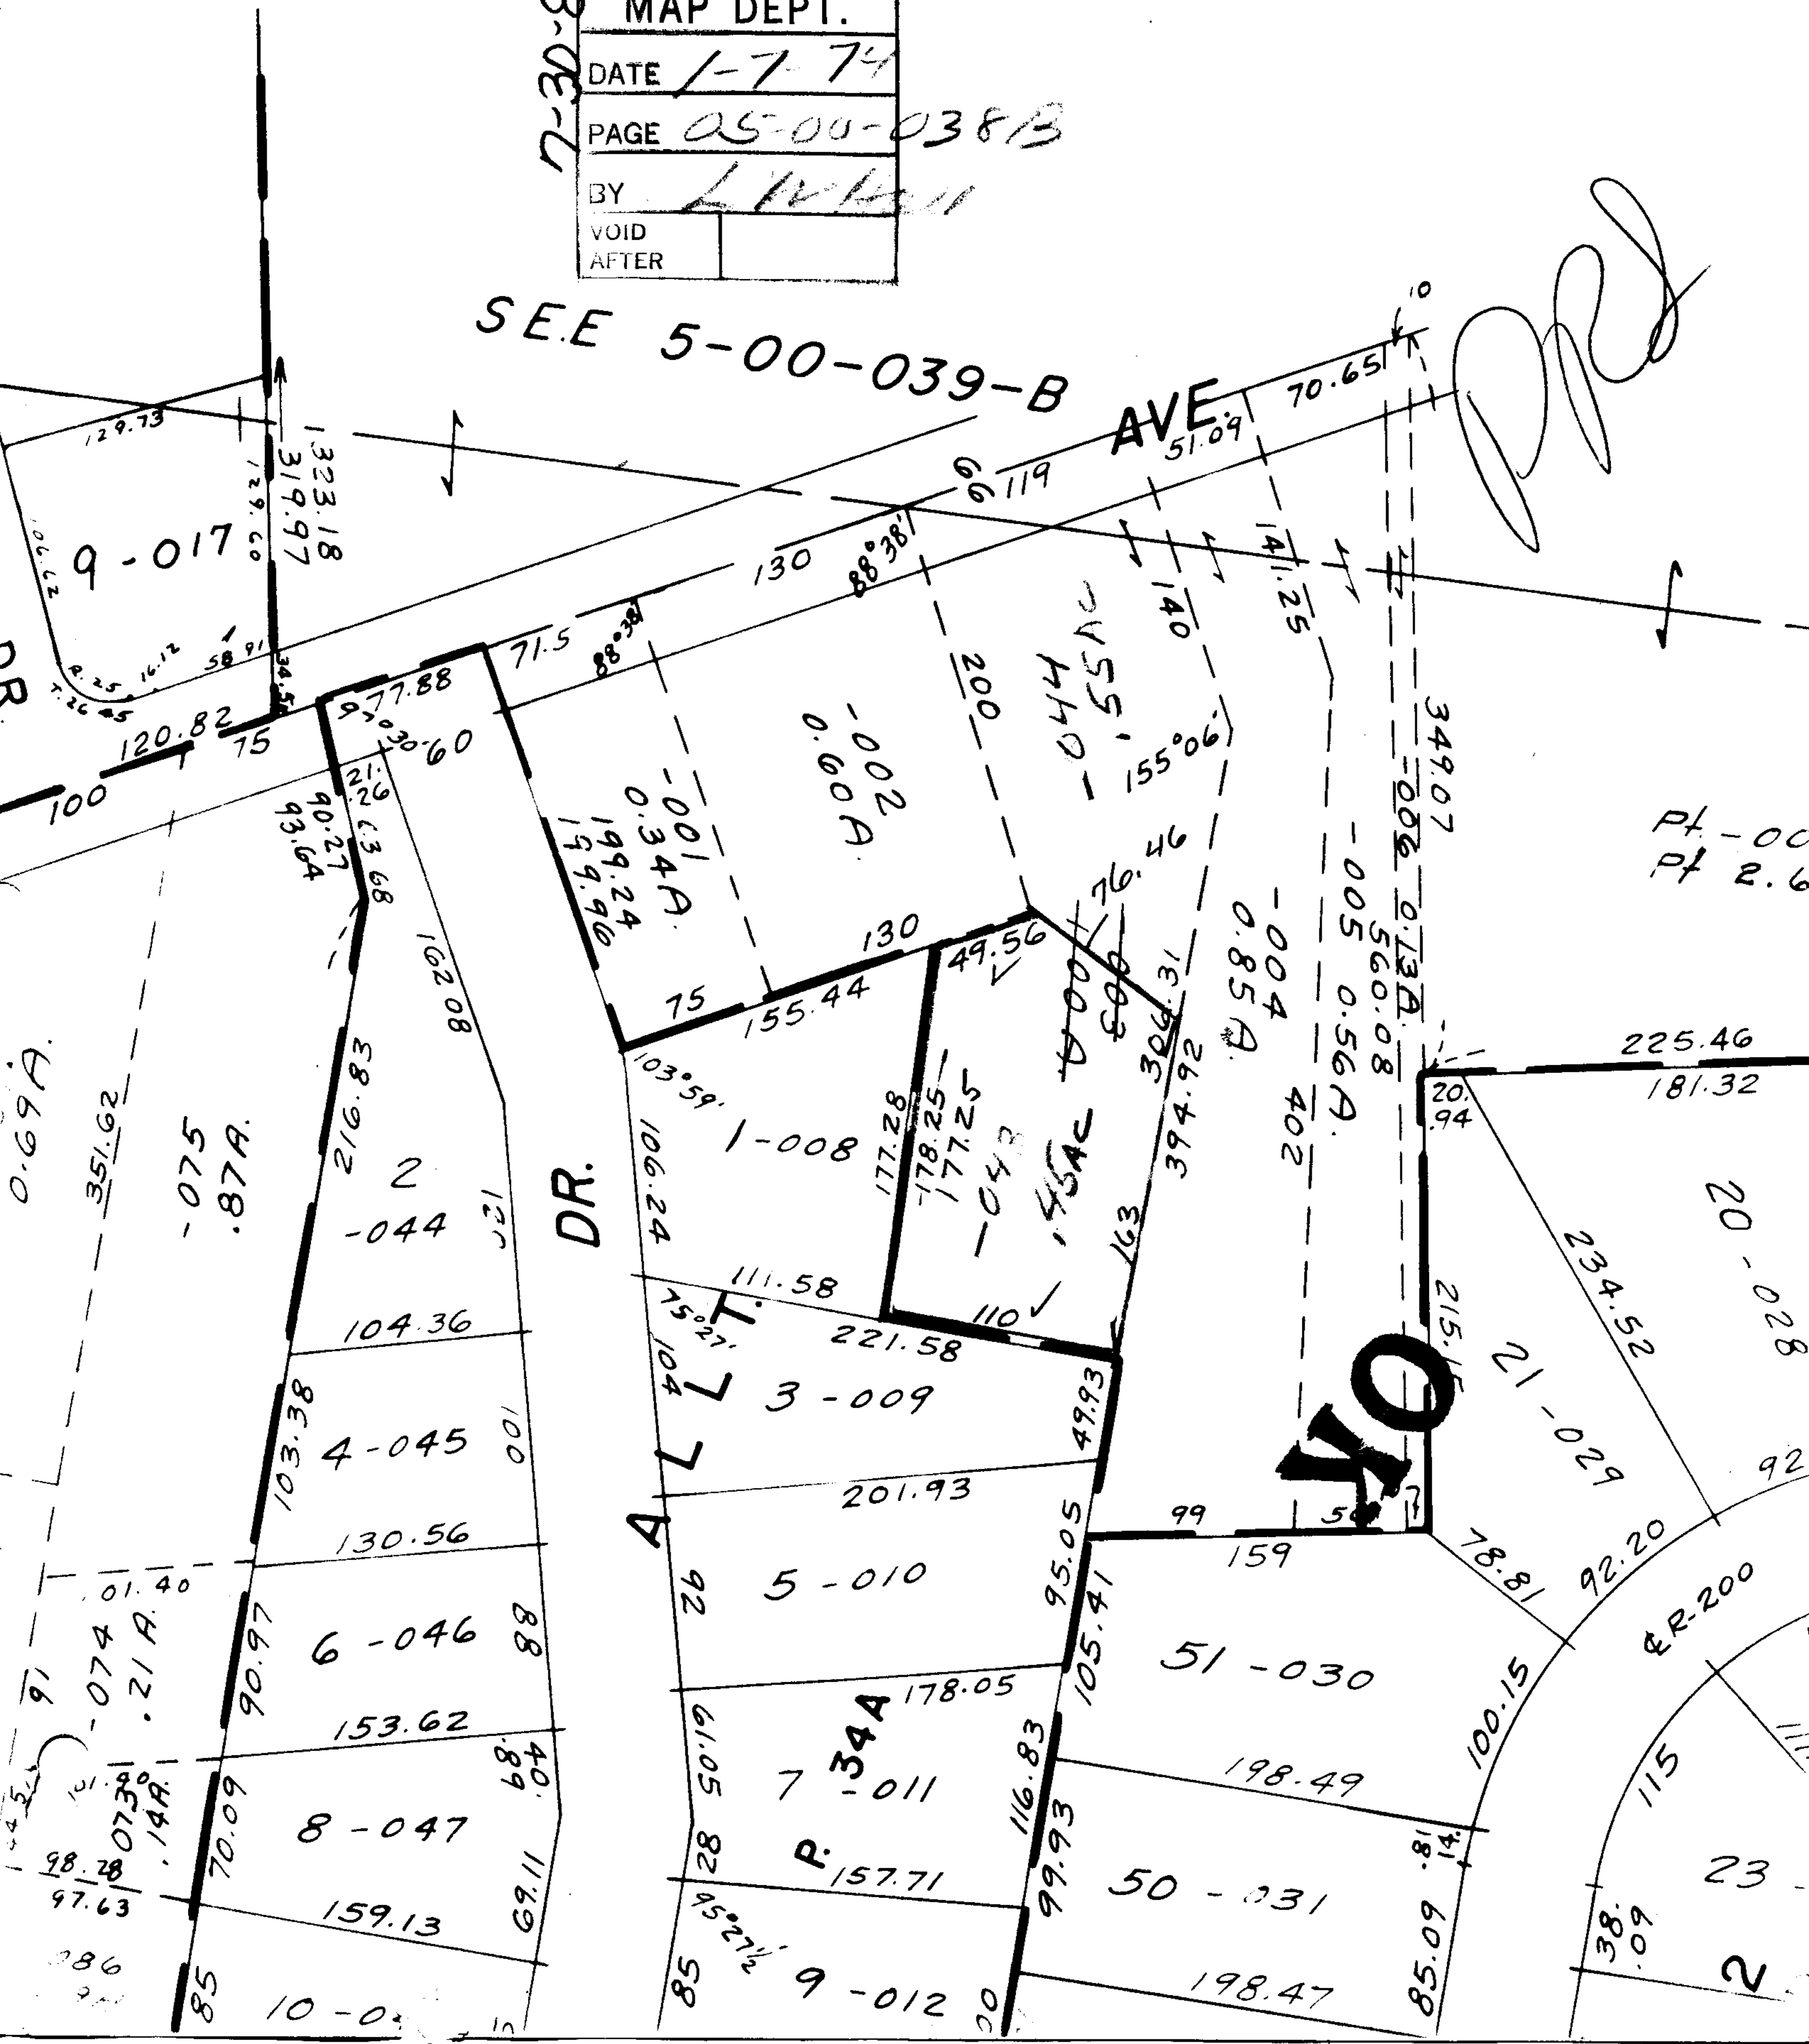

Pt. - 00
Pt 2.6

225.46
181.32

20-028

234.52

21-029

92.20

ER-200

100.15

115

23

2

NO