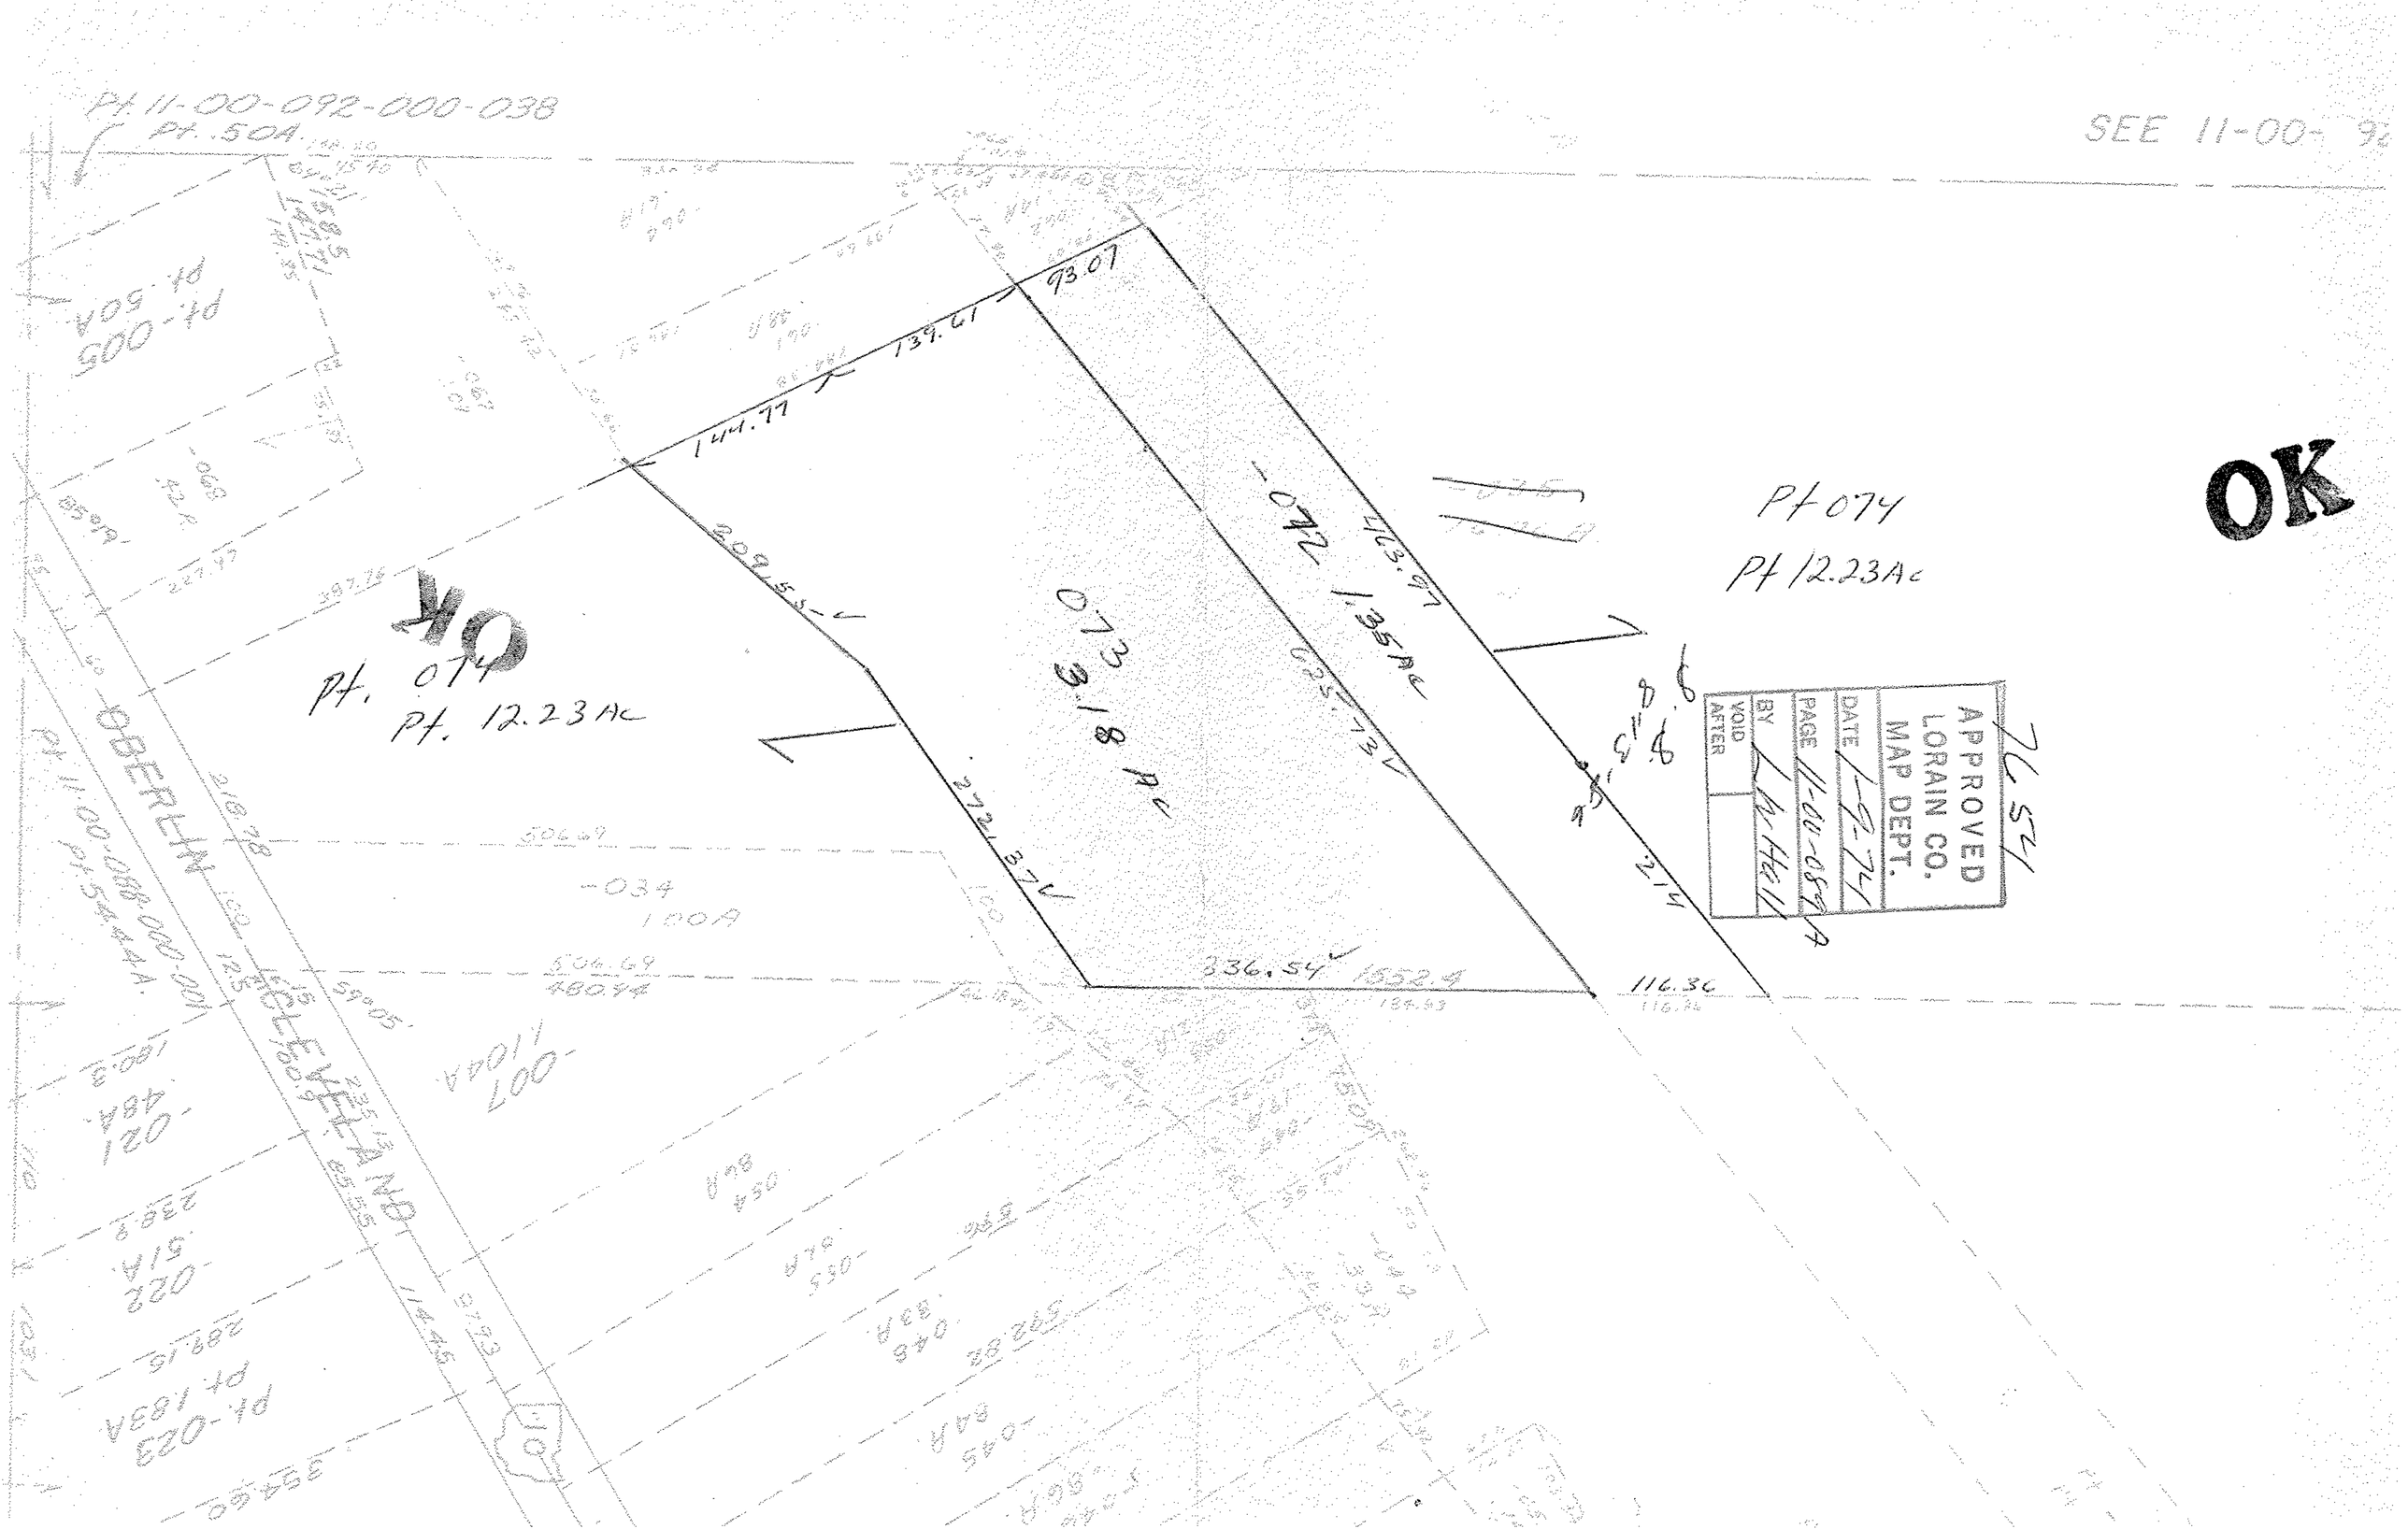
Pt 11-00-092-000-038
Pt. 50A
SEE 11-00-9
OK
Pt 074
Pt 12.23Ac
144.77
139.61
93.07
209.55
473.97
1.35Ac
-072
0.73.18 Ac
225.73
336.54
116.36
214
Pt. 074
Pt. 12.23Ac
OBERLIN
-034
100A
504.68
490.44
591.05
APPROVED
LORAIN CO.
MAP DEPT.
DATE
PAGE
BY
VOID
AFTER