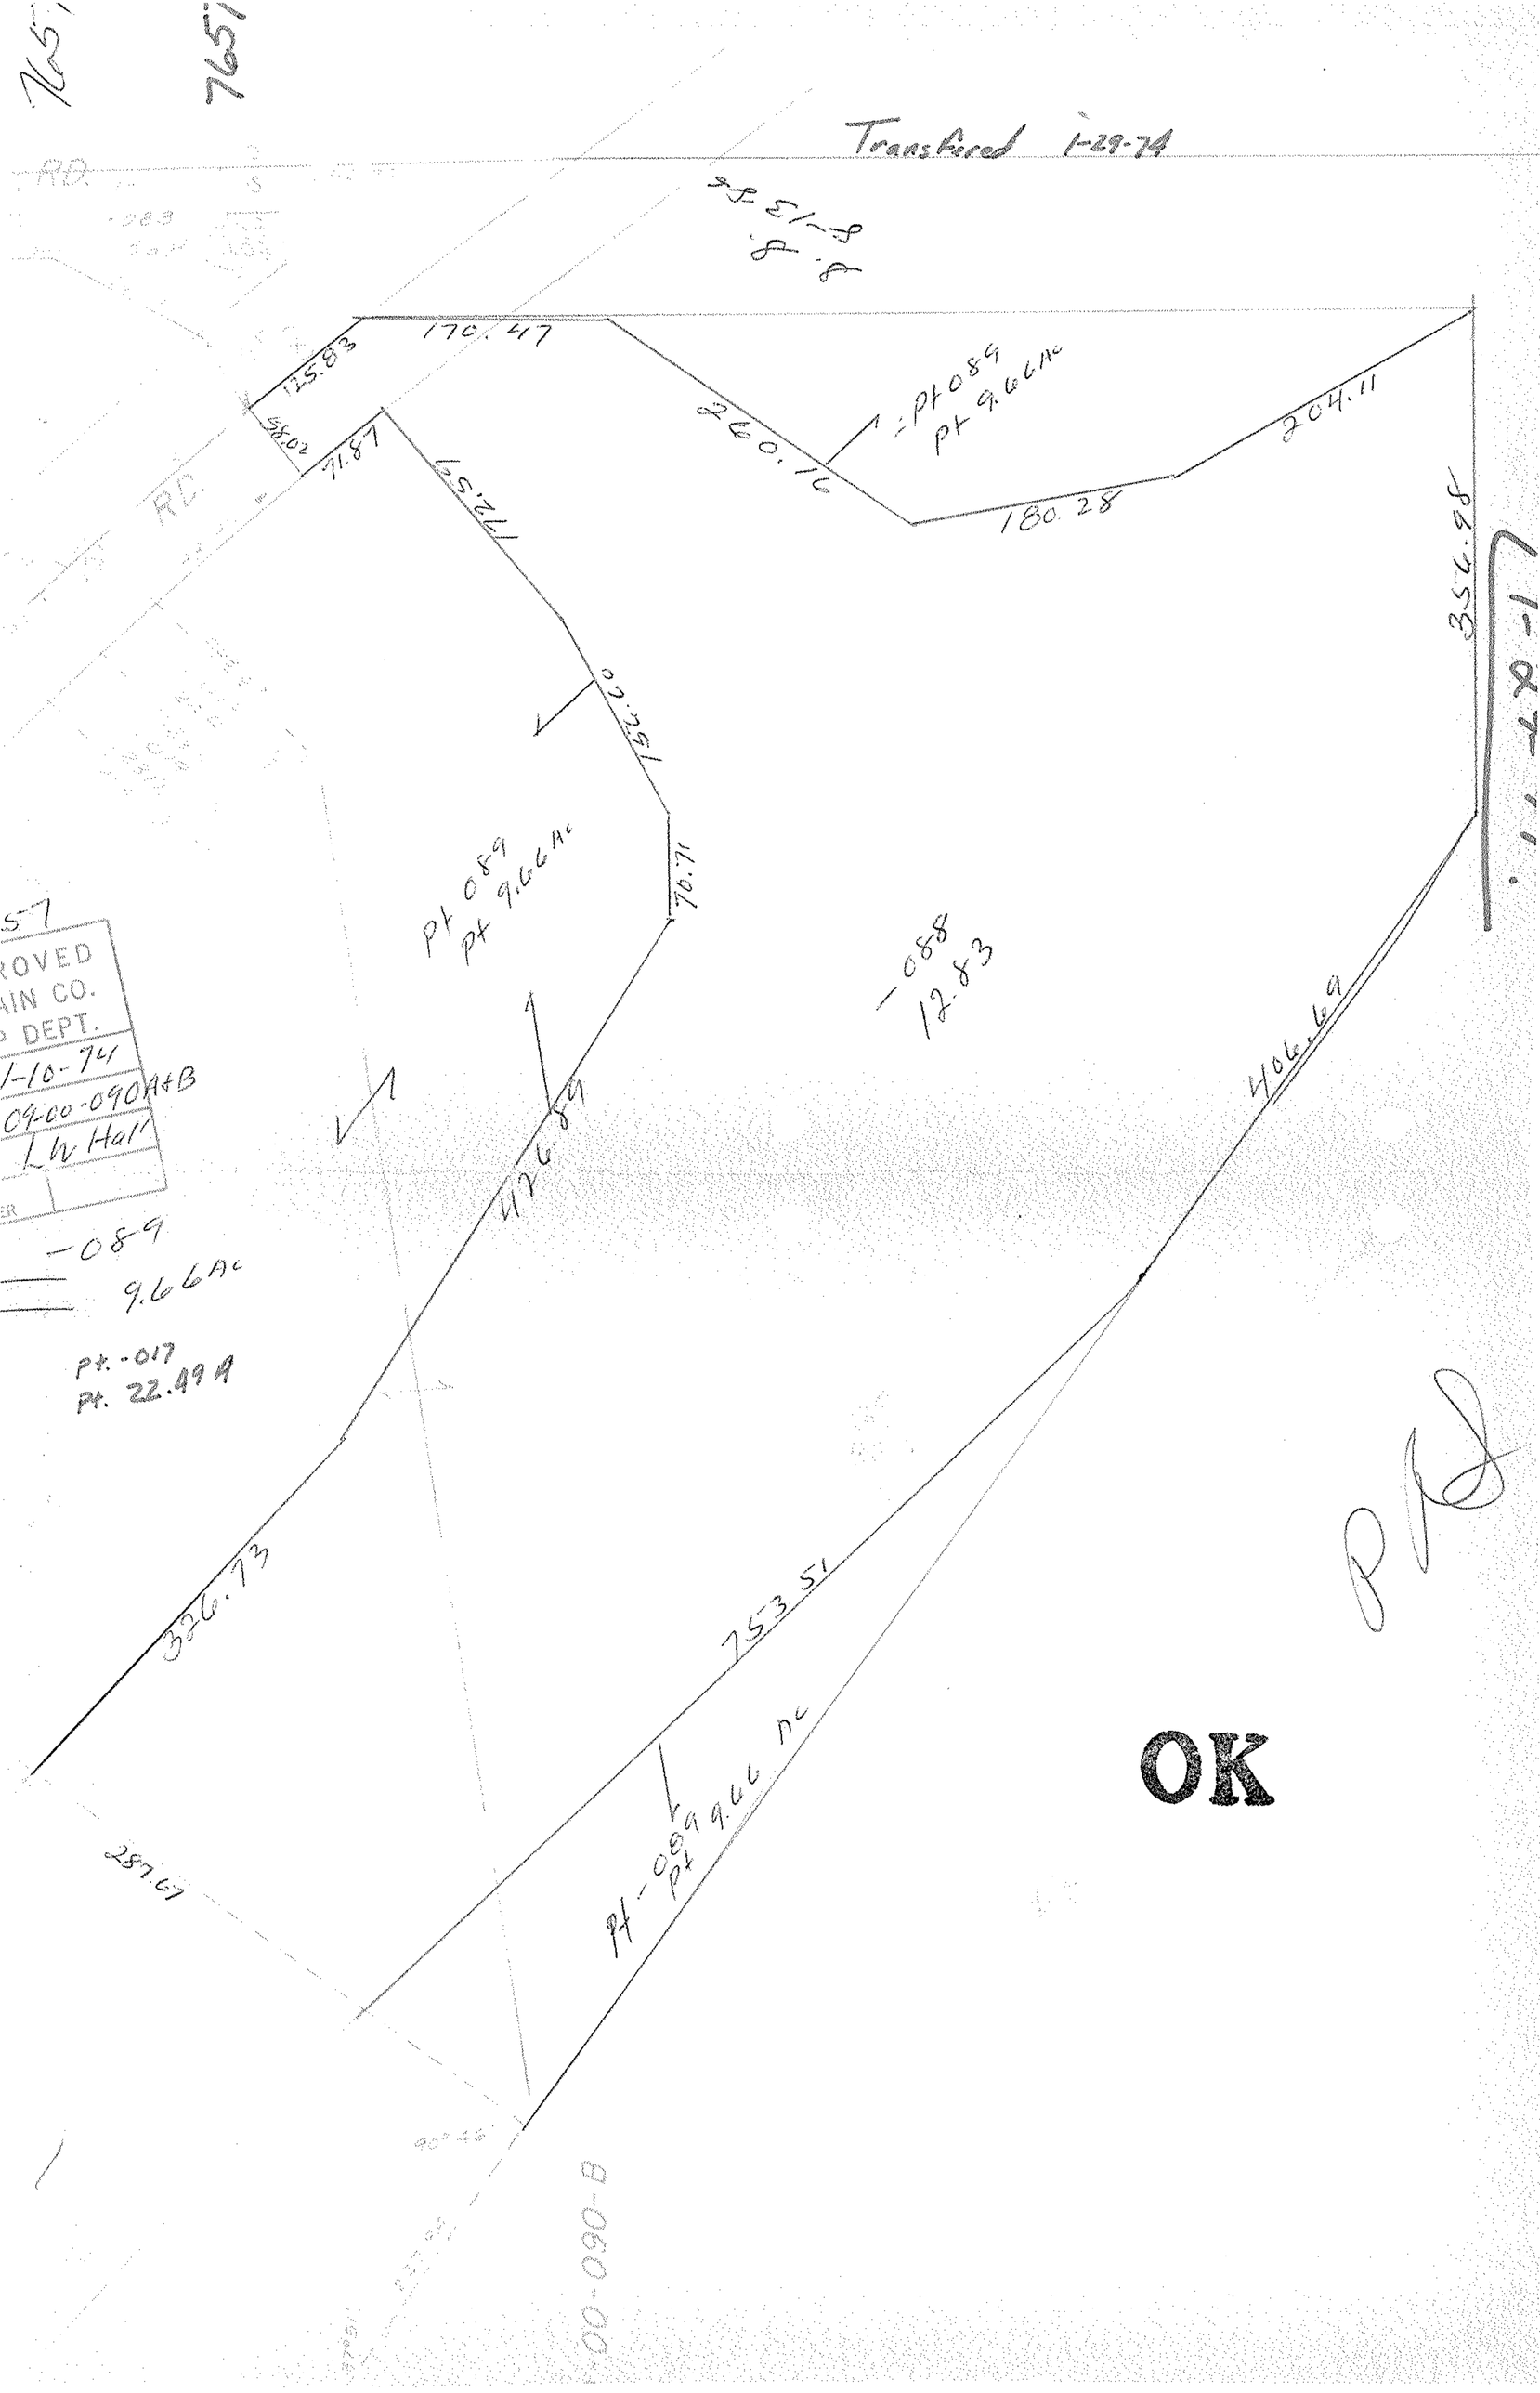
Transferred 1-29-74
170.47
125.53
St. 02
71.87
260.16
Pt 089
Pt 9.66 Ac
204.11
180.28
357.68
172.59
155.66
70.71
Pt 089
Pt 9.66 Ac
088
12.83
406.69
412.89
326.73
753.51
Pt. 089
Pt 9.66 Ac
287.67
089
9.66 Ac
Pt. 017
Pt. 22.49 A
OK