

7660

7-30-816 L.L.

7660

APPROVED
LORAIN CO.
MAP DEPT.


DATE 2-13-74

PAGE 5-C

BY L.V. Hall

VOID
AFTER

OK

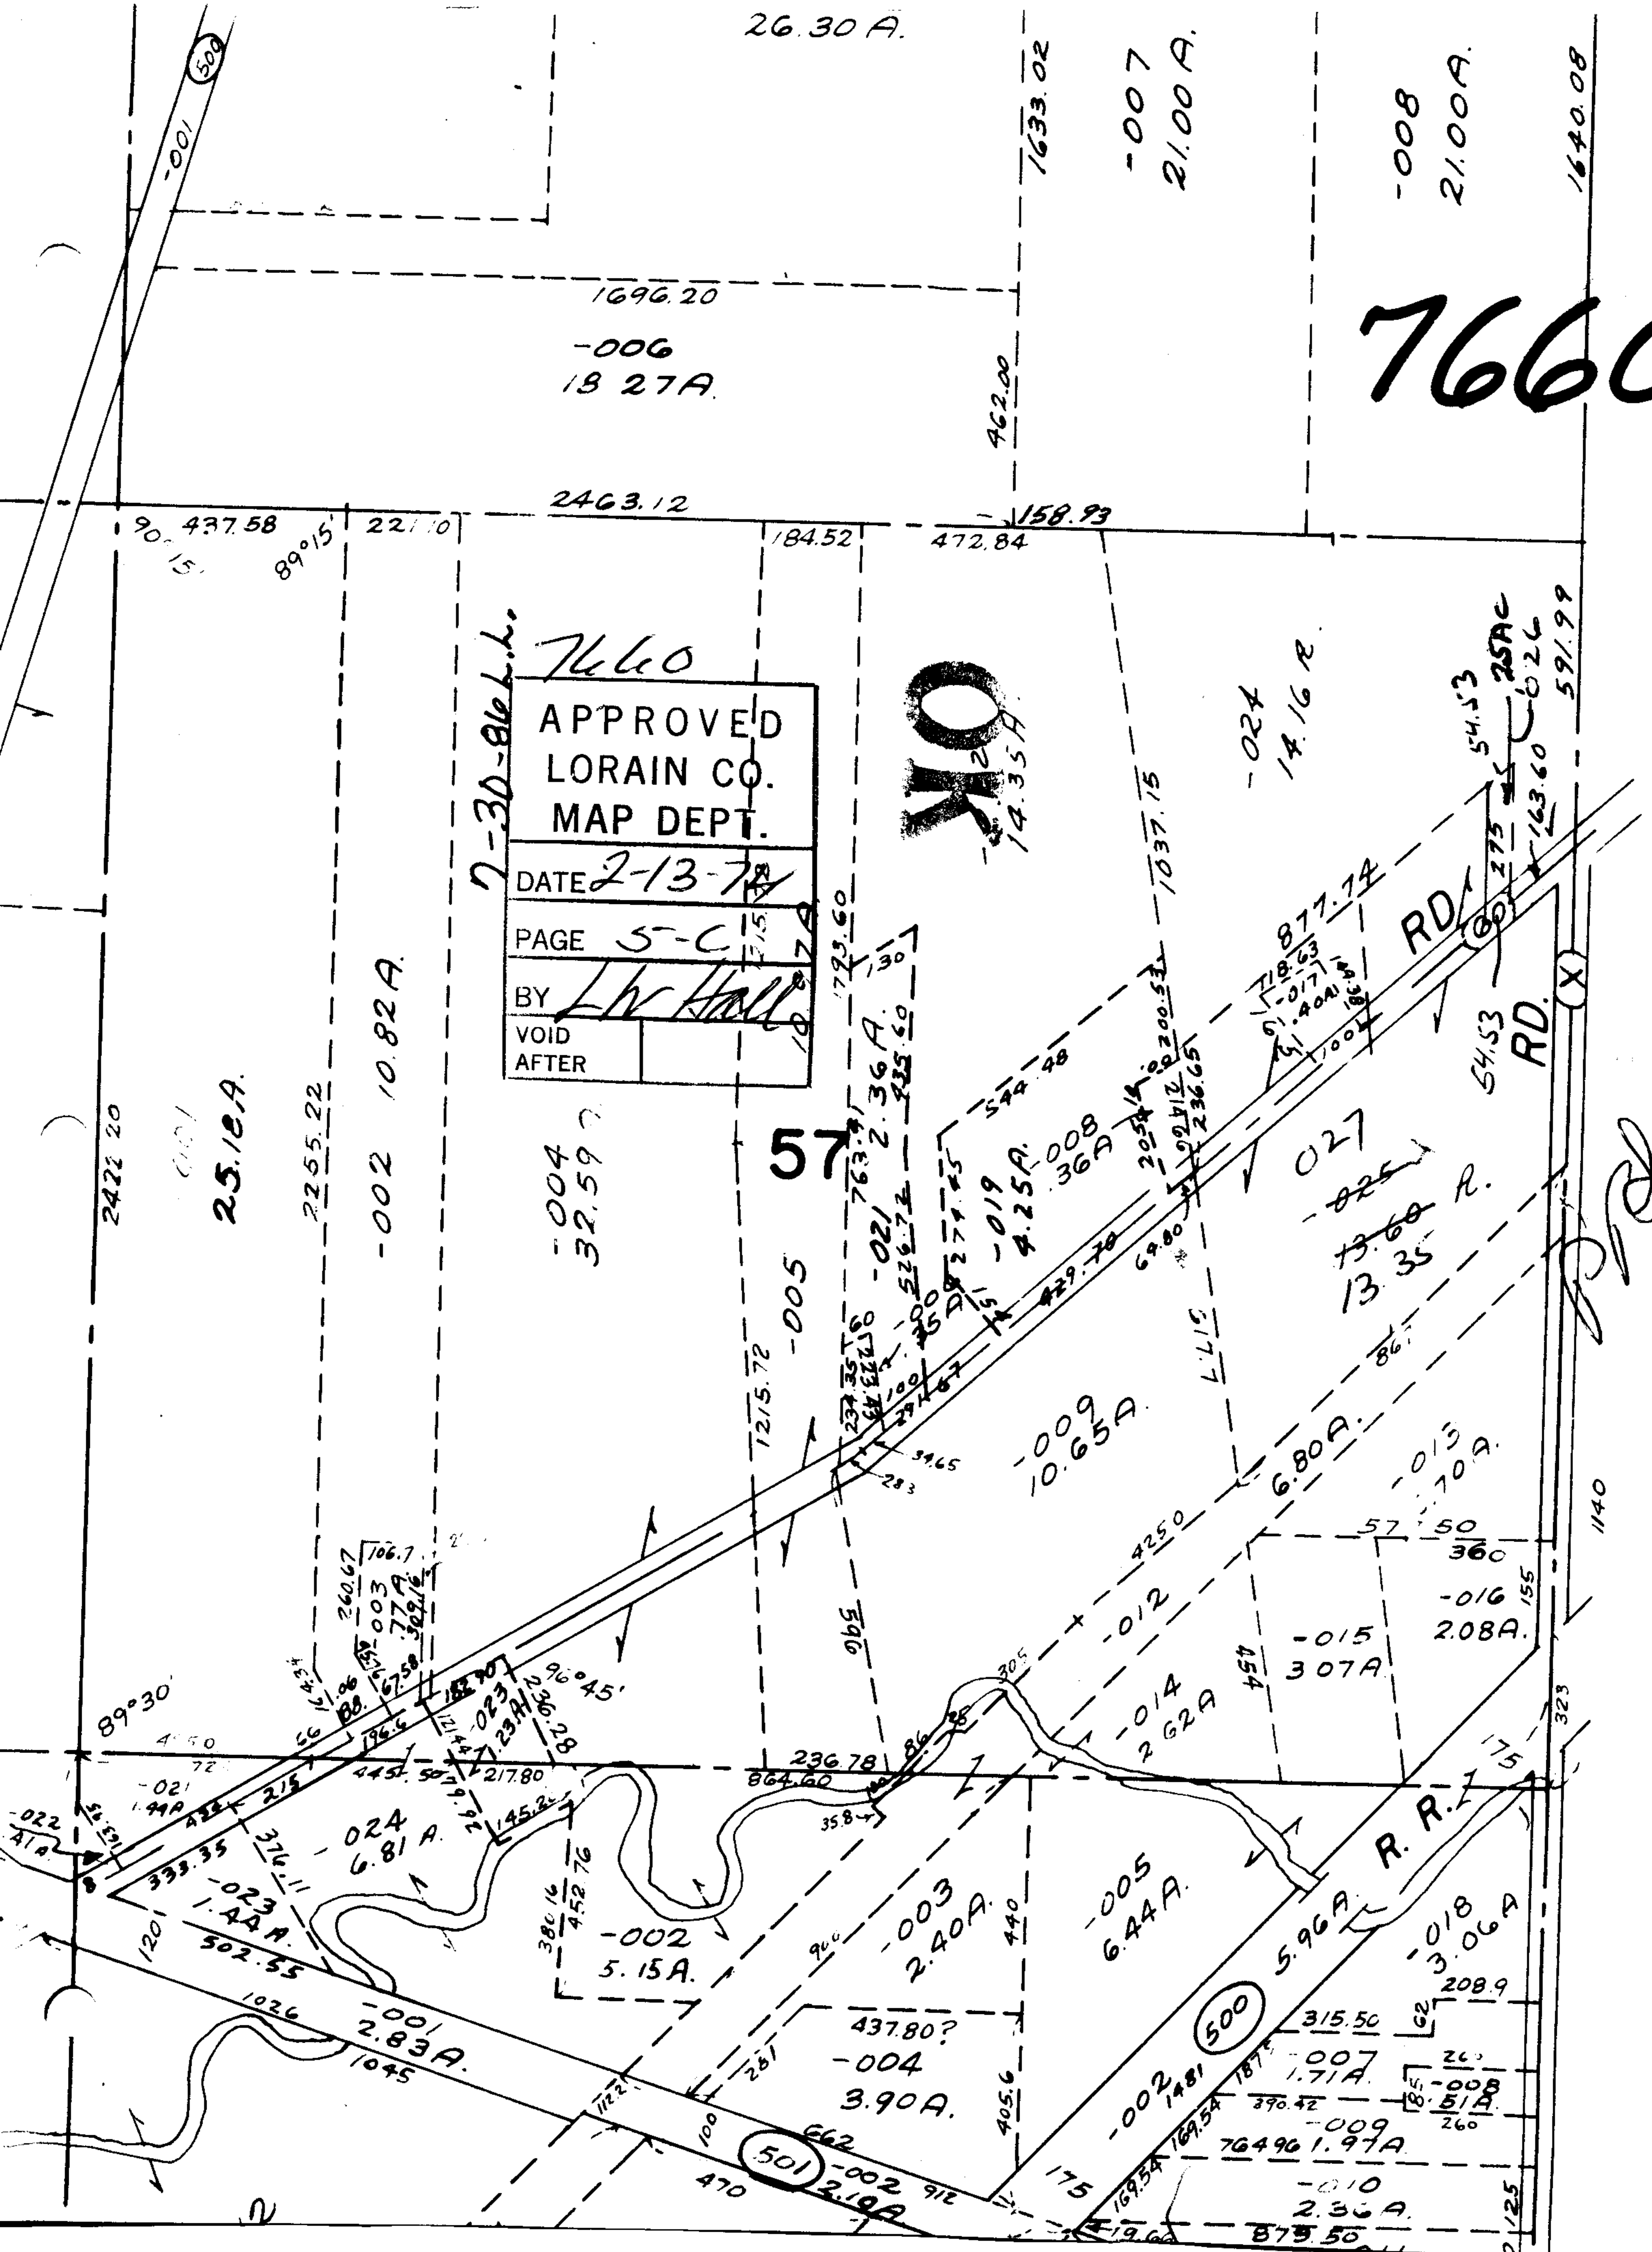

[Handwritten signature]