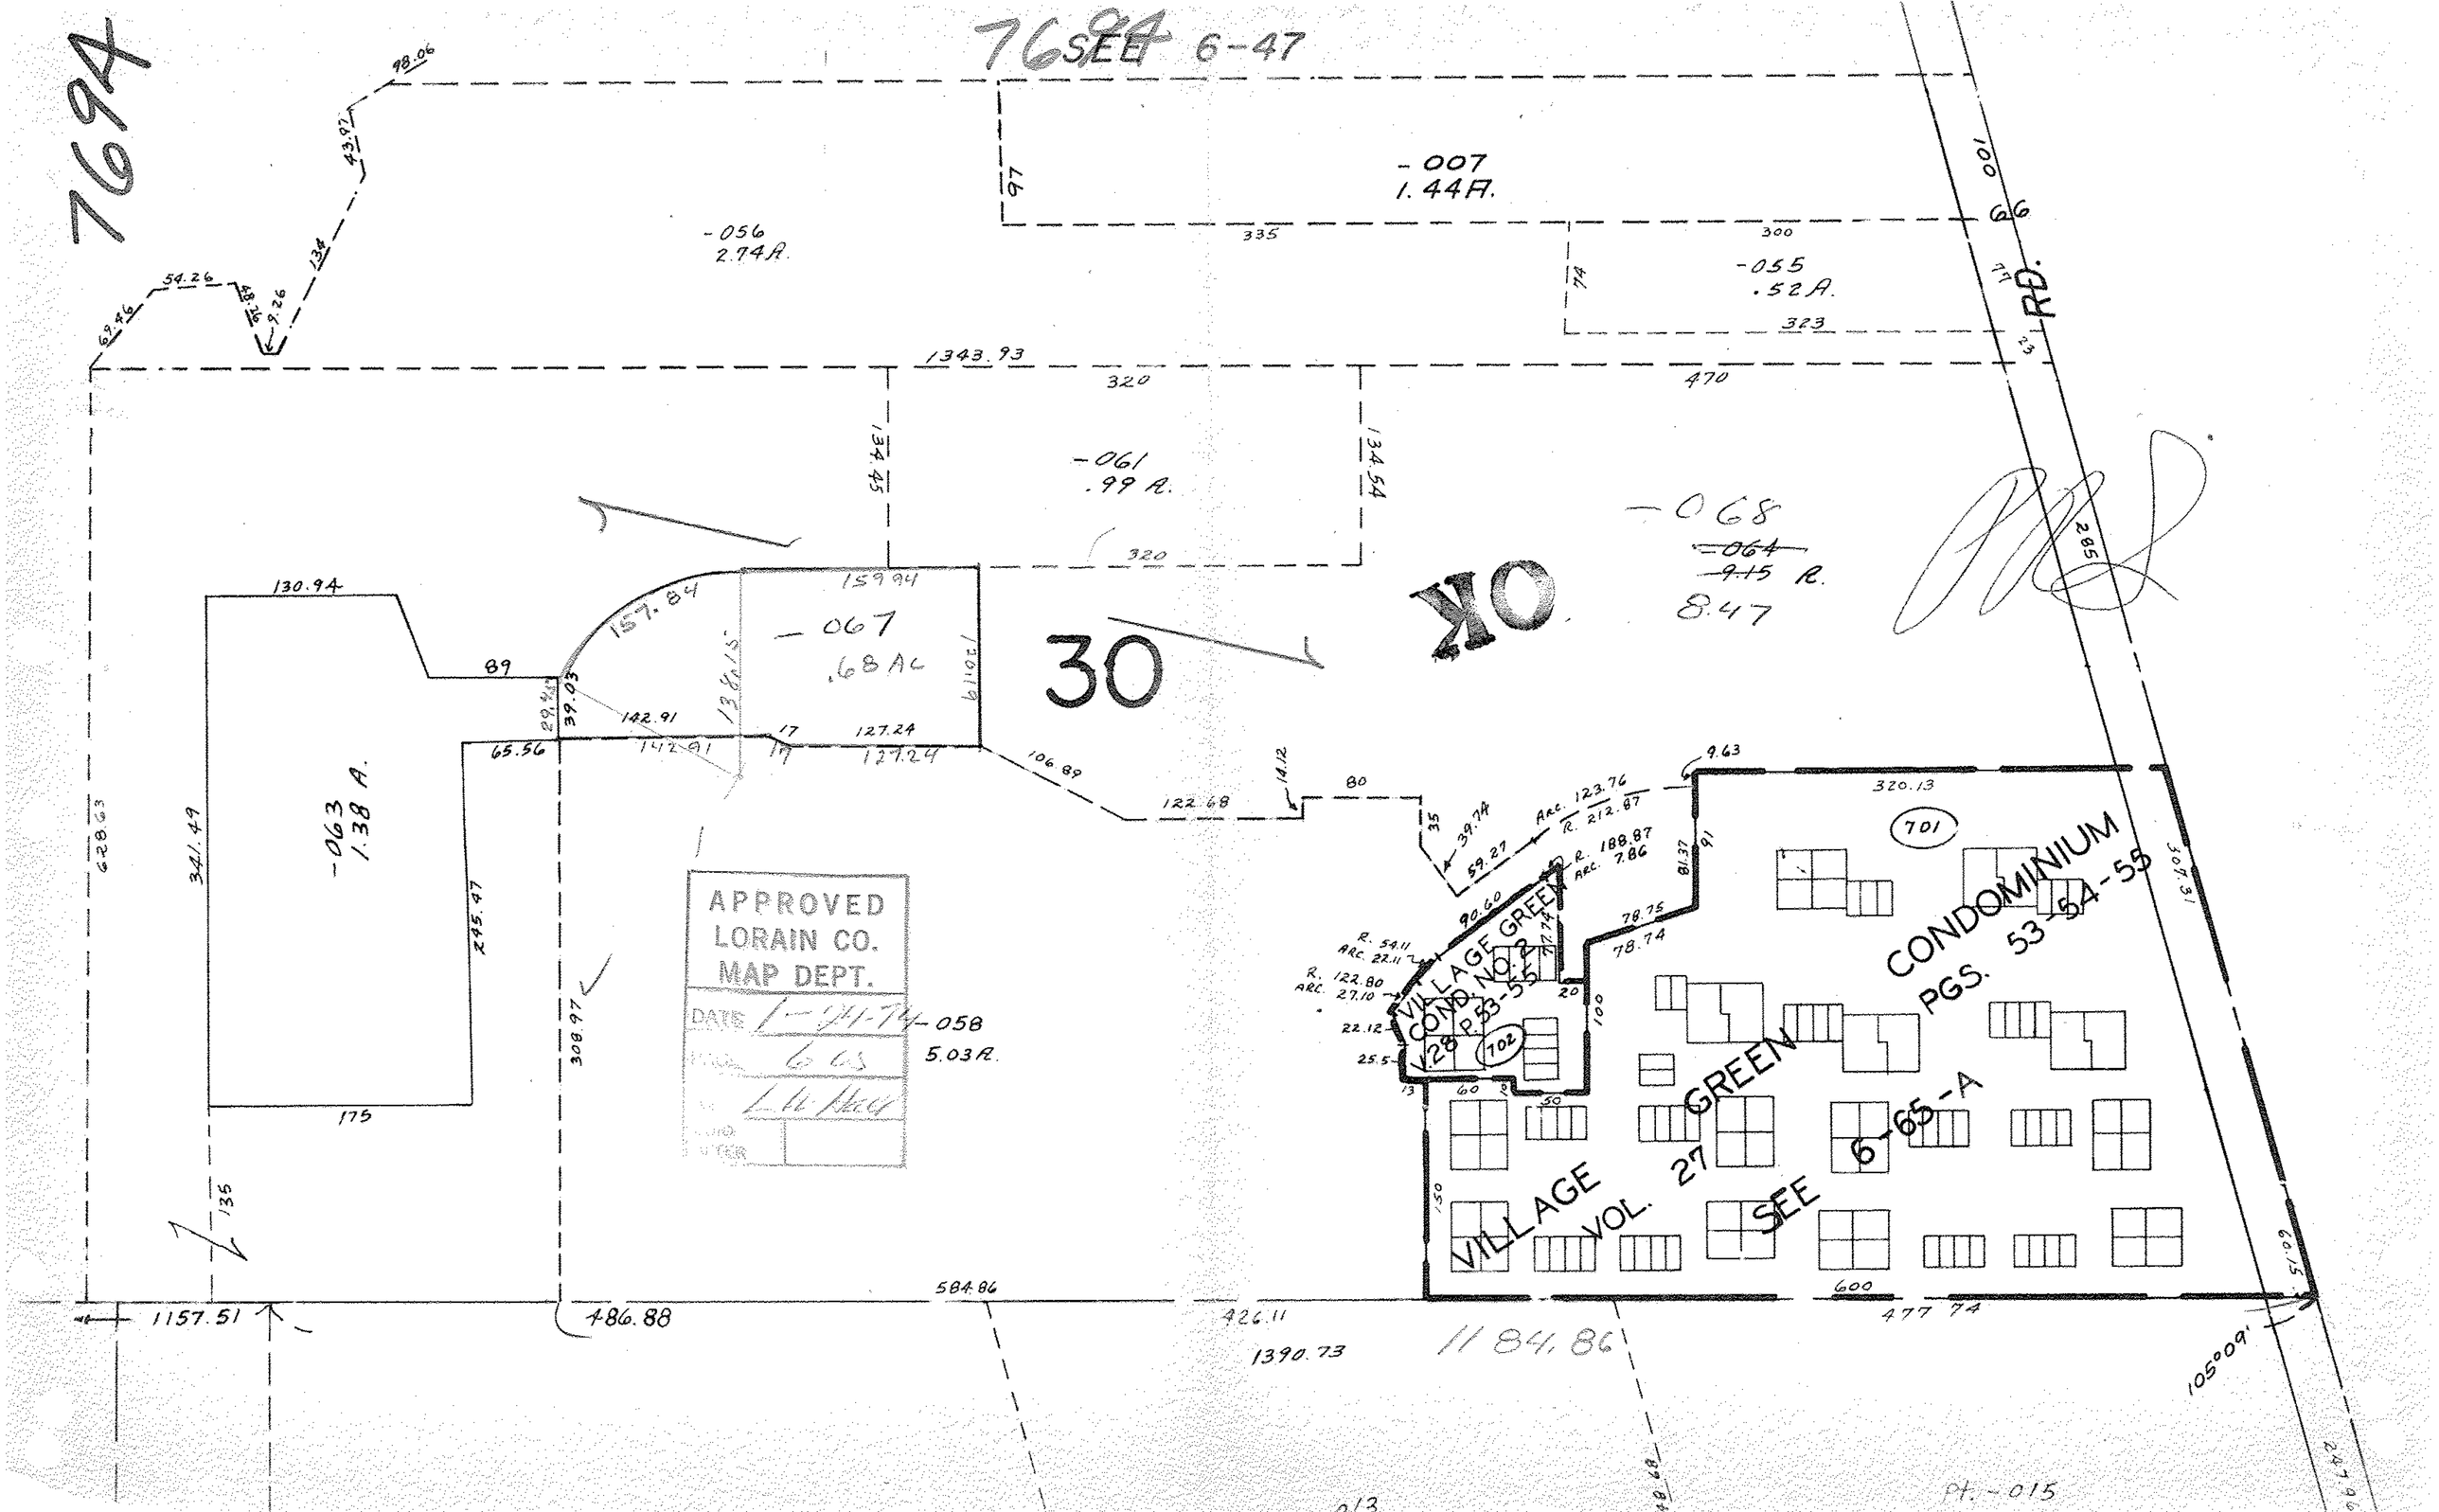

7694
SEE 6-47
-007
1.44A.
-056
2.74A.
-055
.52A.
-061
.99 A.
-068
~~-064~~
~~9.15~~ R.
8.47
-067
.68 AC
-063
1.38 A.
-058
5.03A.
30
OK
RD.
APPROVED
LORAIN CO.
MAP DEPT.
DATE 1-24-74
VILLAGE GREEN
COND. NO. 2
V.28 P.53-55
VILLAGE GREEN CONDOMINIUM
VOL. 27 PGS. 53-54-55
SEE 6-65-A
701
702
1343.93
1157.51
486.88
584.86
426.11
1390.73
1184.86
477.74
105°09'
Pt. -015