


SEE 7-F

A

11-00-070-B

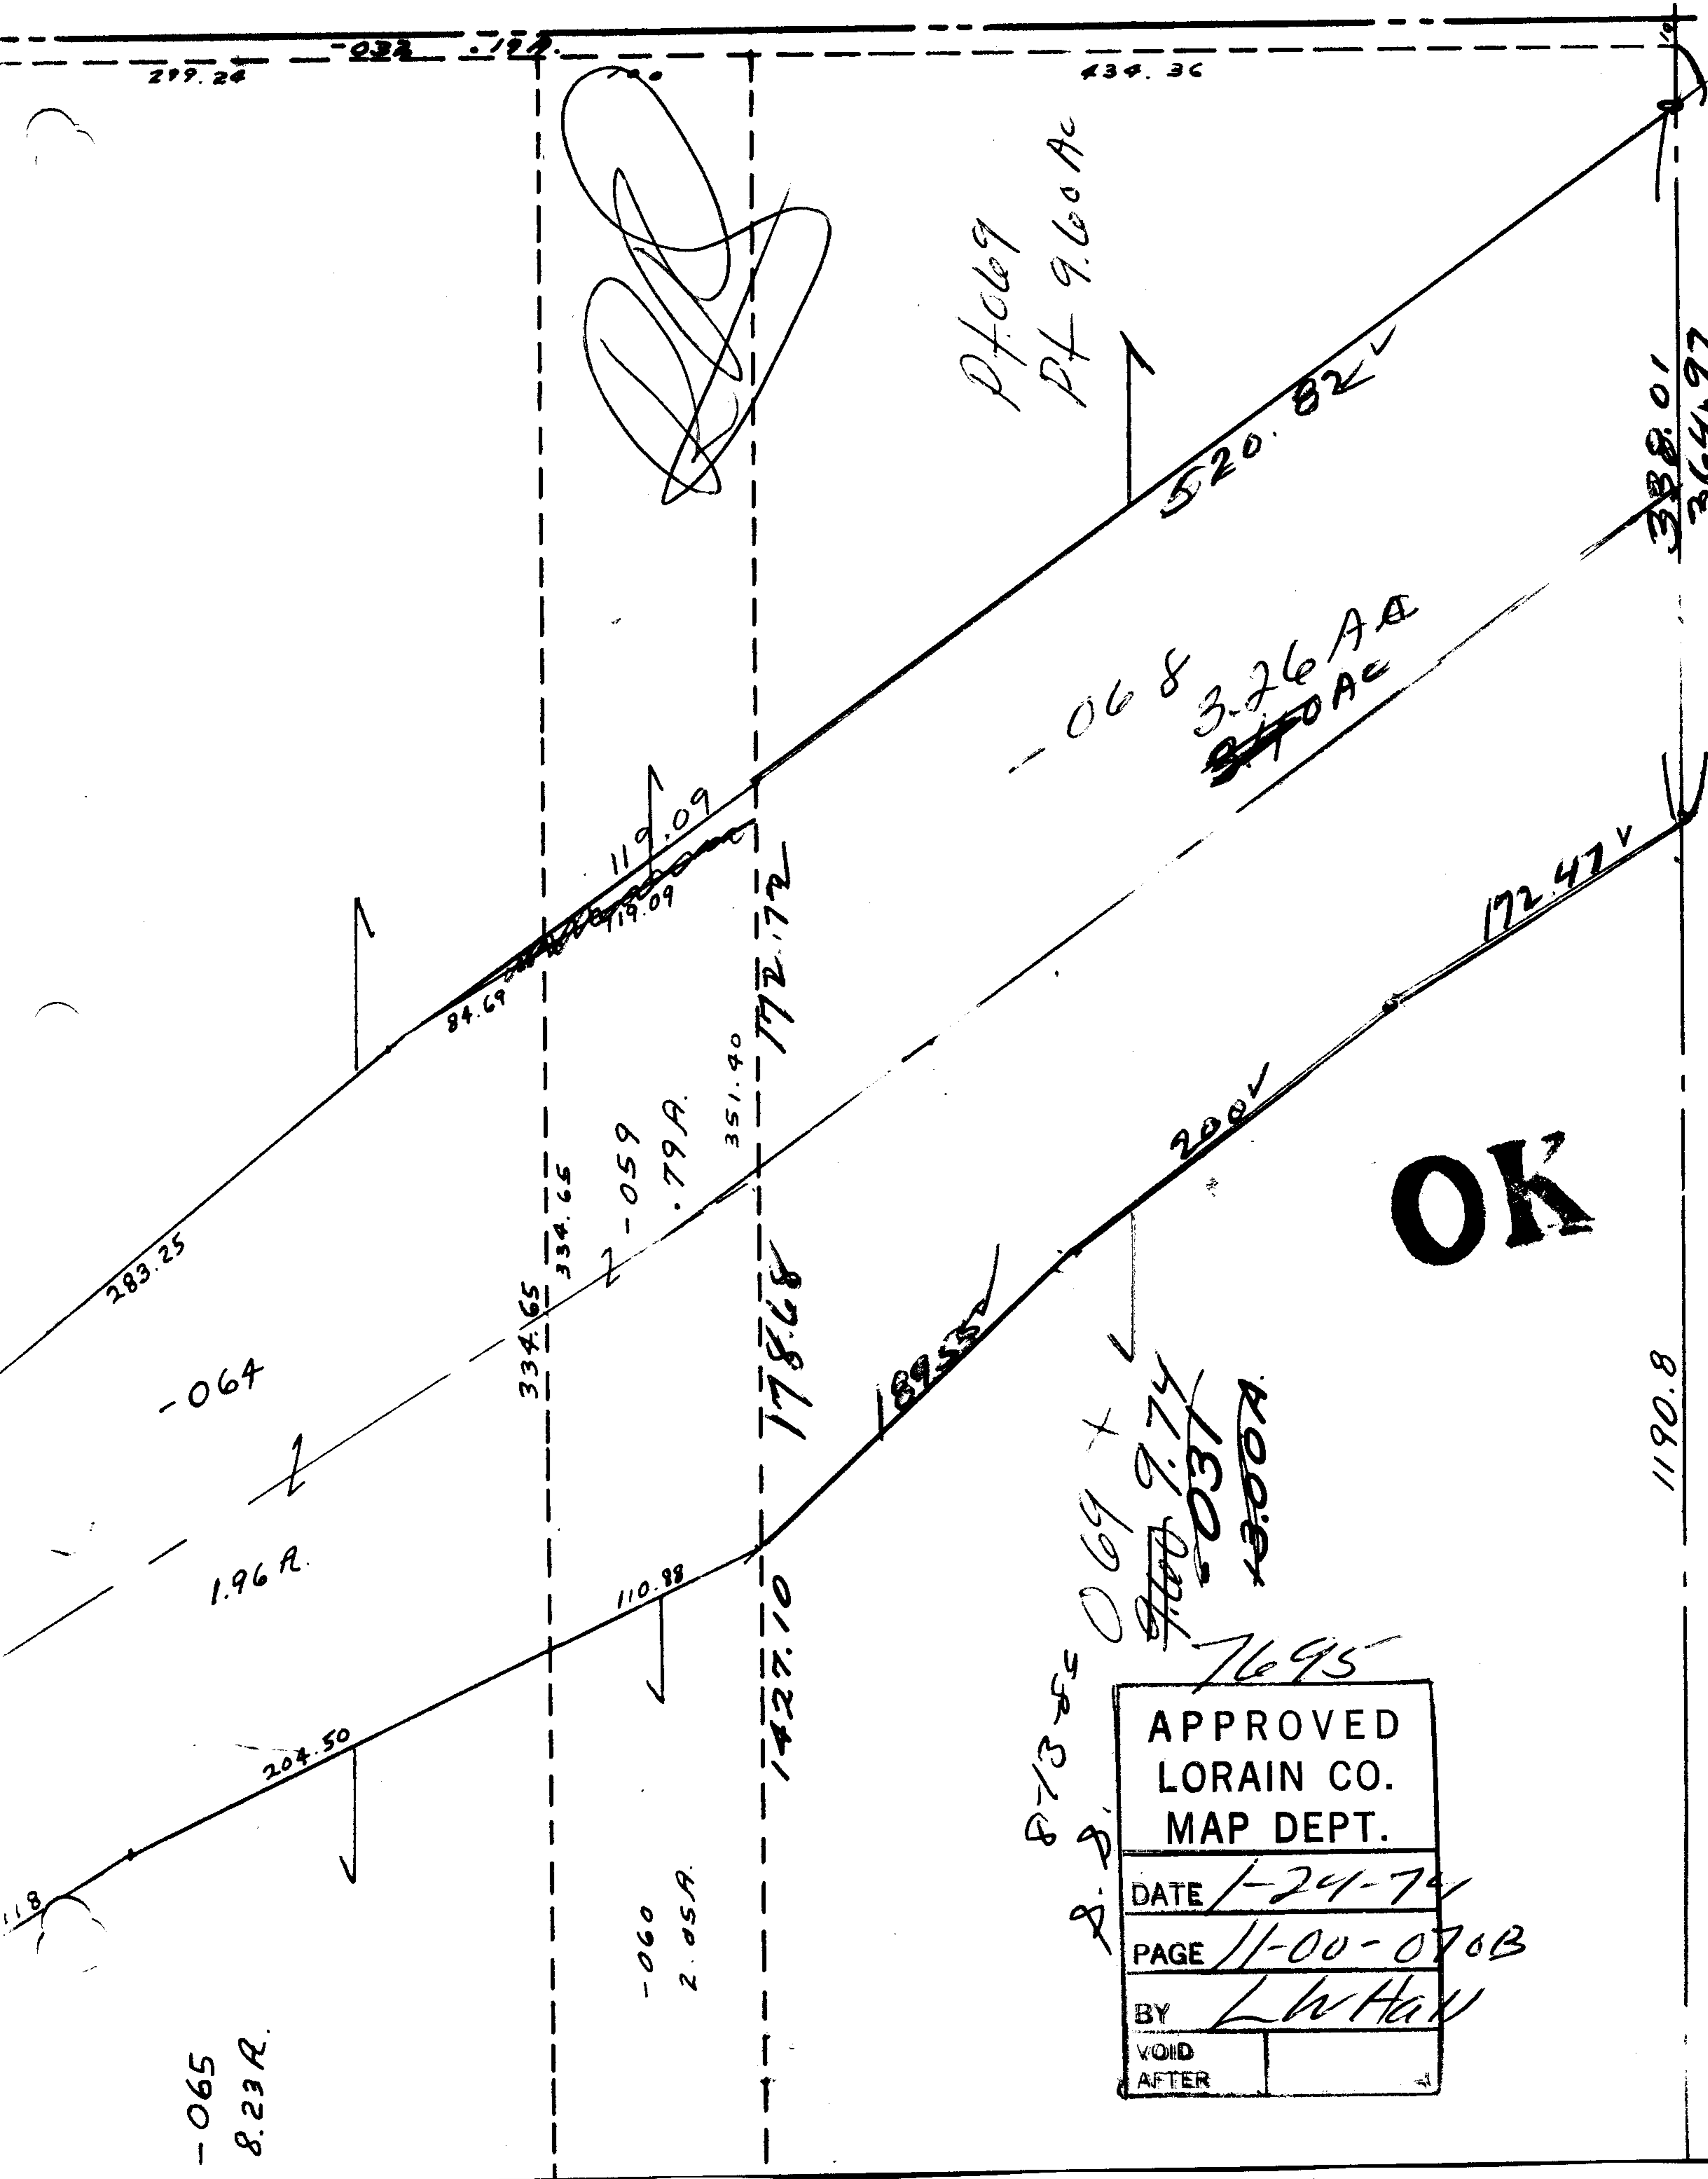

Pt 069
Pt 9.60 Ac

-068 3.26 AA
~~3.70 Ac~~

-065
8.23 R.

-060
2.05 A.

OK

APPROVED LORAIN CO. MAP DEPT.	
DATE	1-24-74
PAGE	11-00-070B
BY	L W Hall
VOID AFTER	

8-13-85
 8-13-85
 069 + L
 9.74
 037
 13.00 A.
 7695

1190.8

338.01
364.97

434.36

299.24

-032

.792

520.82

172.47

172.72

178.68

1427.10

119.09

-059
.79 A.

351.90

334.65

334.65

283.25

-064

1.96 R.

204.50

84.69

119.09

118