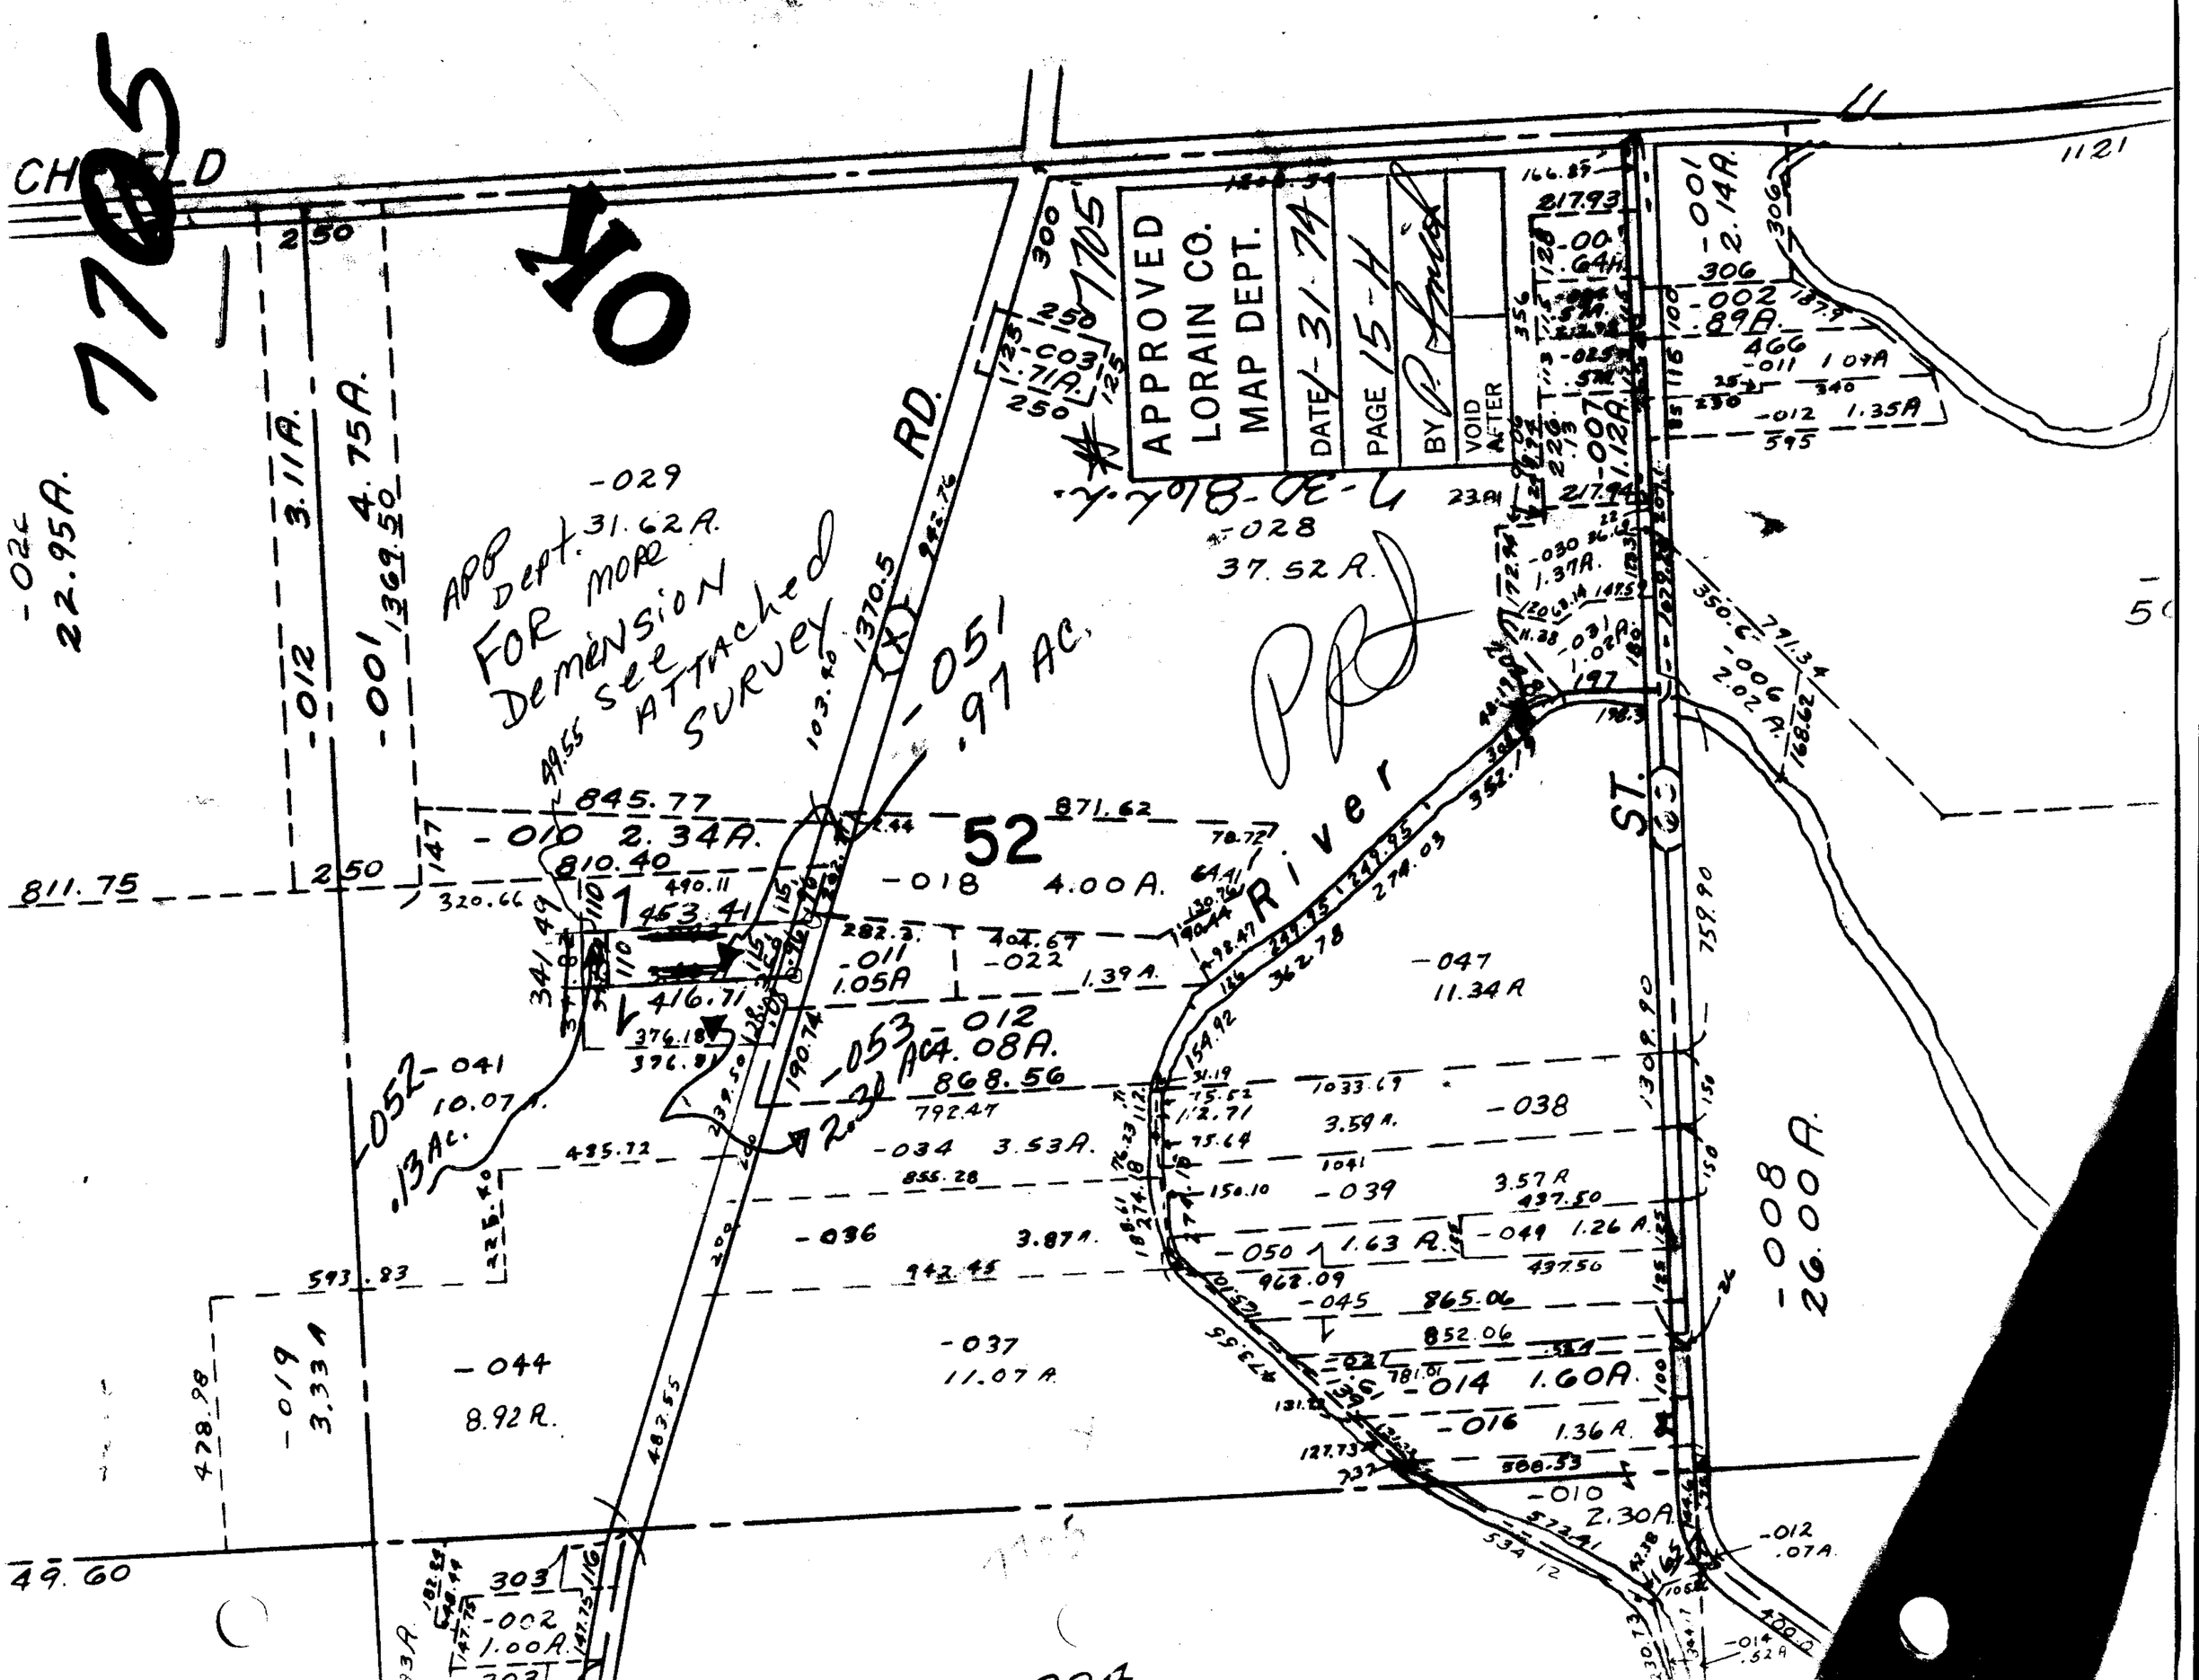

7705
OK
APPROVED
LORAIN CO.
MAP DEPT.
DATE 1-31-74
PAGE 15-H
BY
VOID AFTER
APP Dept. FOR MORE DEMENSION see ATTACHED SURVEY
52
River
ST.
RD.
-029 31.62 A.
-028 37.52 A.
-051 .97 AC.
-010 2.34 A.
-018 4.00 A.
-047 11.34 A
-038
-039
-036
-037 11.07 A.
-044 8.92 A.
-019 3.33 A
-052 .13 AC.
-053 2.31 AC.
-008 26.00 A.
-014 1.60 A.
-016 1.36 A.
-010 2.30 A.
-002 1.00 A.
-012 3.11 A.
-001 4.75 A.
-001 2.14 A.
-002 .89 A.
-007 1.12 A.
-006 2.02 A.
-012 1.35 A
-011 1.05 A
-022 1.39 A.
-012 4.08 A.
-034 3.53 A.
-050 1.63 A.
-049 1.26 A.
-045 865.06
-012 .07 A.
-014 .52 A