


WAKEMAN-LAGRANGE-RICHFIELD 35

RD (60)
RD (60)
RD (60)
58

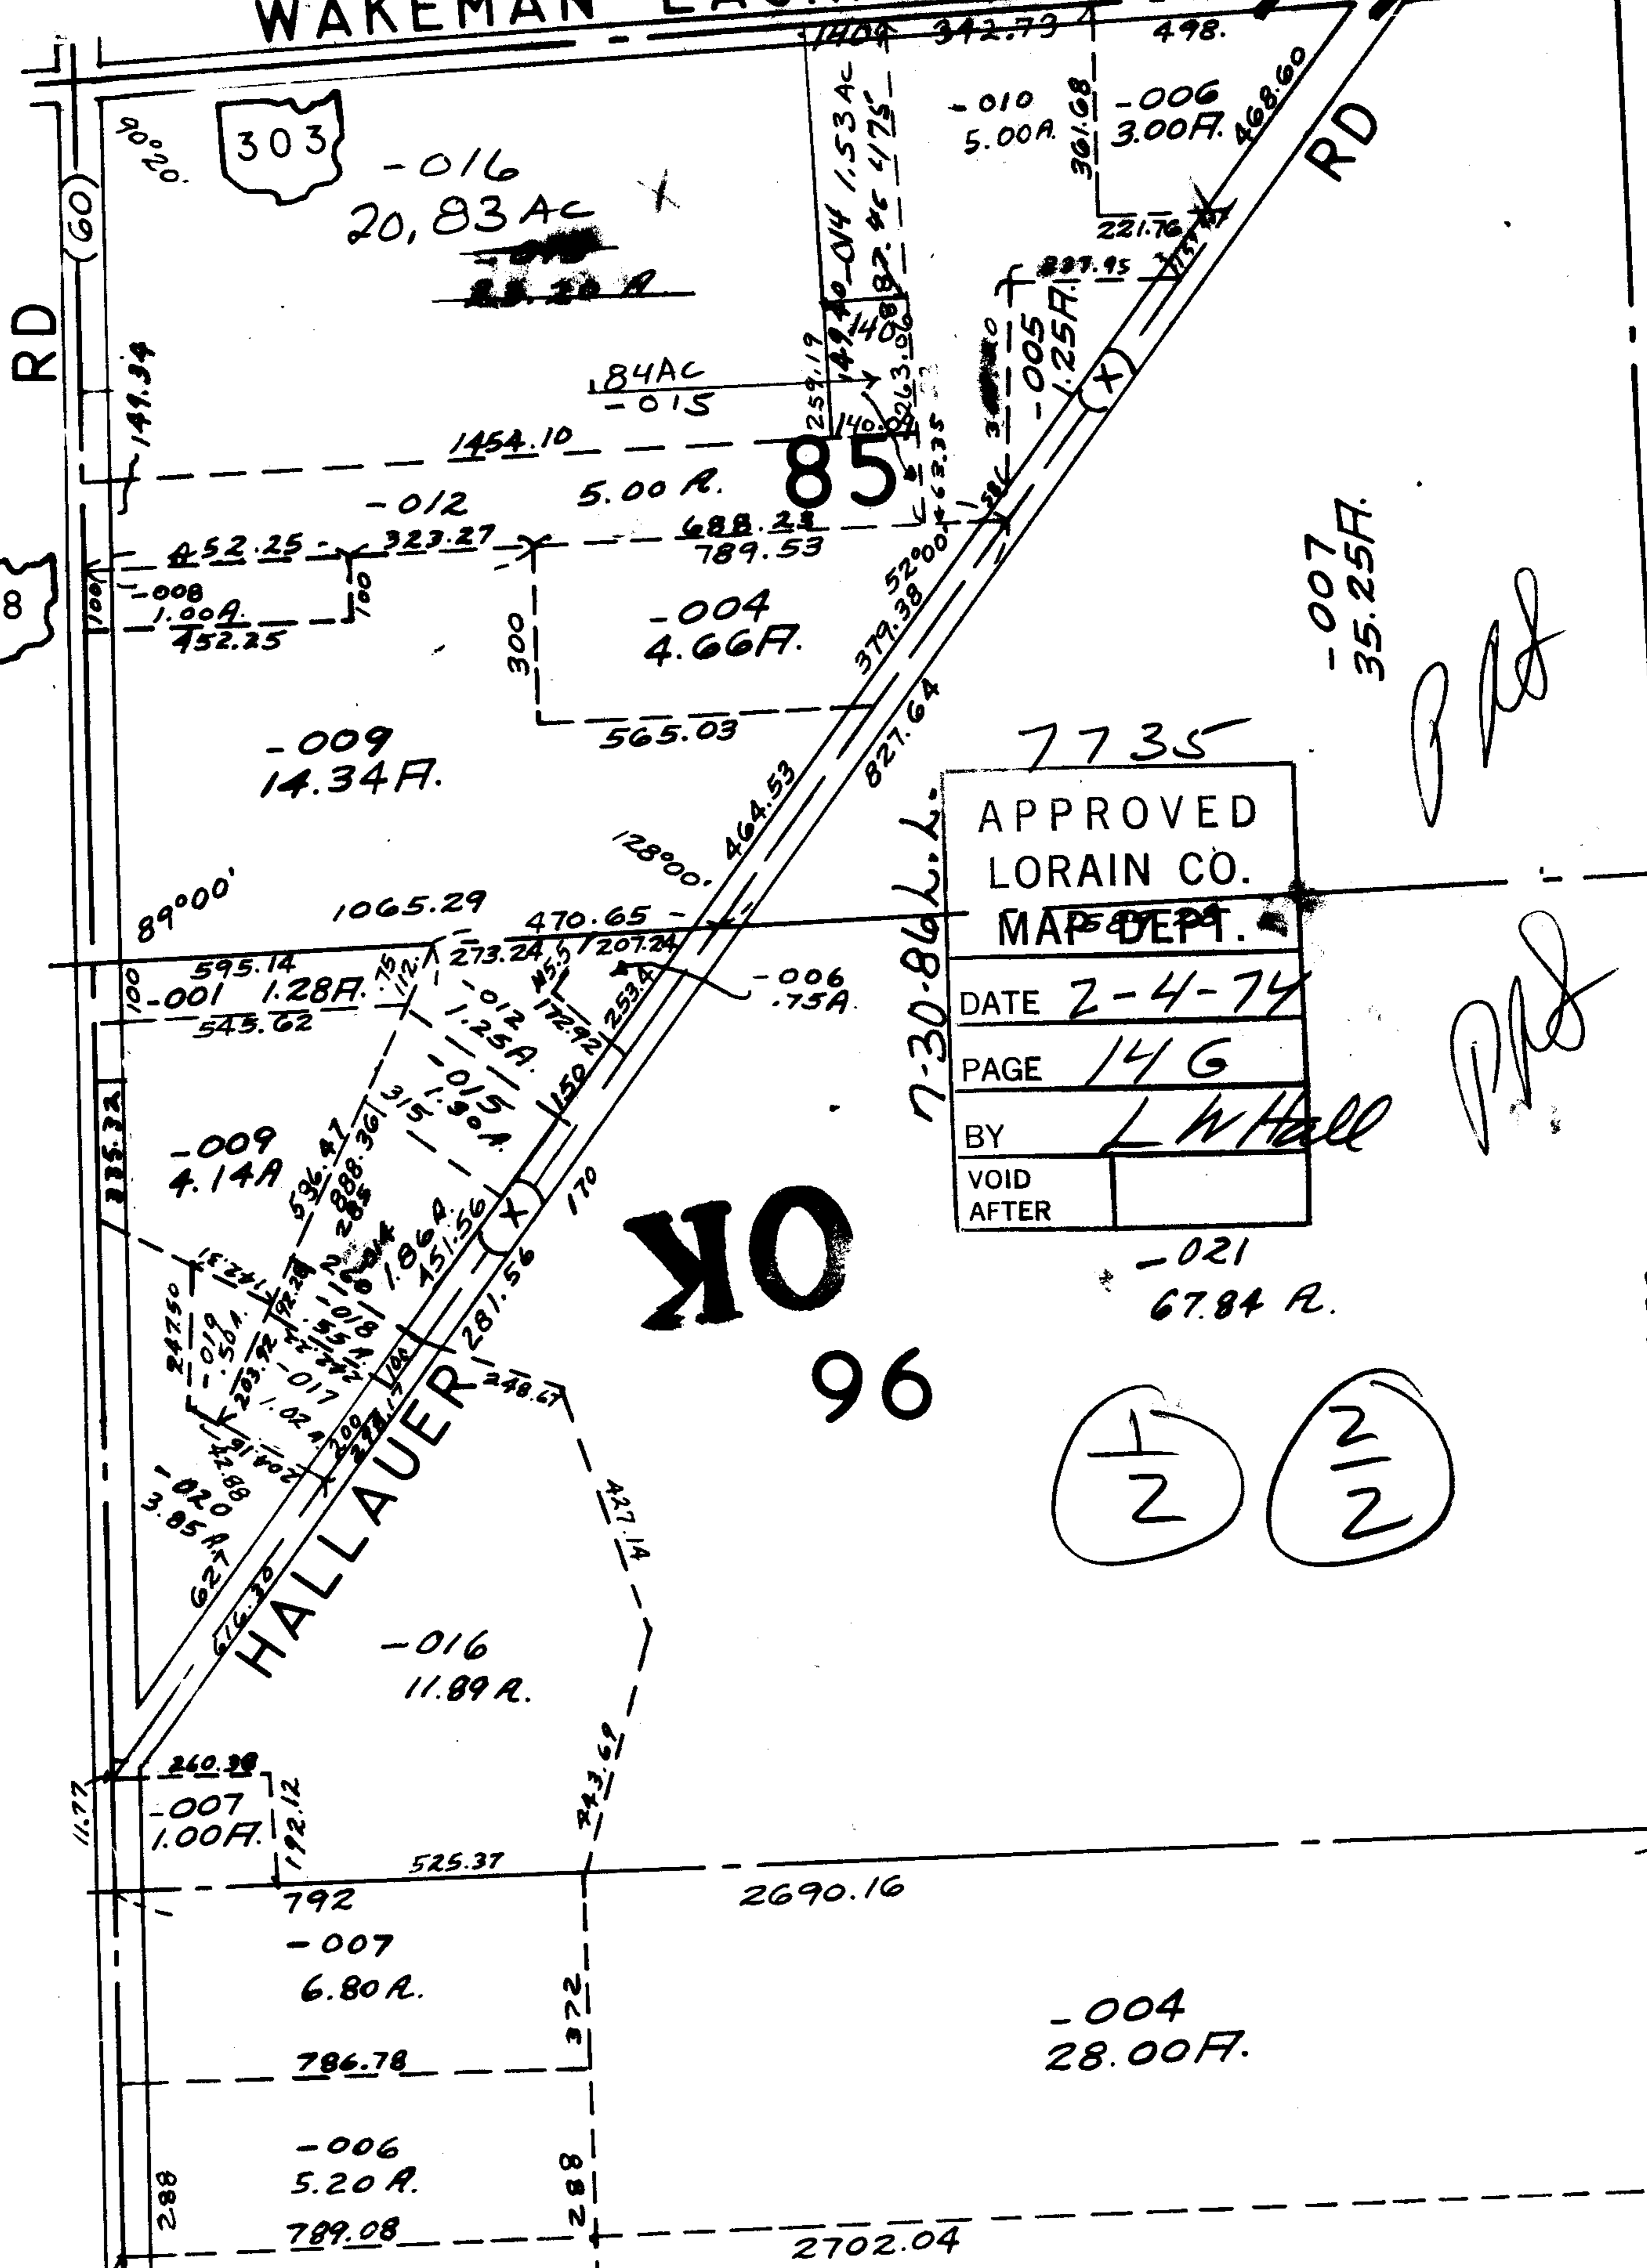

7735

APPROVED
LORAIN CO.
MAP DEPT.
DATE 2-4-74
PAGE 146
BY L W Hall
VOID AFTER

OK
96

1/2 2/2

105