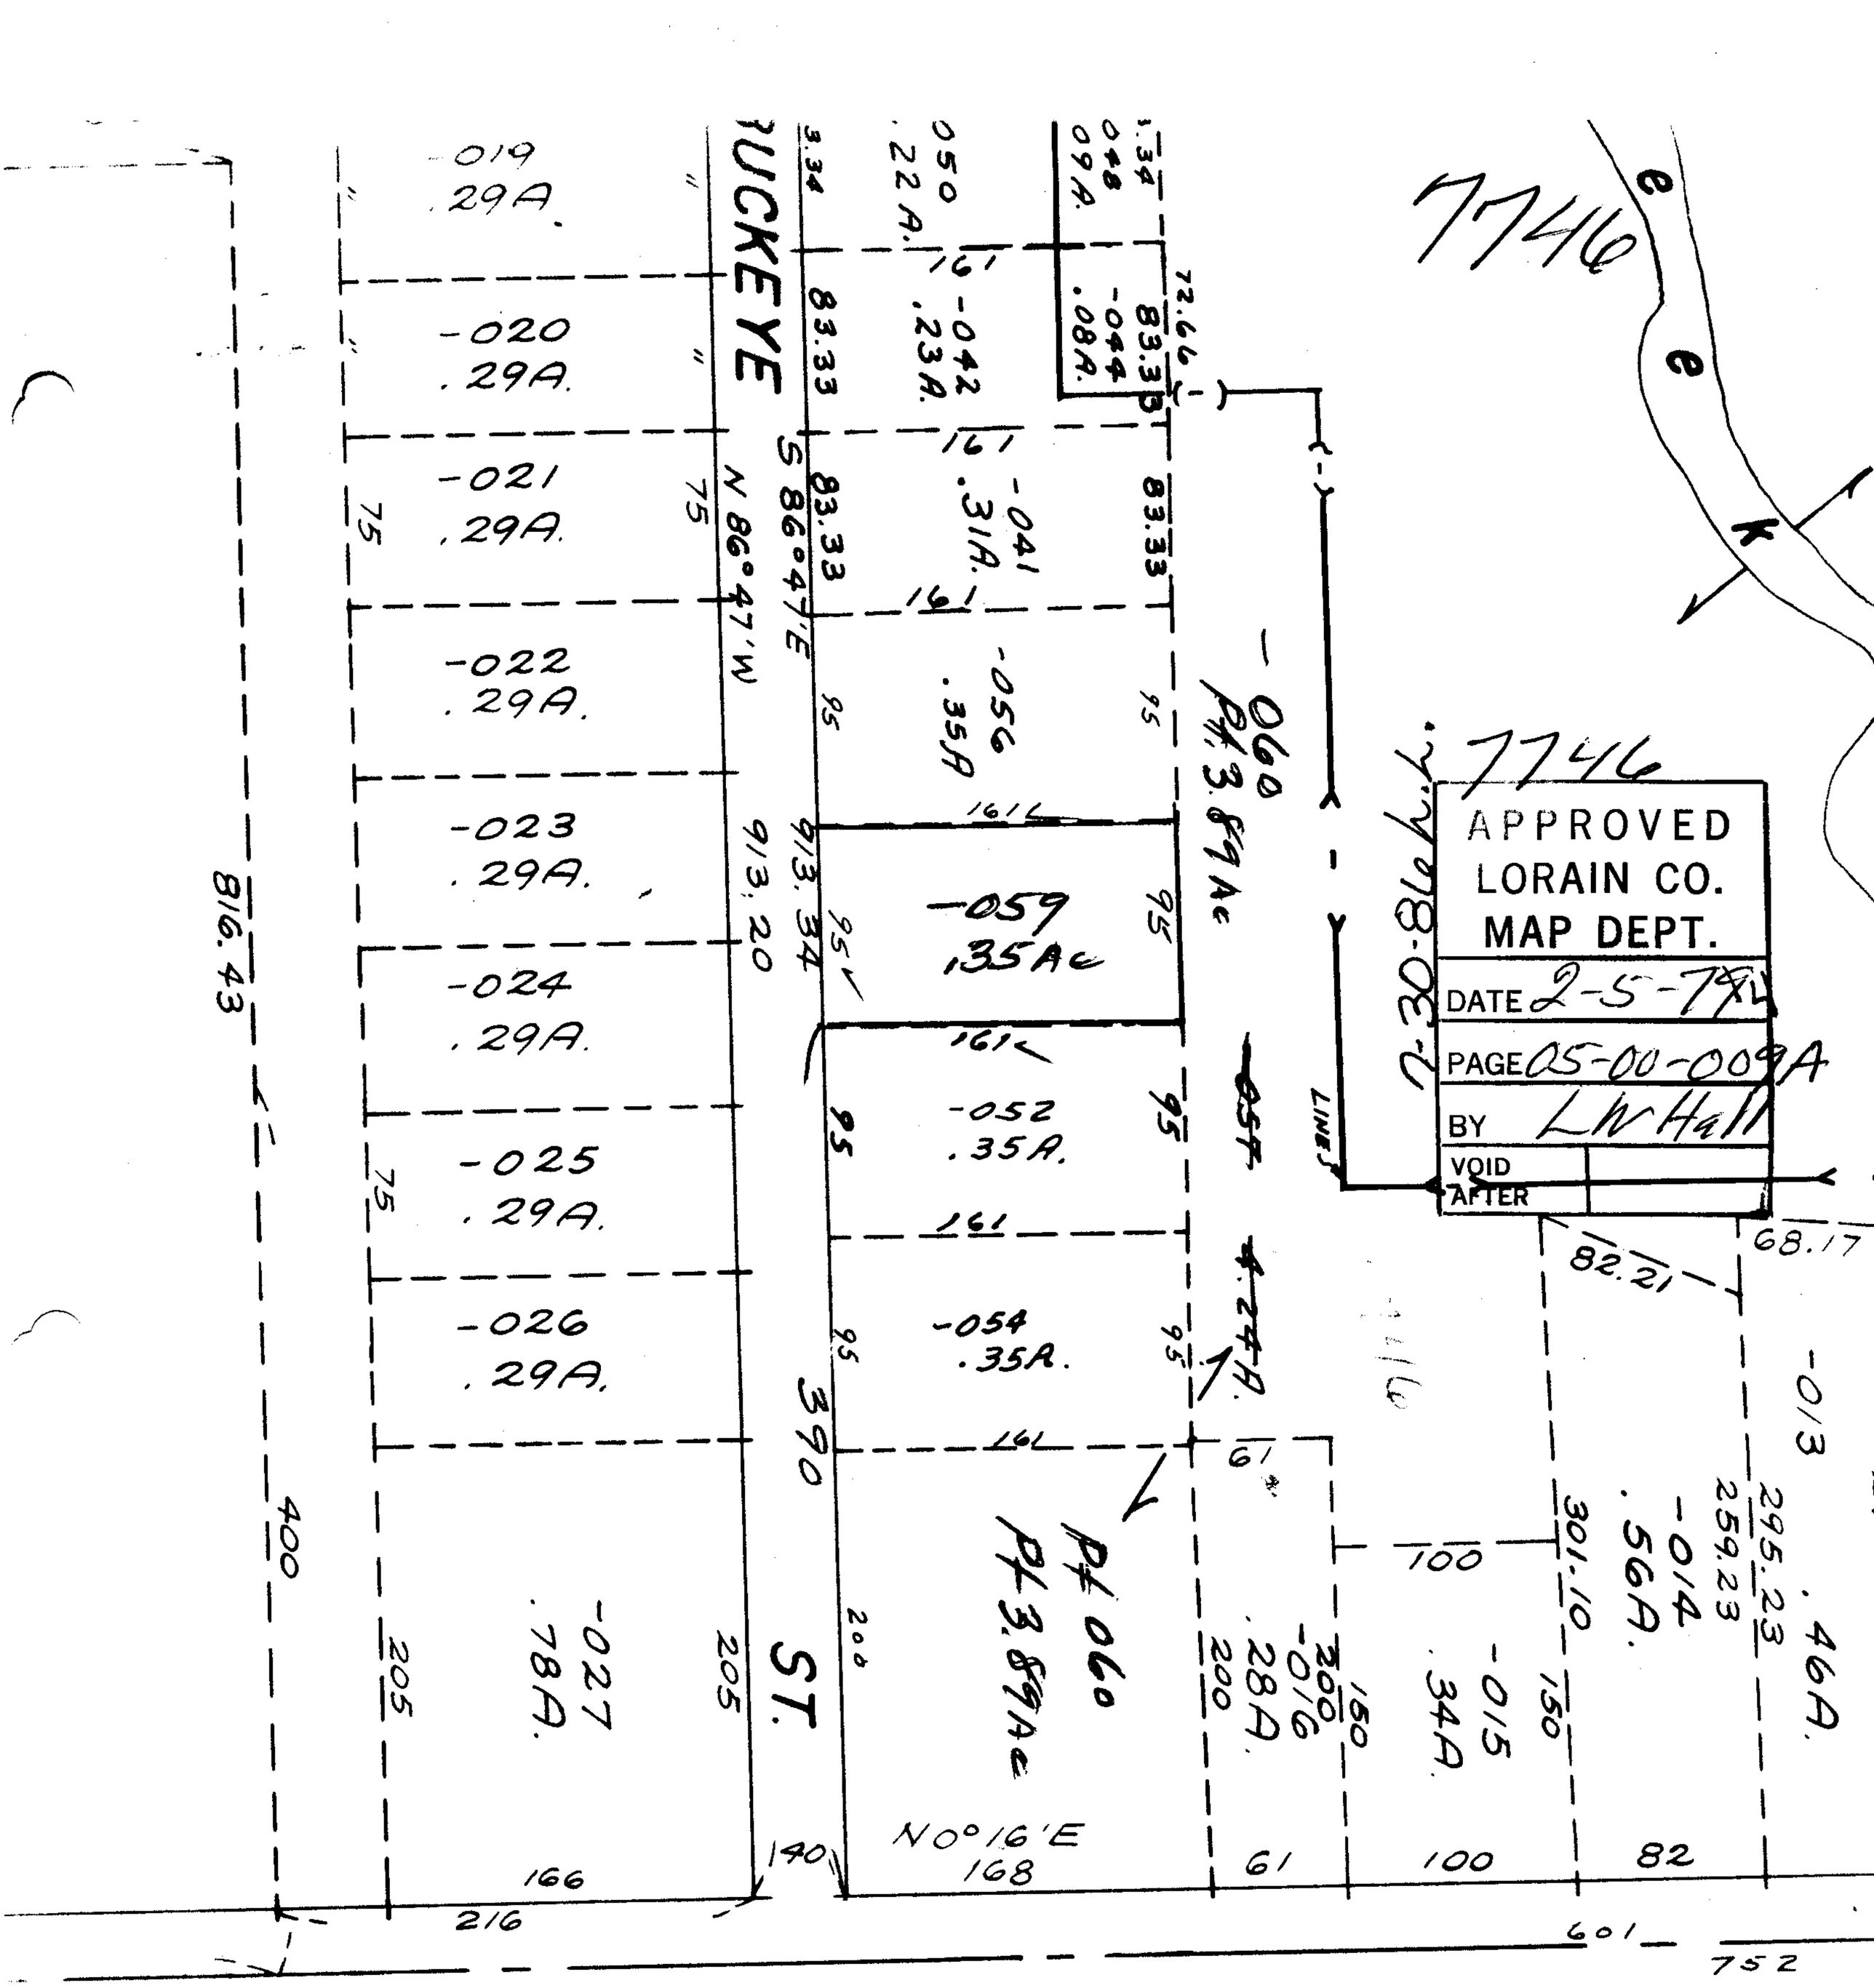
7746
APPROVED
LORAIN CO.
MAP DEPT.
DATE 2-5-74
PAGE 25-00-009A
BY LW Hall
VOID
AFTER
2-30-84 h.r.
7746
-019
.29A.
-020
.29A.
-021
.29A.
-022
.29A.
-023
.29A.
-024
.29A.
-025
.29A.
-026
.29A.
-027
.78A.
816.43
400
205
75
216
166
ST.
913.20
913.34
390
140
200
N 86°47'E
83.33
83.34
83.33
95
95
95