

7751-7755+
7756

7751 77


COOPER FOSTER PARK

Co. Comm. Res 68-1010

254

977

677

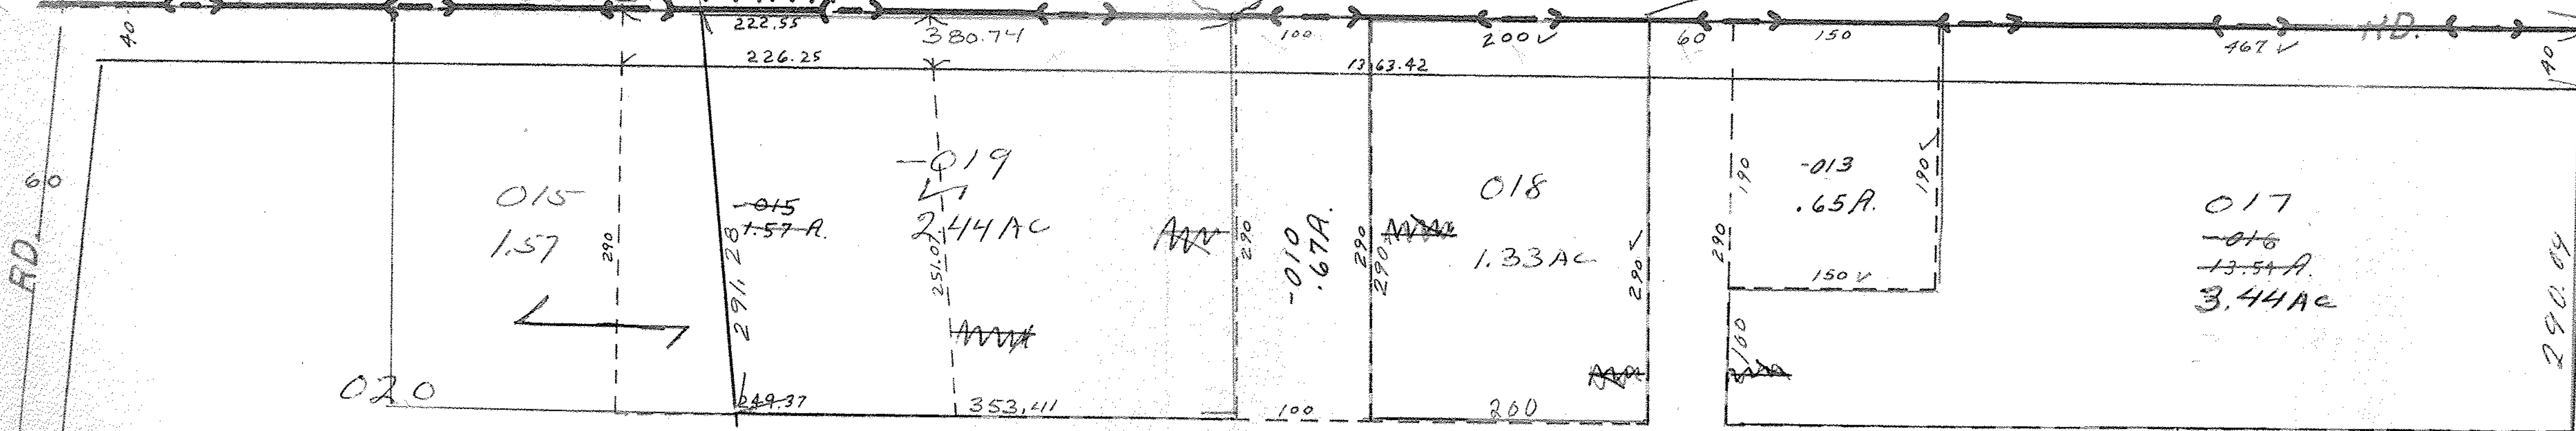

7.96 AC
6.33
-016
13.54 A.

7.90
-1.57
9.47


OK

-011
31.75 A.

7.90
-1.57
6.33

110

SEE 5-00-041-A

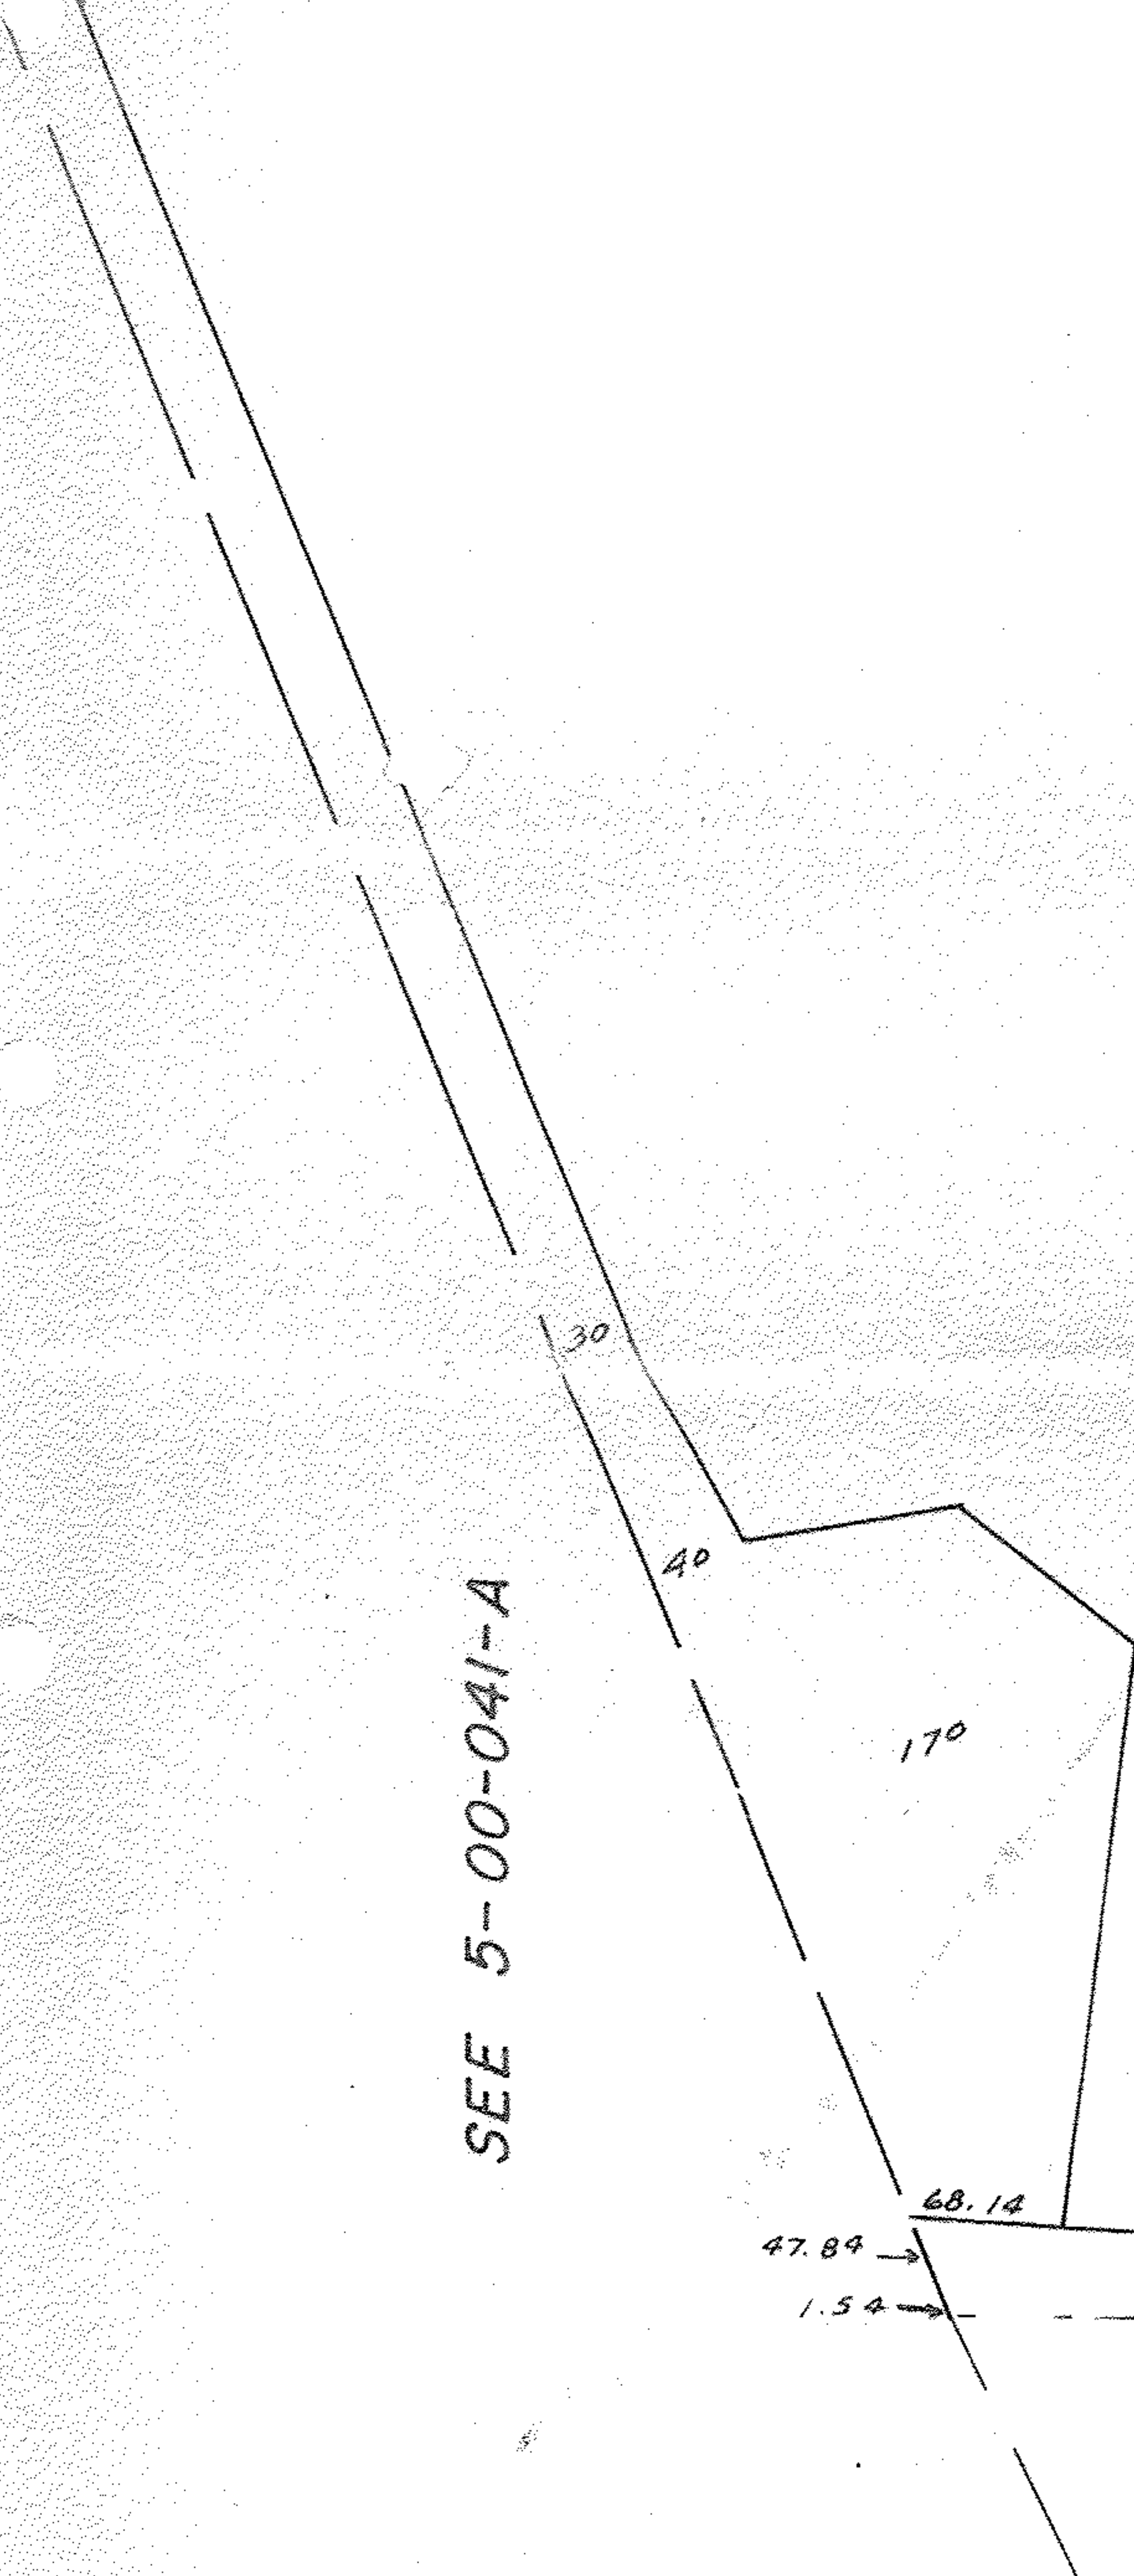

-004 .39A. 690.14 143.59 509.44

INTERSECT