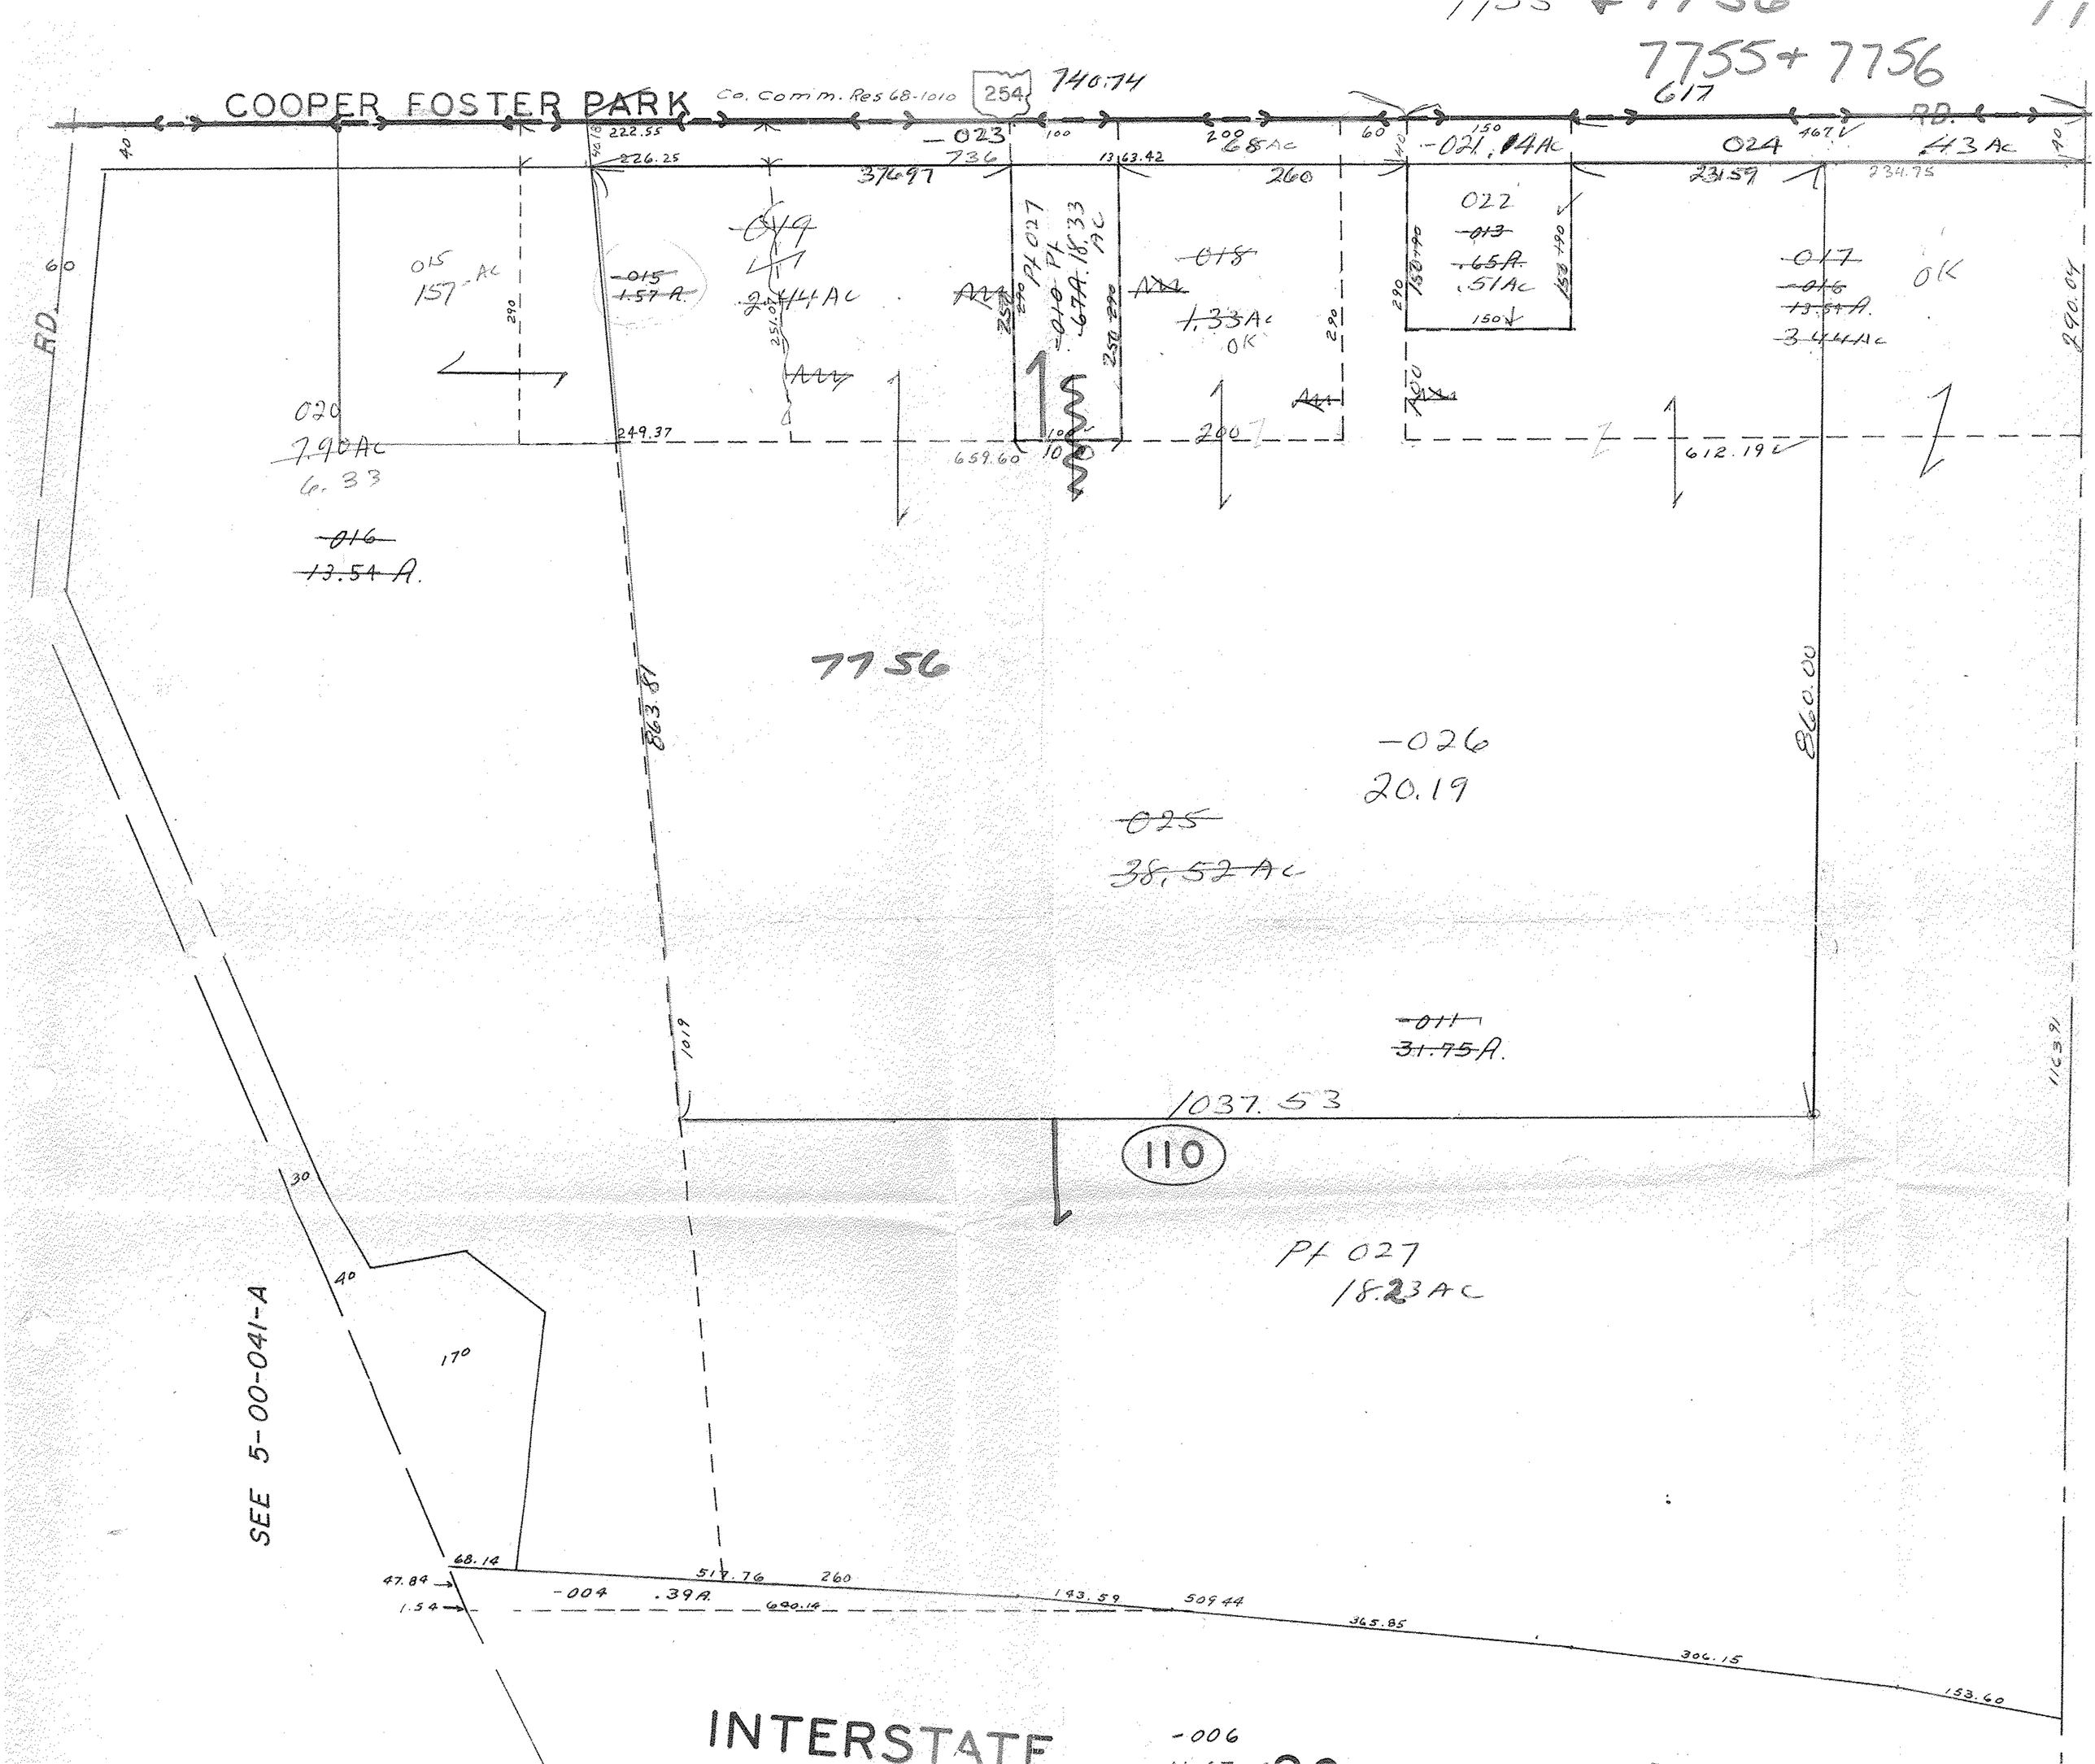

7755+7756
COOPER FOSTER PARK
Co. Comm. Res 68-1010
254
740.74
617
RD.
-023
736
37697
13.63.42
68 Ac
260
-021 .14 Ac
024
.43 Ac
231.59
234.75
222.55
226.25
022
~~013~~
~~.65 A.~~
.51 Ac
~~017~~
~~016~~
~~13.54 A.~~
~~3.44 Ac~~
OK
015
157 Ac
~~015~~
~~1.57 A.~~
~~019~~
~~2.44 Ac~~
Pt 027
~~010~~ Pt
~~.67 A.~~ 18.33 Ac
~~018~~
~~1.33 Ac~~
OK
020
~~7.90 Ac~~
6.33
~~016~~
~~13.54 A.~~
249.37
659.60
612.19
290.04
7756
863.81
860.00
-026
20.19
~~025~~
~~38.52 Ac~~
~~011~~
~~31.75 A.~~
1037.53
110
Pt 027
18.23 Ac
SEE 5-00-041-A
170
68.14
47.84
1.54
-004
.39 A.
517.76
260
640.14
143.59
509.44
365.85
306.15
153.60
INTERSTATE
-006