


7765

COOPER FOSTER PARK

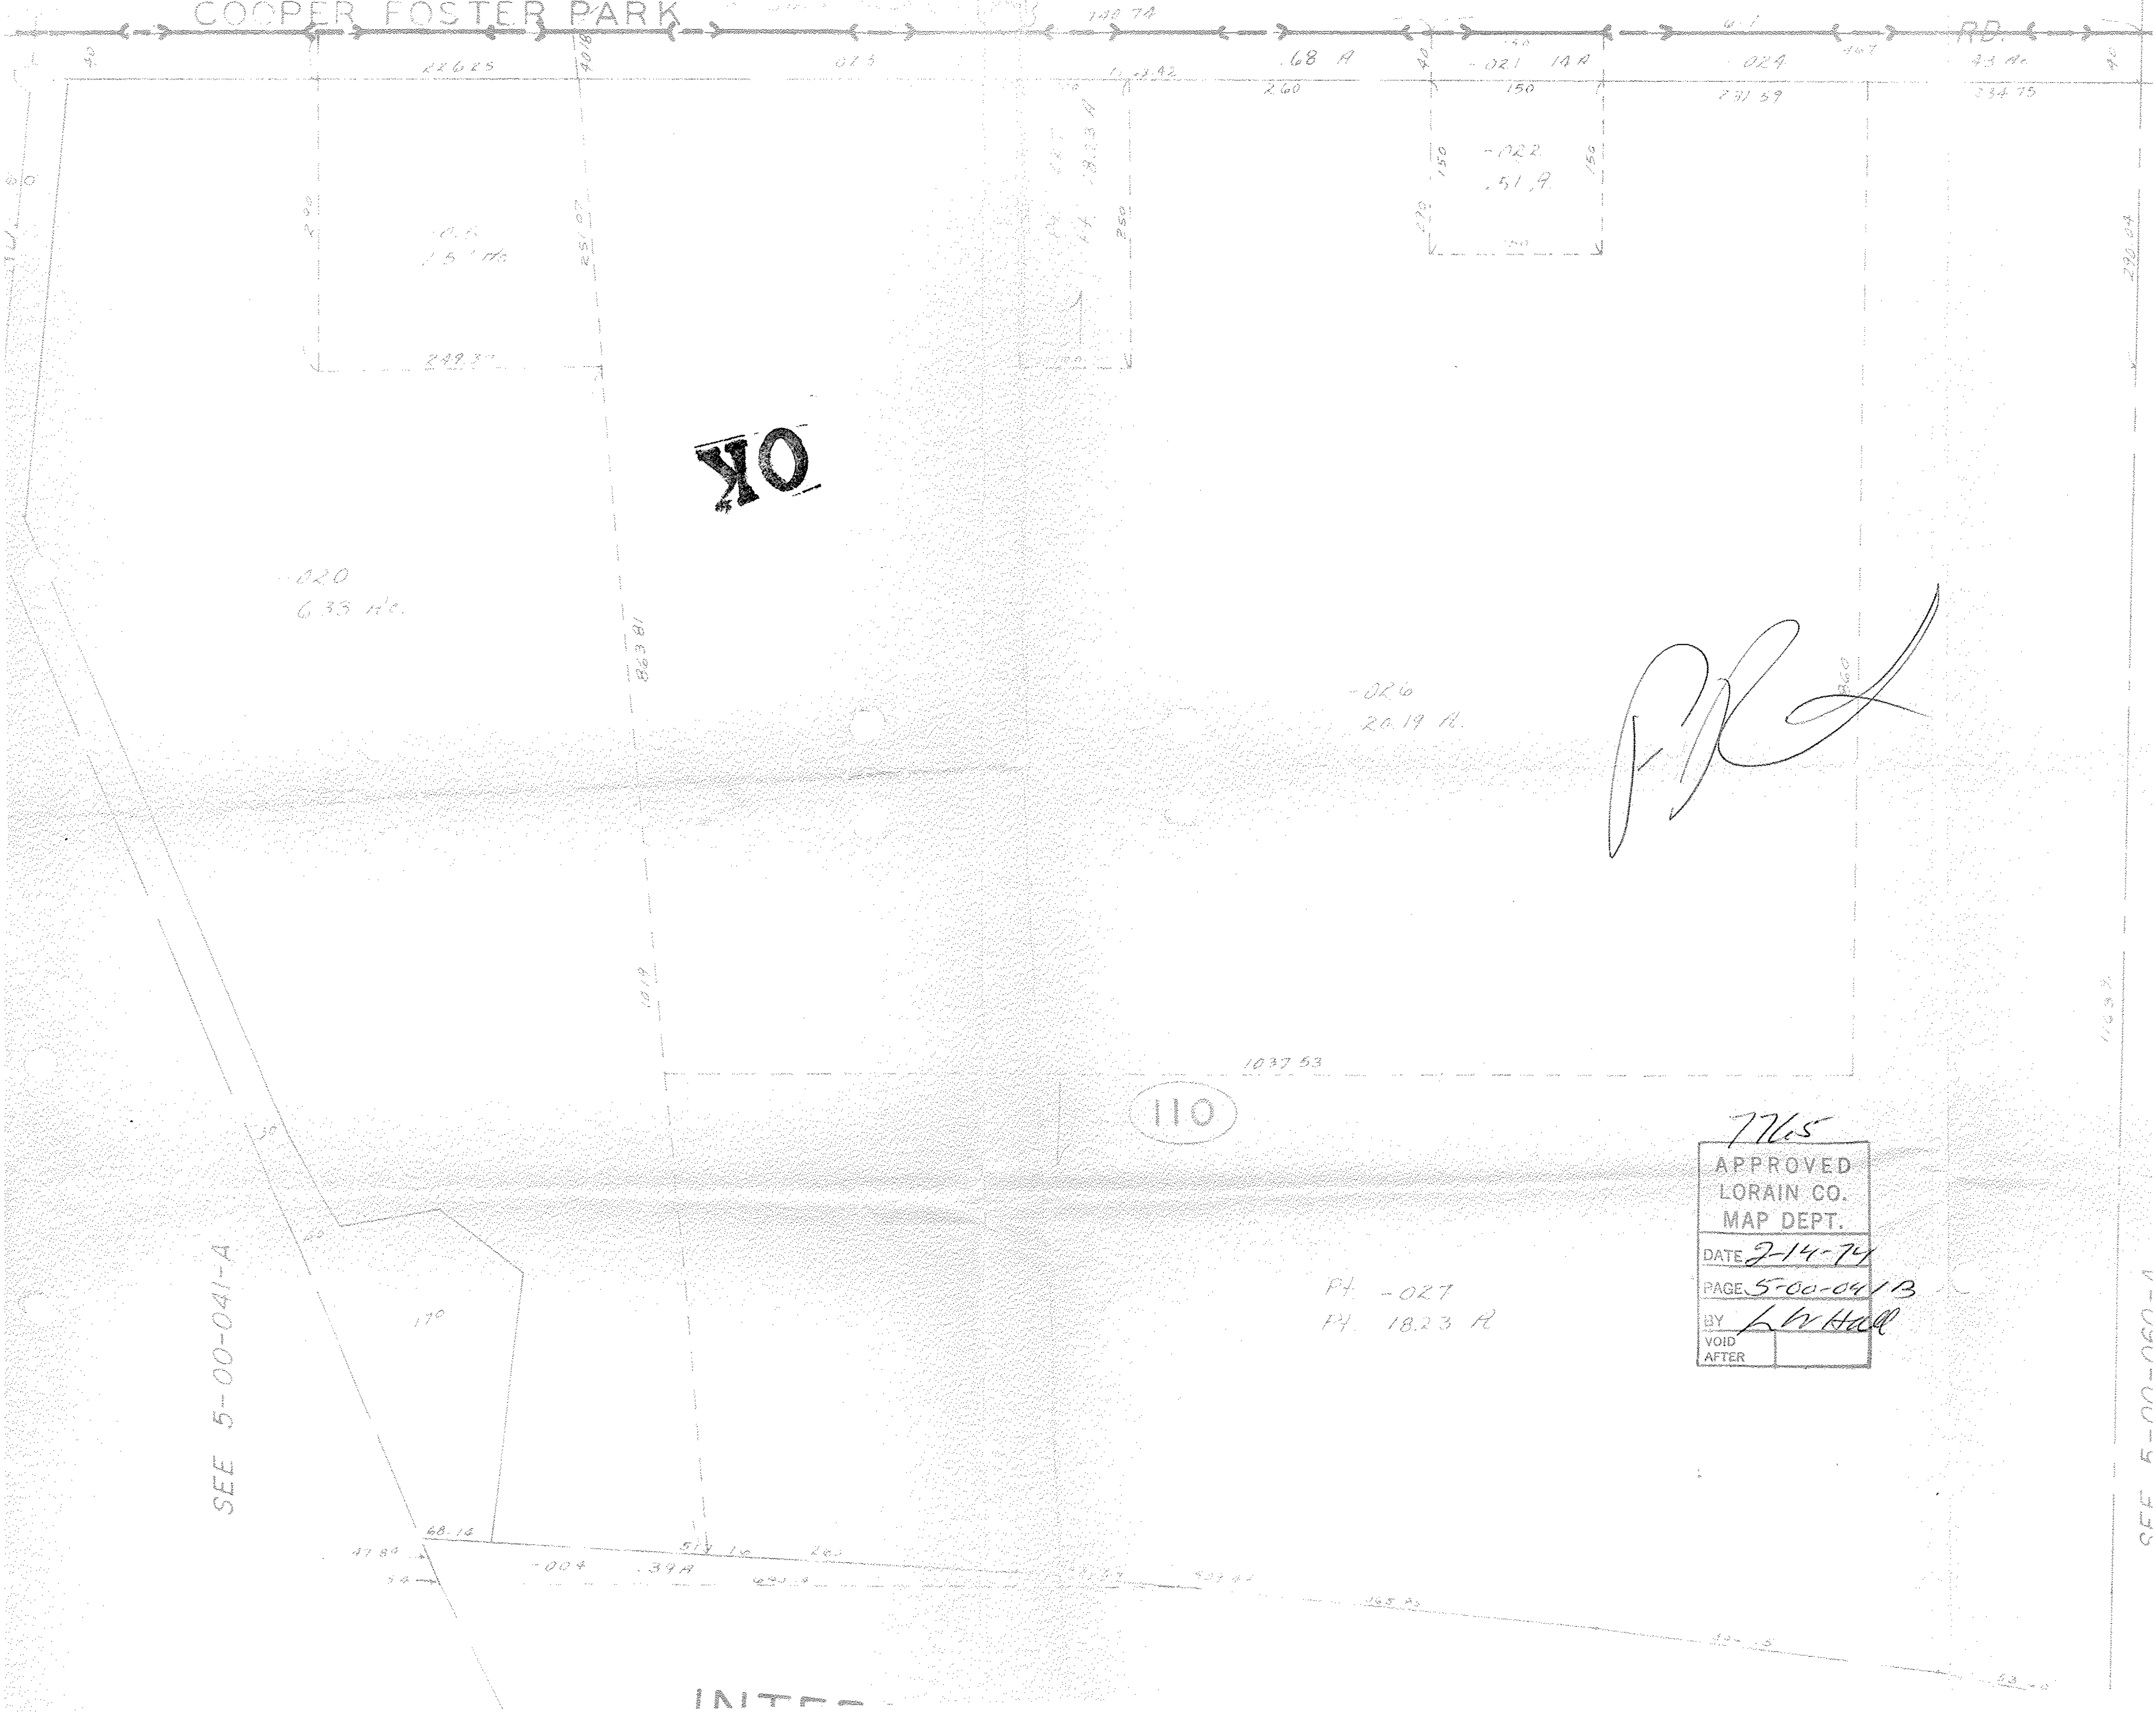

OK

PK

110

7765

APPROVED
LORAIN CO.
MAP DEPT.
DATE 2-14-74
PAGE 5-00-041B
BY L. W. Hall
VOID
AFTER

Pt. -027
Pt. 18.23 Ac.

SEE 5-00-041-A

SEE 5-00-060-A

INTER