


7778

Pt. - 024
Pt. 12.63 R.


OK

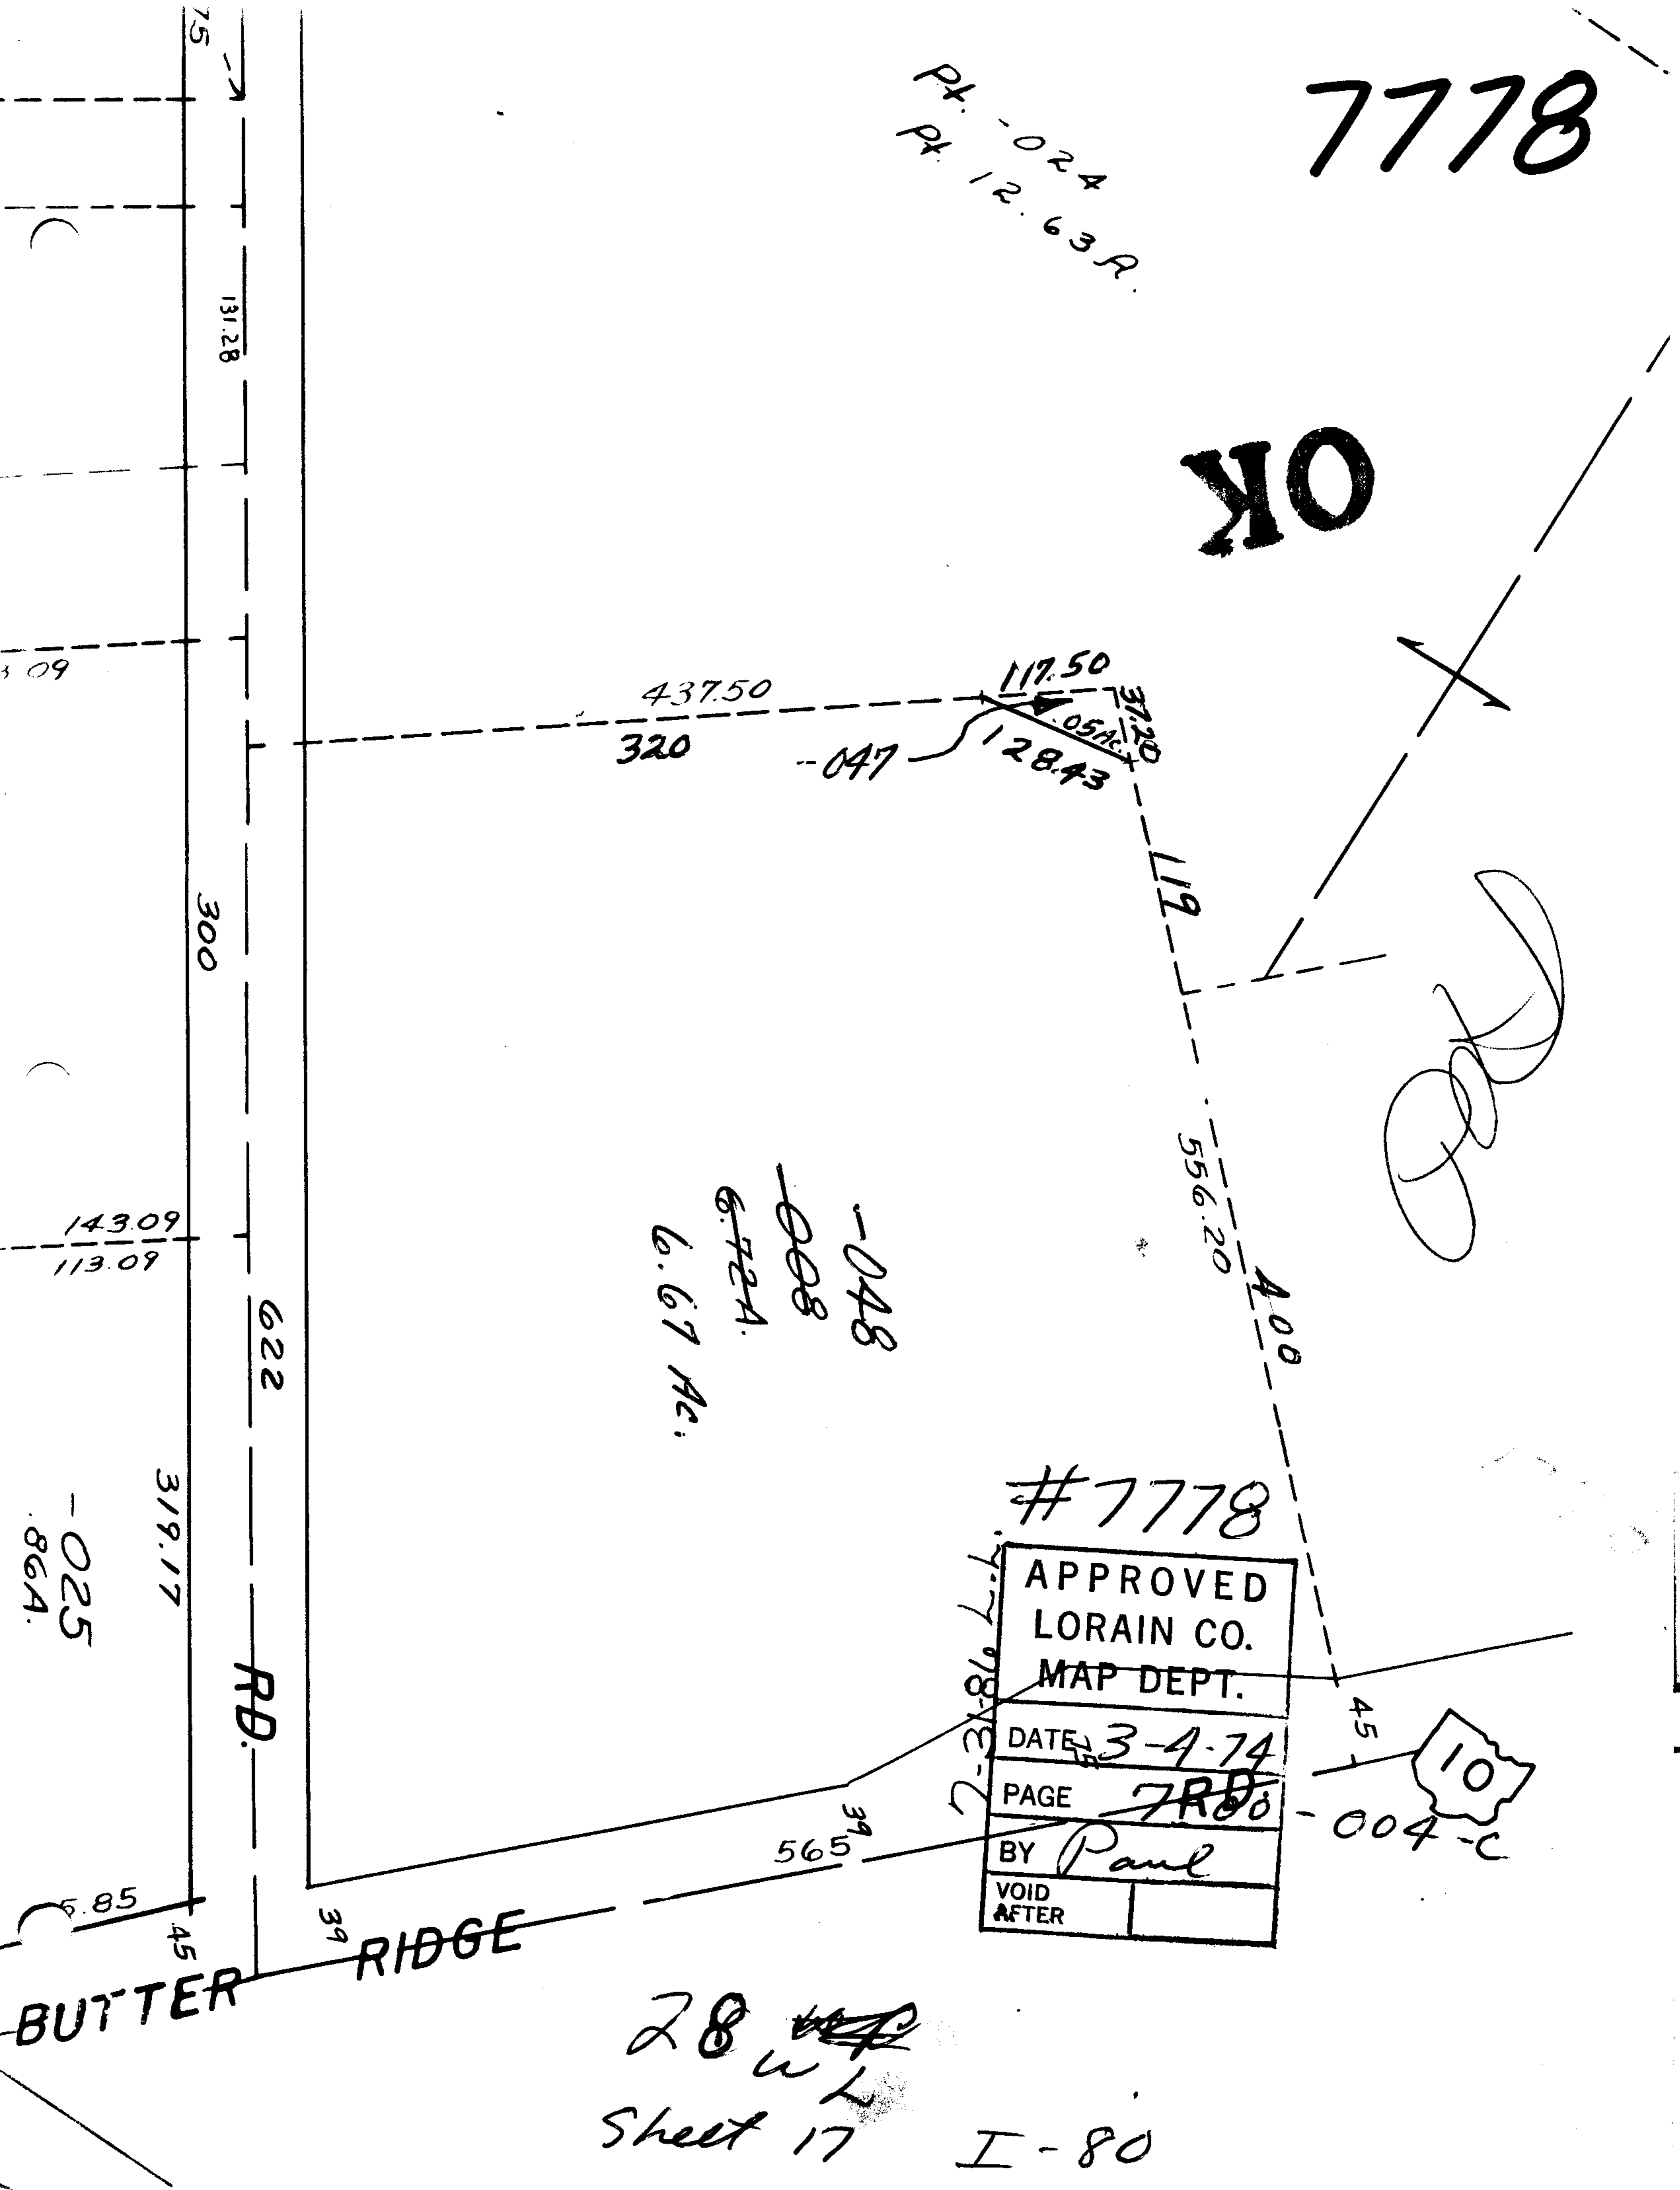

-048
-008
6.724.
6.67 Ac.

#7778

APPROVED LORAIN CO. MAP DEPT.	
DATE	3-4-74
BY	Paul
VOID AFTER	

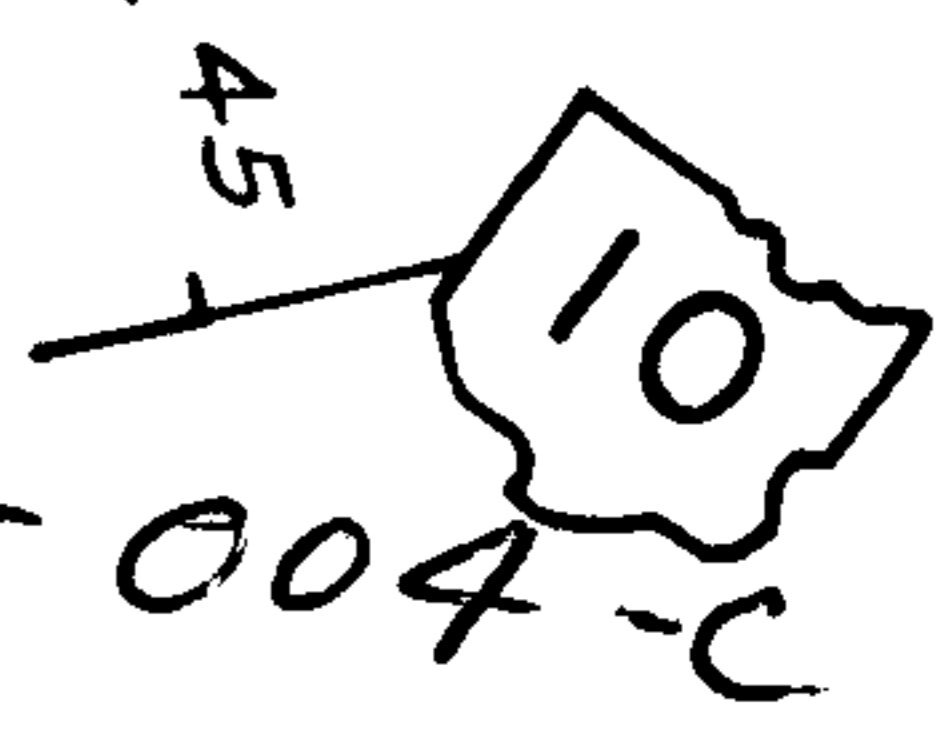

28 ~~map~~
Sheet 17 I-80