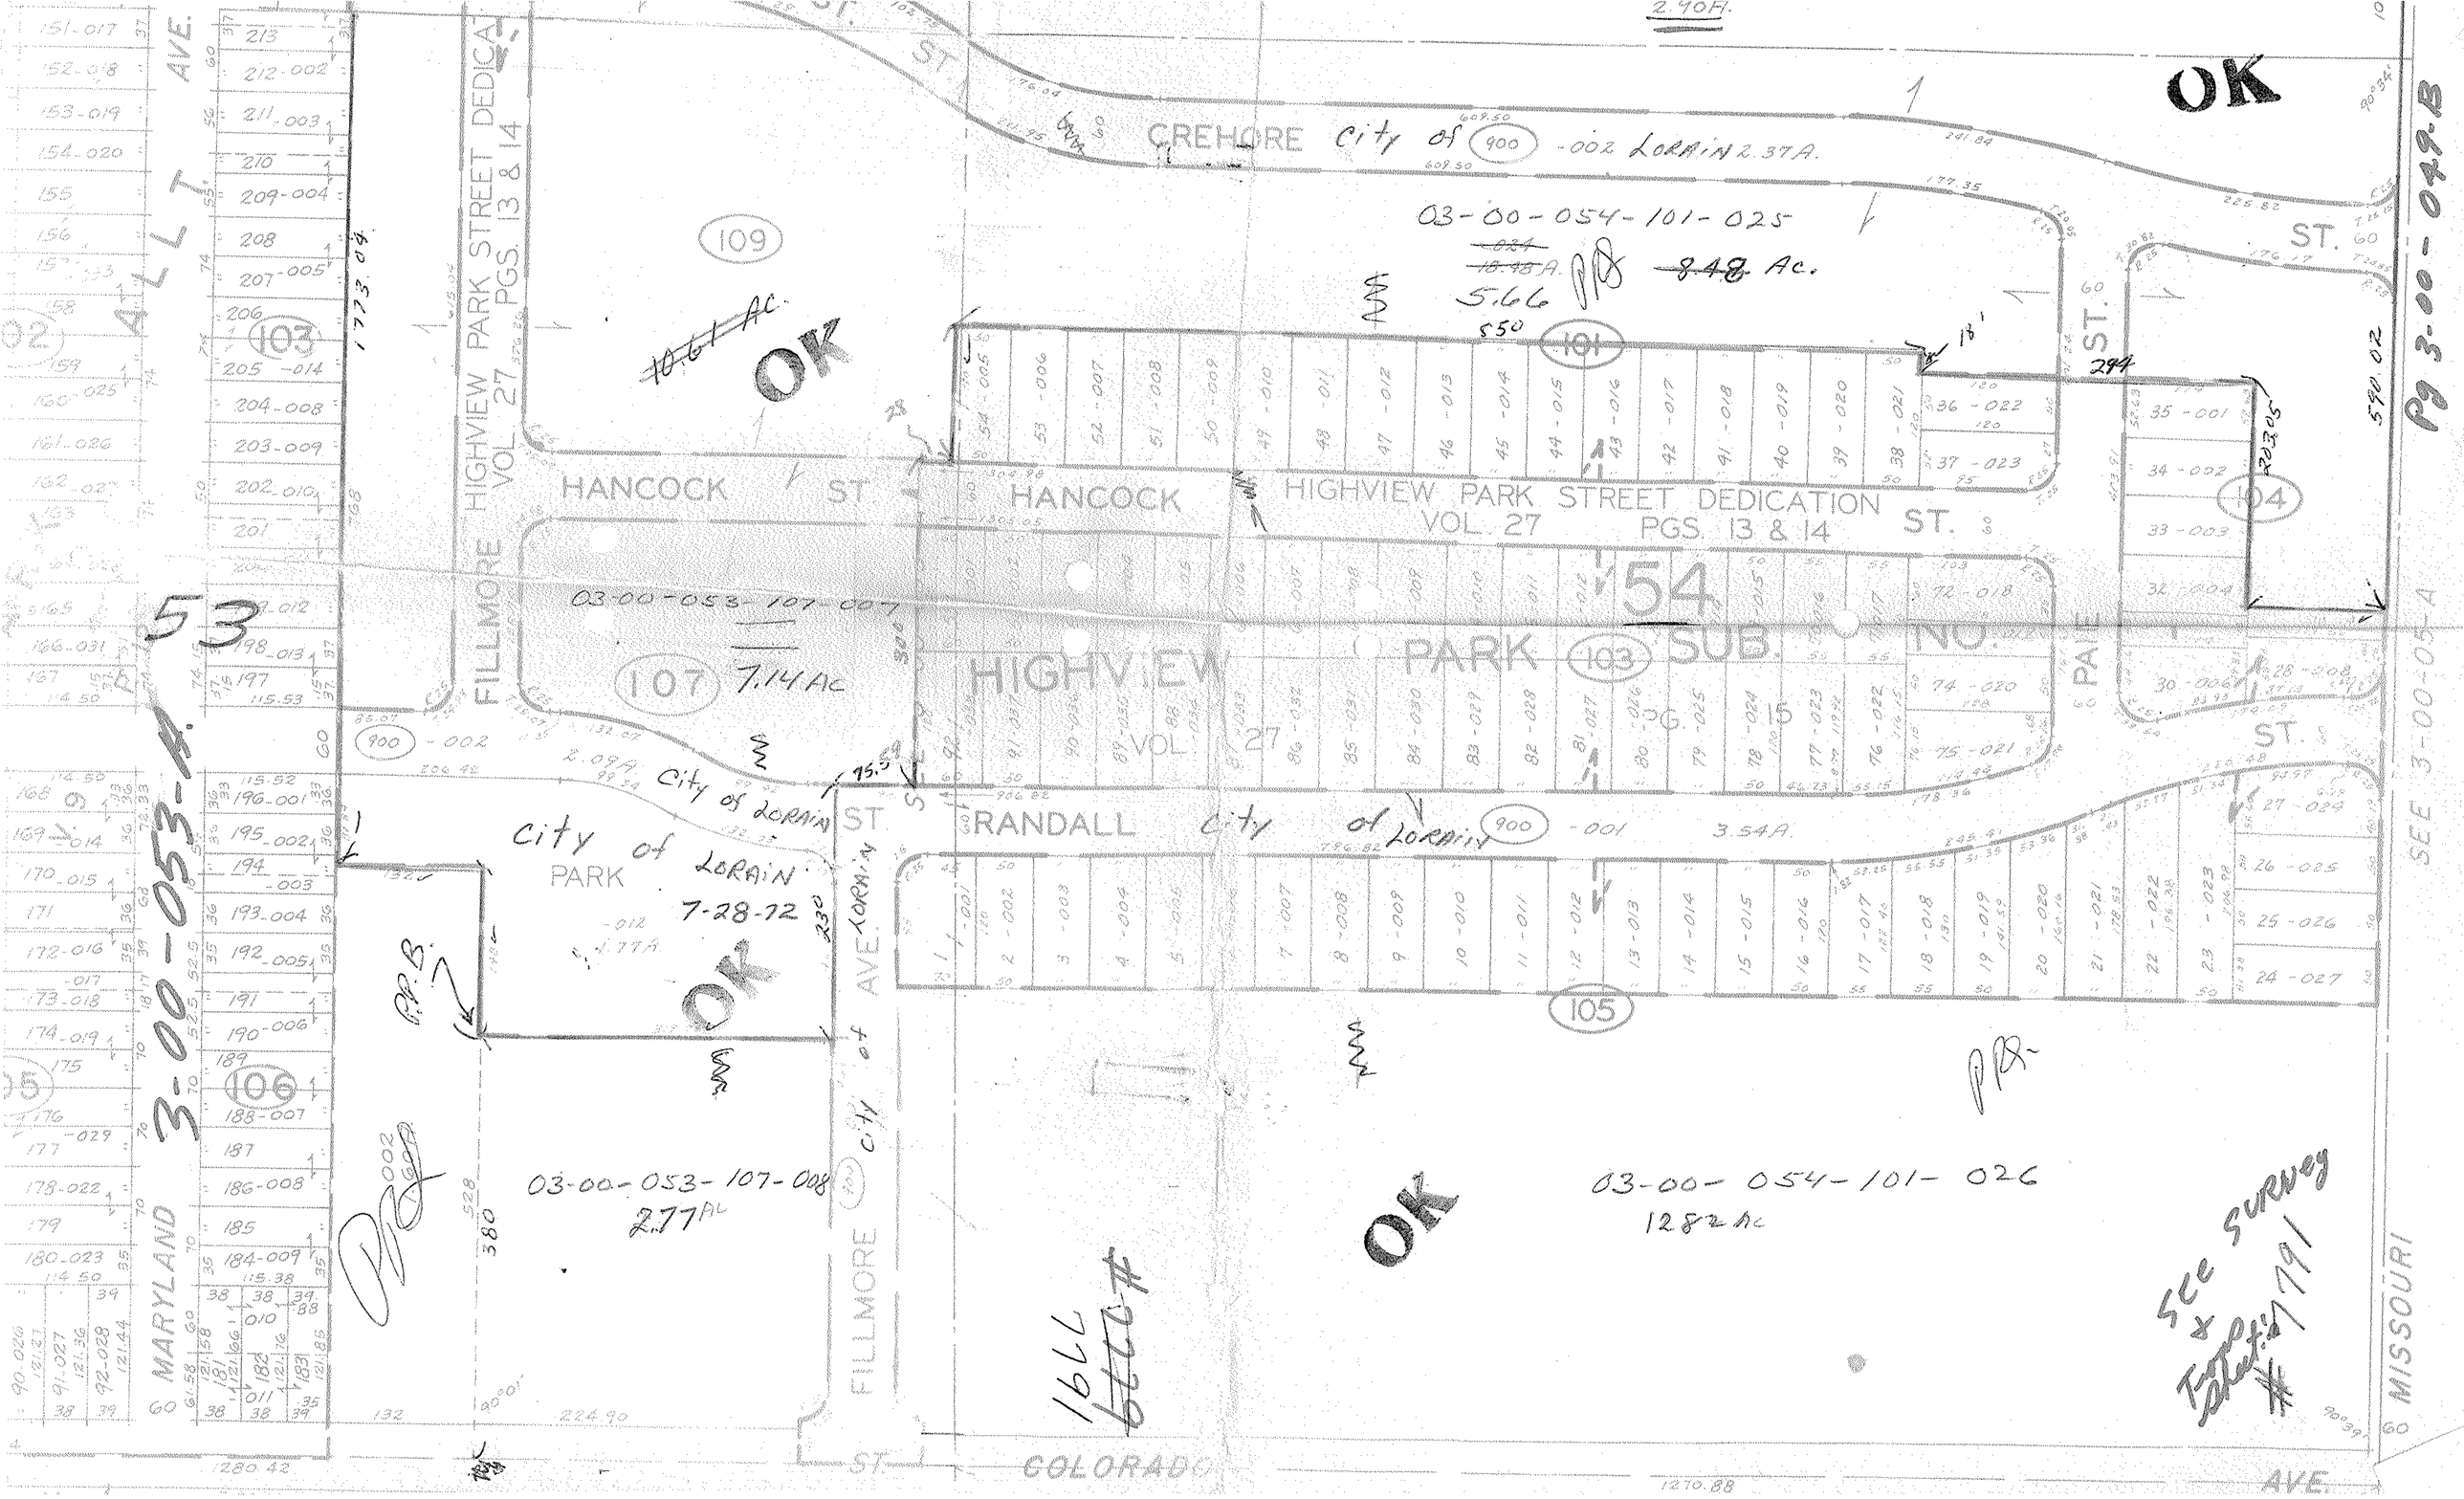

OK
CREHORE
City of 900 -002 LORAIN 2.37A.
03-00-054-101-025
5.66
8.48 Ac.
109
10.61 Ac.
OK
101
HANCOCK ST
HANCOCK
HIGHVIEW PARK STREET DEDICATION
VOL. 27 PGS. 13 & 14
ST.
104
03-00-053-107-007
7.14 Ac
107
54
HIGHVIEW PARK SUB. NO.
103
PG. 15
VOL. 27
ST.
53
FILLMORE
HIGHVIEW PARK STREET DEDICATION
VOL. 27 PGS. 13 & 14
ALLT. AVE.
900 -002
2.09A.
City of LORAIN
City of LORAIN
7-28-72
PARK
ST
RANDALL
City of LORAIN 900 -001 3.54A.
105
OK
106
03-00-053-107-008
2.77 Ac
FILLMORE
City of LORAIN
AVE.
03-00-054-101-026
1282 Ac
OK
MARYLAND
3-00-053-A
SEE 3-00-05-A
Pg 3-00-049-B
MISSOURI
AVE.
COLORADO
ST.
SEE SURVEY & Trans Sheet #1791