

#7794


APPROVED
LORAIN CO.
MAP DEPT.
DATE 3-1-74
PAGE 4-00-019-LS
BY Paul
VOID AFTER

7-31-86 L.H.

112

PR.

4-00-019-B

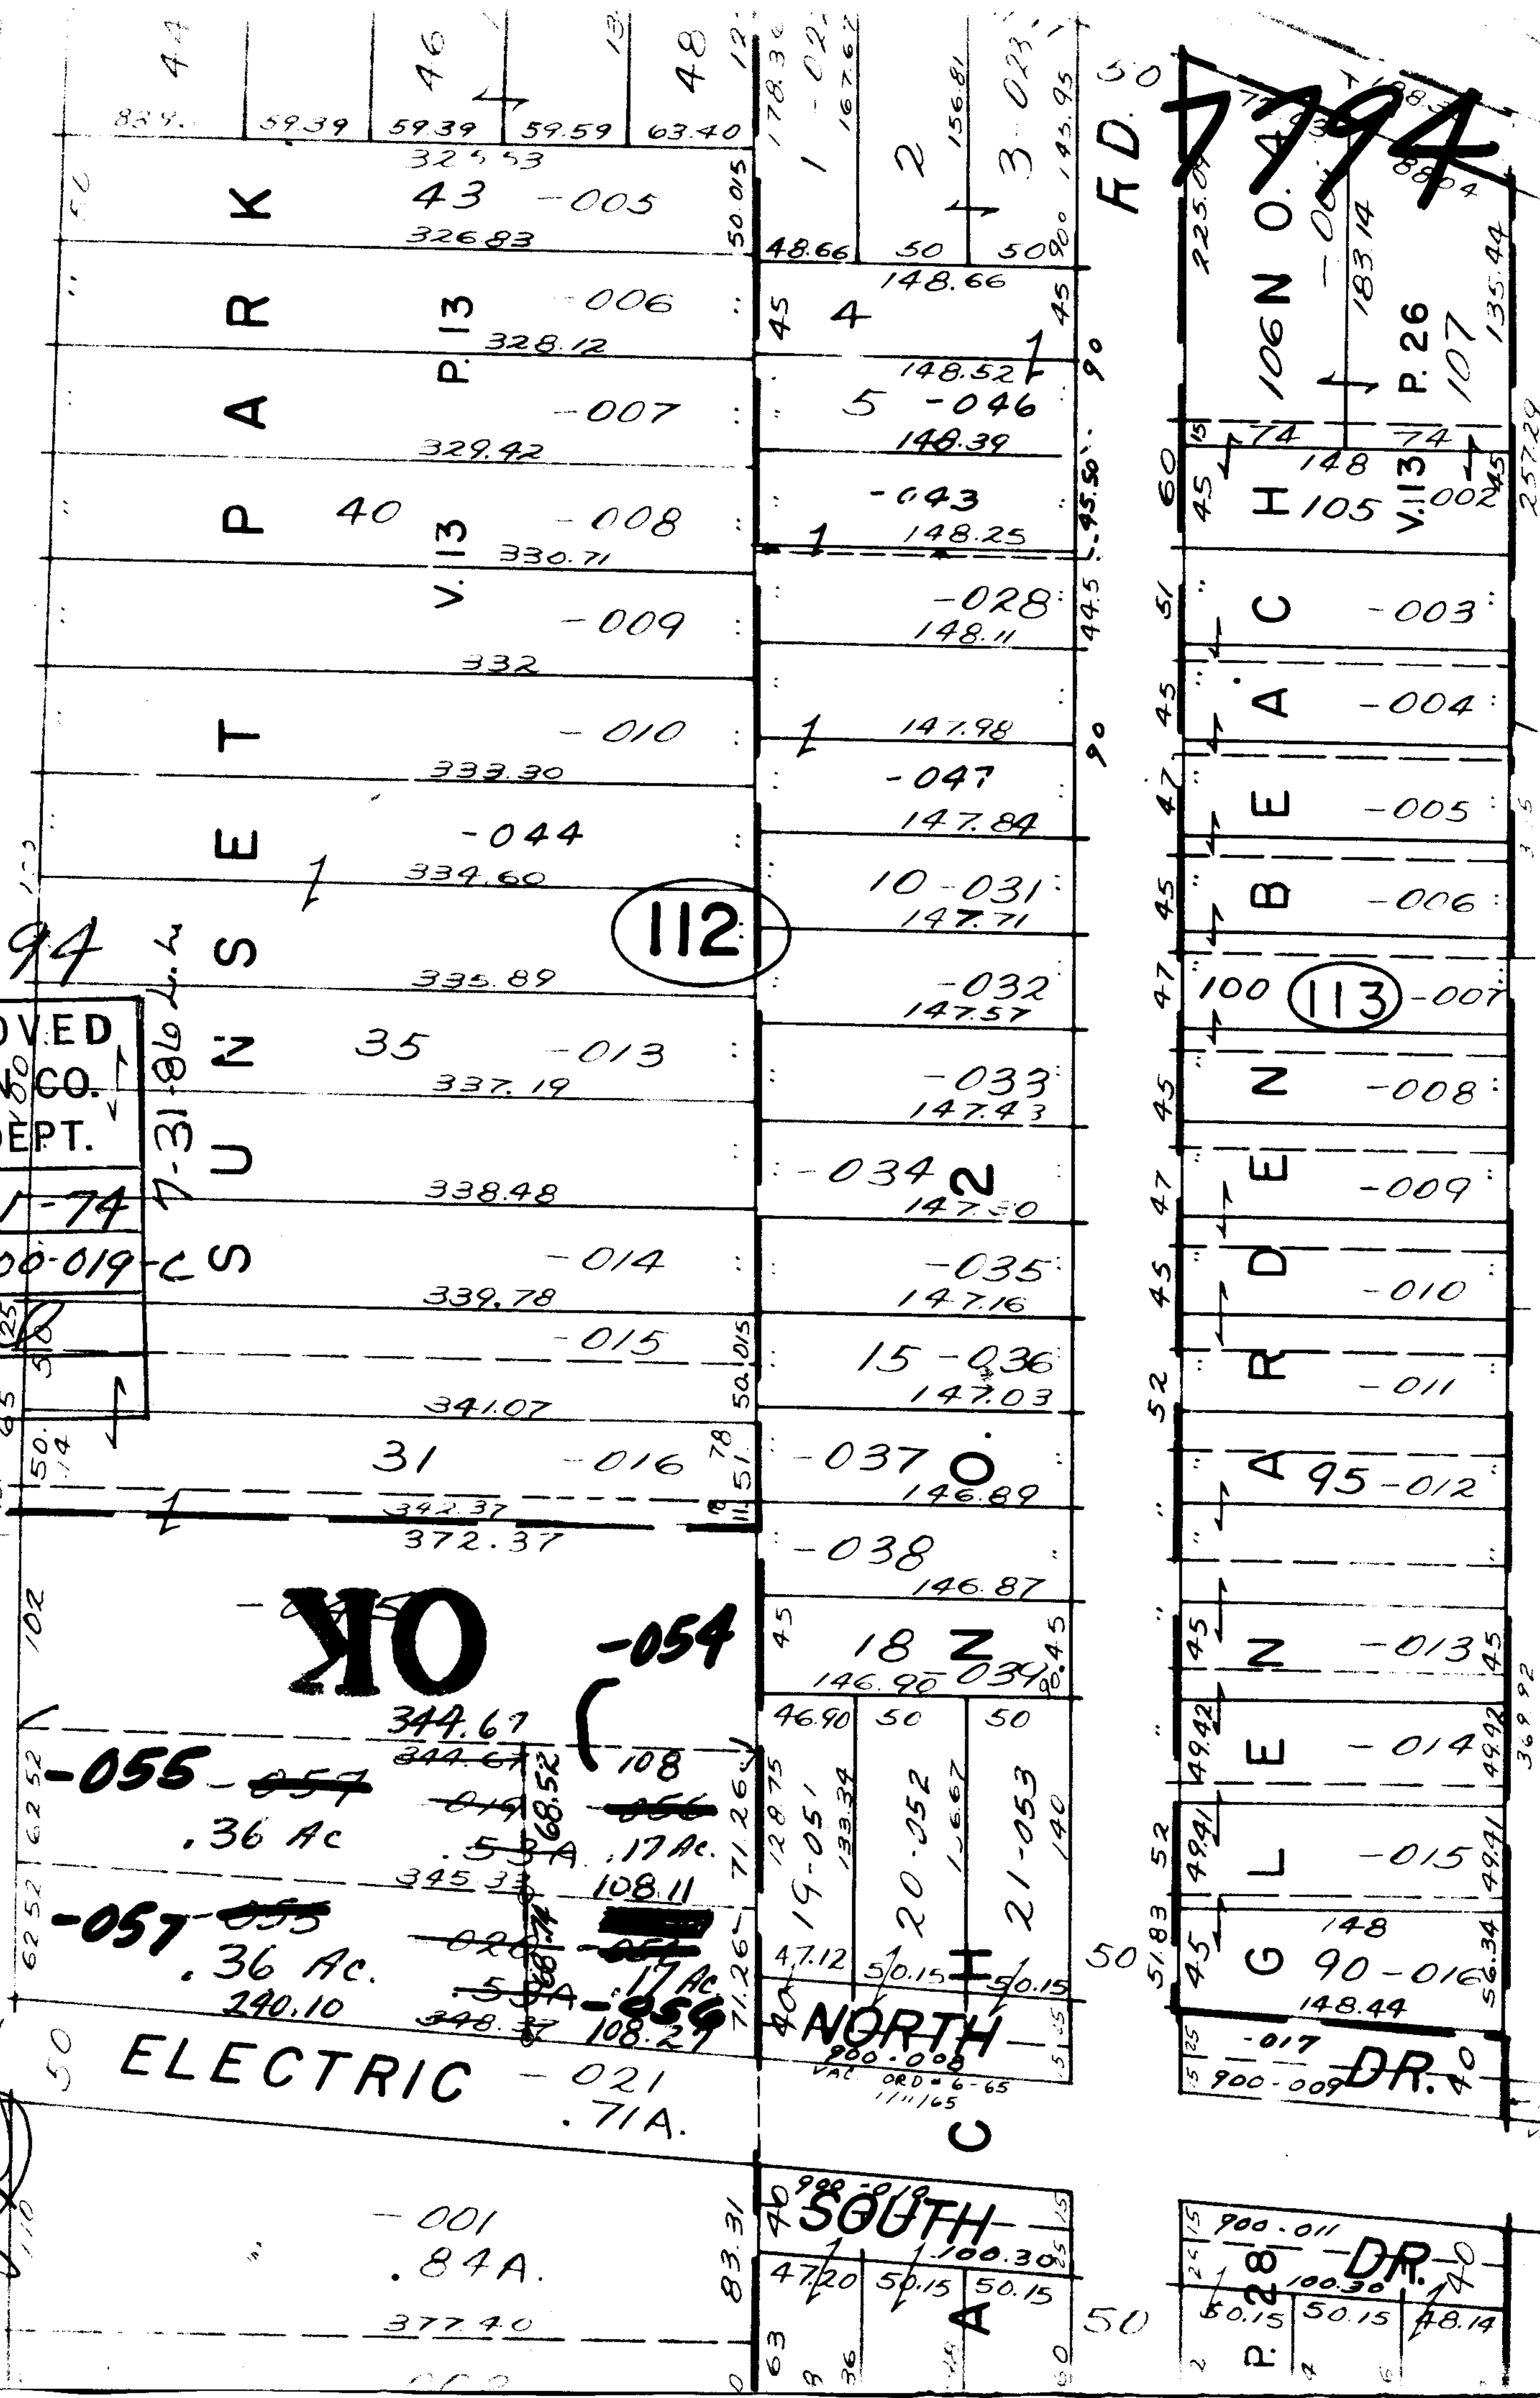

FD. 50

106 N O. 47
P. 26
107
135.44

100 (113) -007
N -008
R D E -009
-010
-011

A 95-012
N -013
E -014
L -015

G 90-016
148.44
-017
900-009 DR. 40

P. 28
DR. 40
100.30
48.14