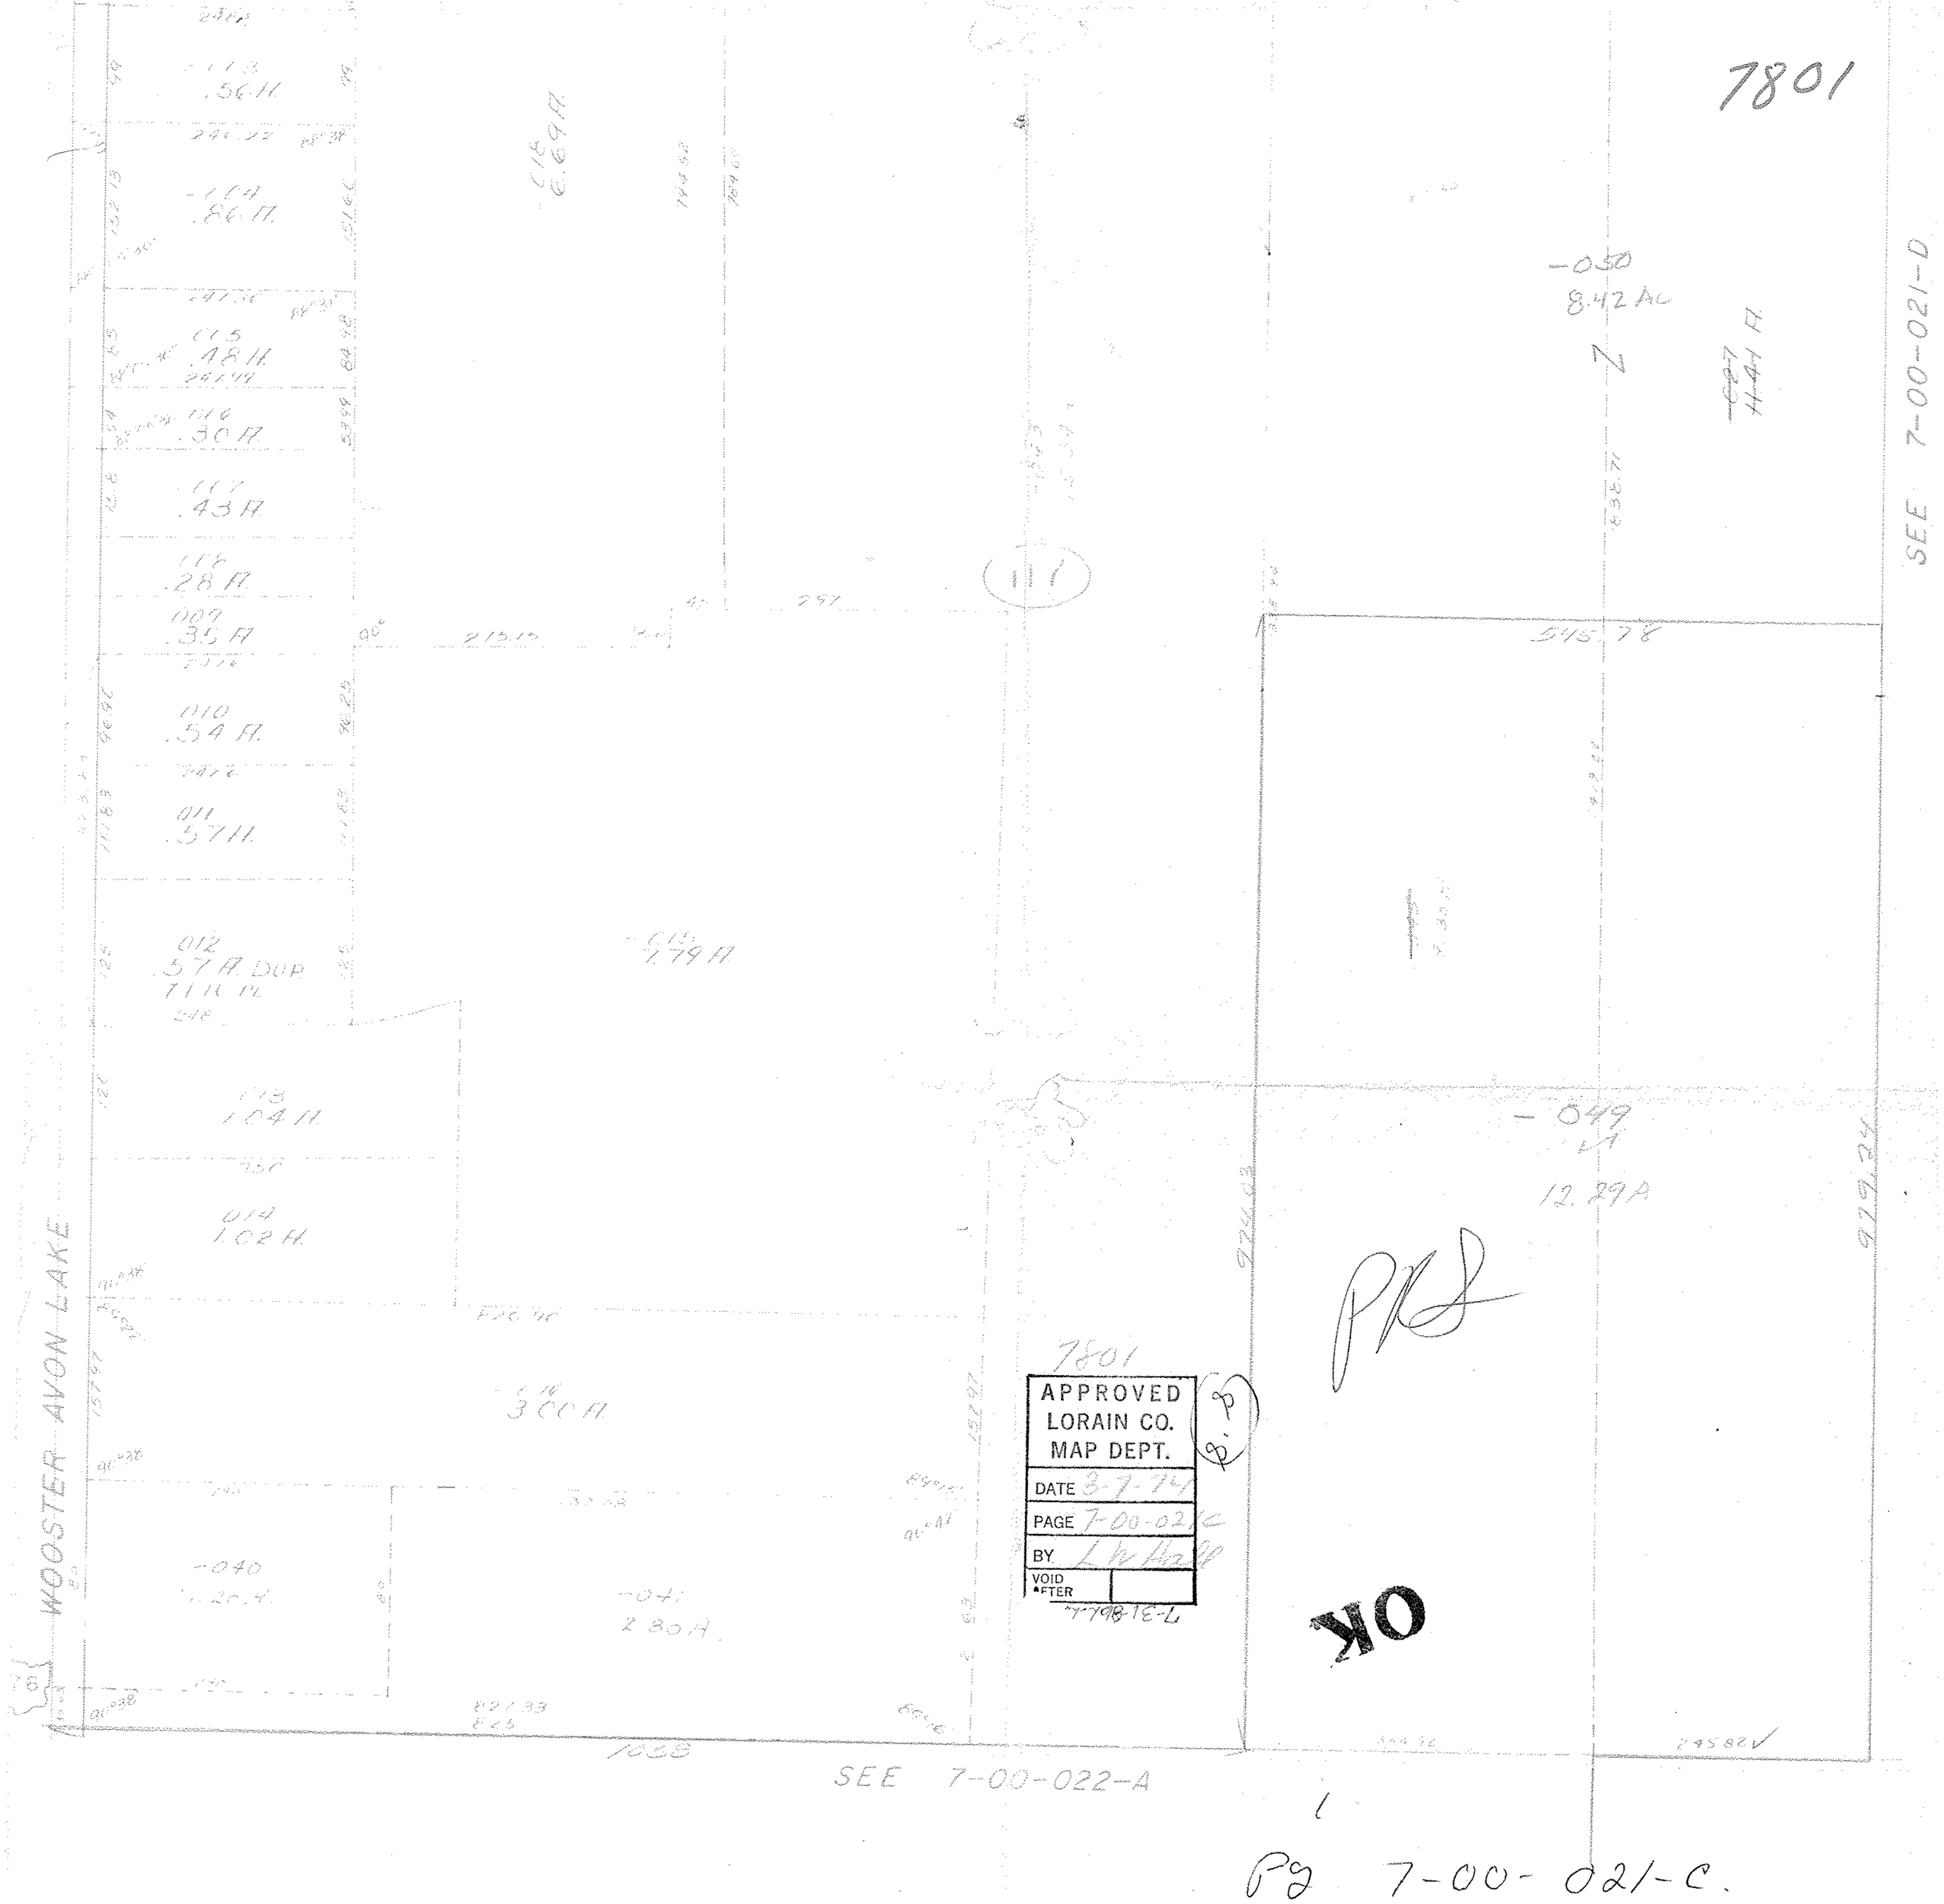
7801
.56 A
.86 A
.48 A
.30 A
.43 A
.28 A
.35 A
.54 A
.57 A
.57 A DUP
1.04 A
1.02 A
3.00 A
2.80 A
-040
-041
-050
8.42 AC
-049
12.29 A
545.78
WOOSTER AVON LAKE
SEE 7-00-021-D
SEE 7-00-022-A
7801
APPROVED
LORAIN CO.
MAP DEPT.
DATE 3-7-74
PAGE 7-00-021C
BY
VOID AFTER
OK

Pg 7-00-021-C.