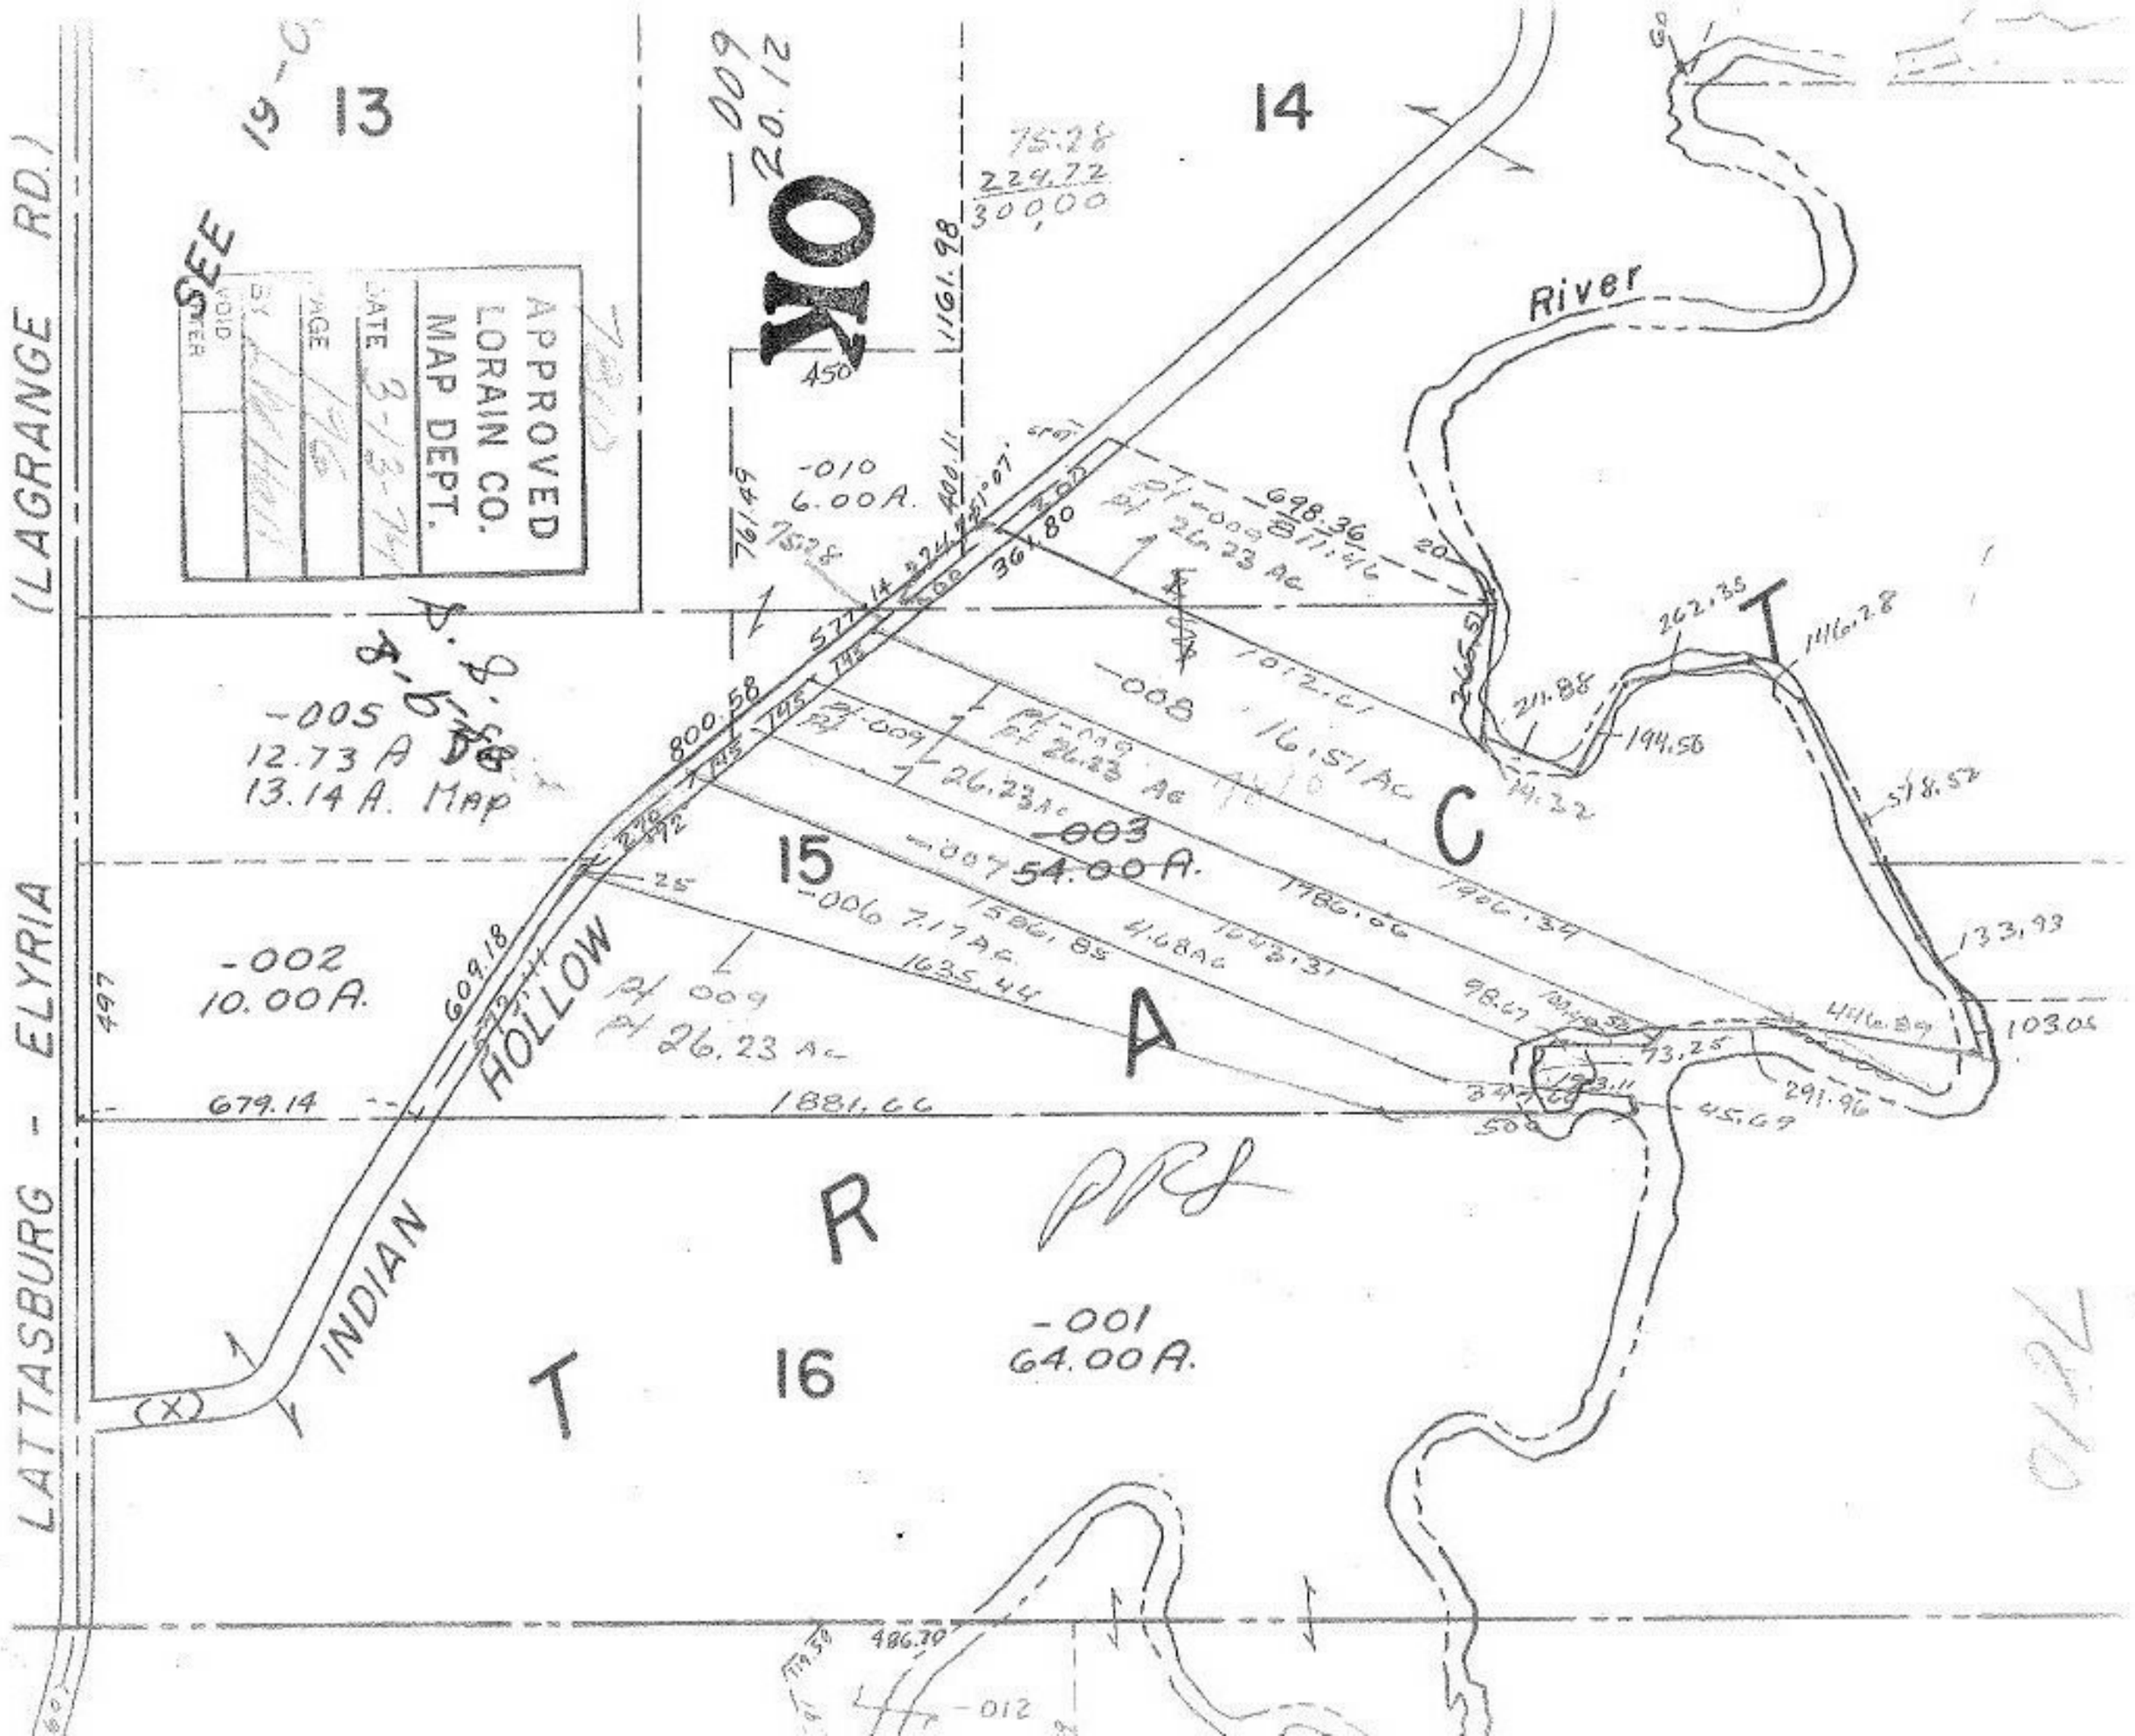

13
14
15
16
OK
APPROVED
LORAIN CO.
MAP DEPT.
DATE
PAGE
BY
VOID
SEE
(LAGRANGE RD.)
LATTASBURG - ELYRIA
INDIAN HOLLOW
River
-010
6.00A.
-005
12.73 A
13.14 A. Map
-002
10.00A.
-003
54.00 A.
-001
64.00A.
-008
16.51 Ac
26.23 Ac
7.17 Ac
4.68 Ac
1881.66
679.14
800.58
609.18
1161.98
698.36
1012.61
1986.06
1906.34
1635.44
1586.85
1643.31
486.70
-012