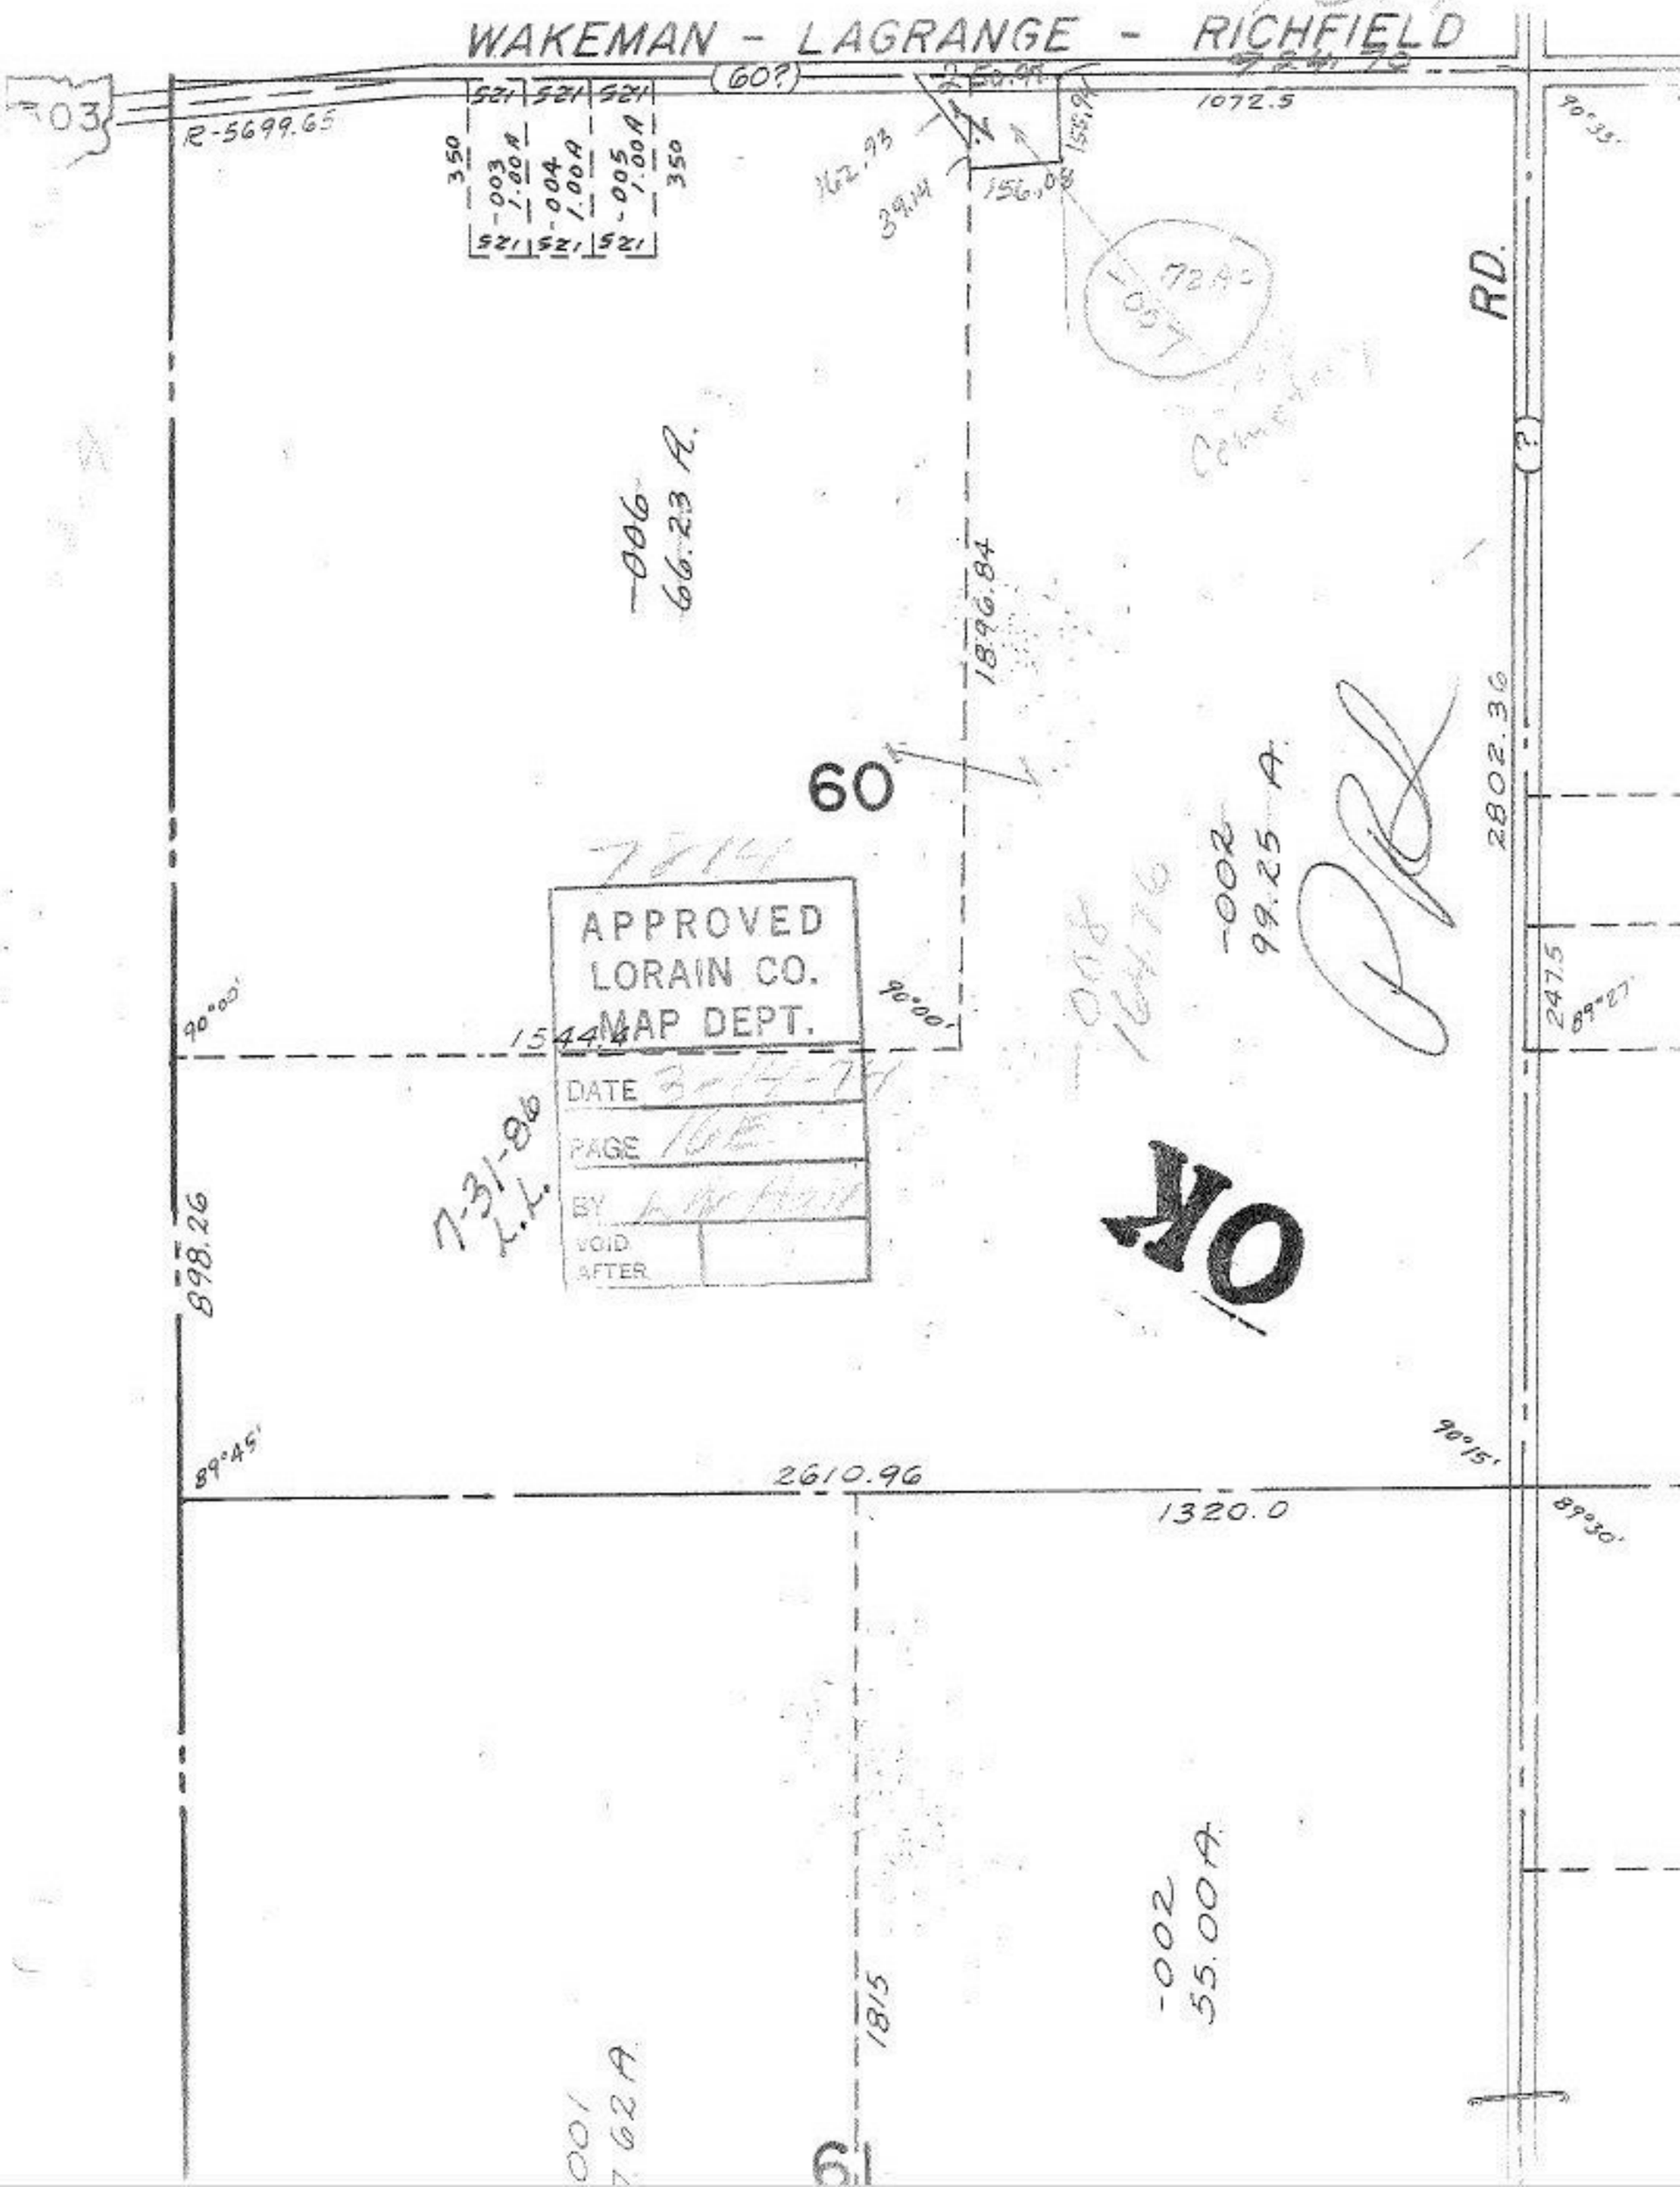
WAKEMAN - LAGRANGE - RICHFIELD
(60?)
R-5699.65
1072.5
RD.
-006
66.23 A.
1896.84
60
-002
99.25 A.
2802.36
247.5
89°27'
90°00'
1544.4
APPROVED
LORAIN CO.
MAP DEPT.
DATE
PAGE
BY
VOID
AFTER
7-31-86
L.L.
OK
898.26
89°45'
2610.96
1320.0
90°15'
89°30'
-002
55.00 A.
1815
-001
7.62 A.
6