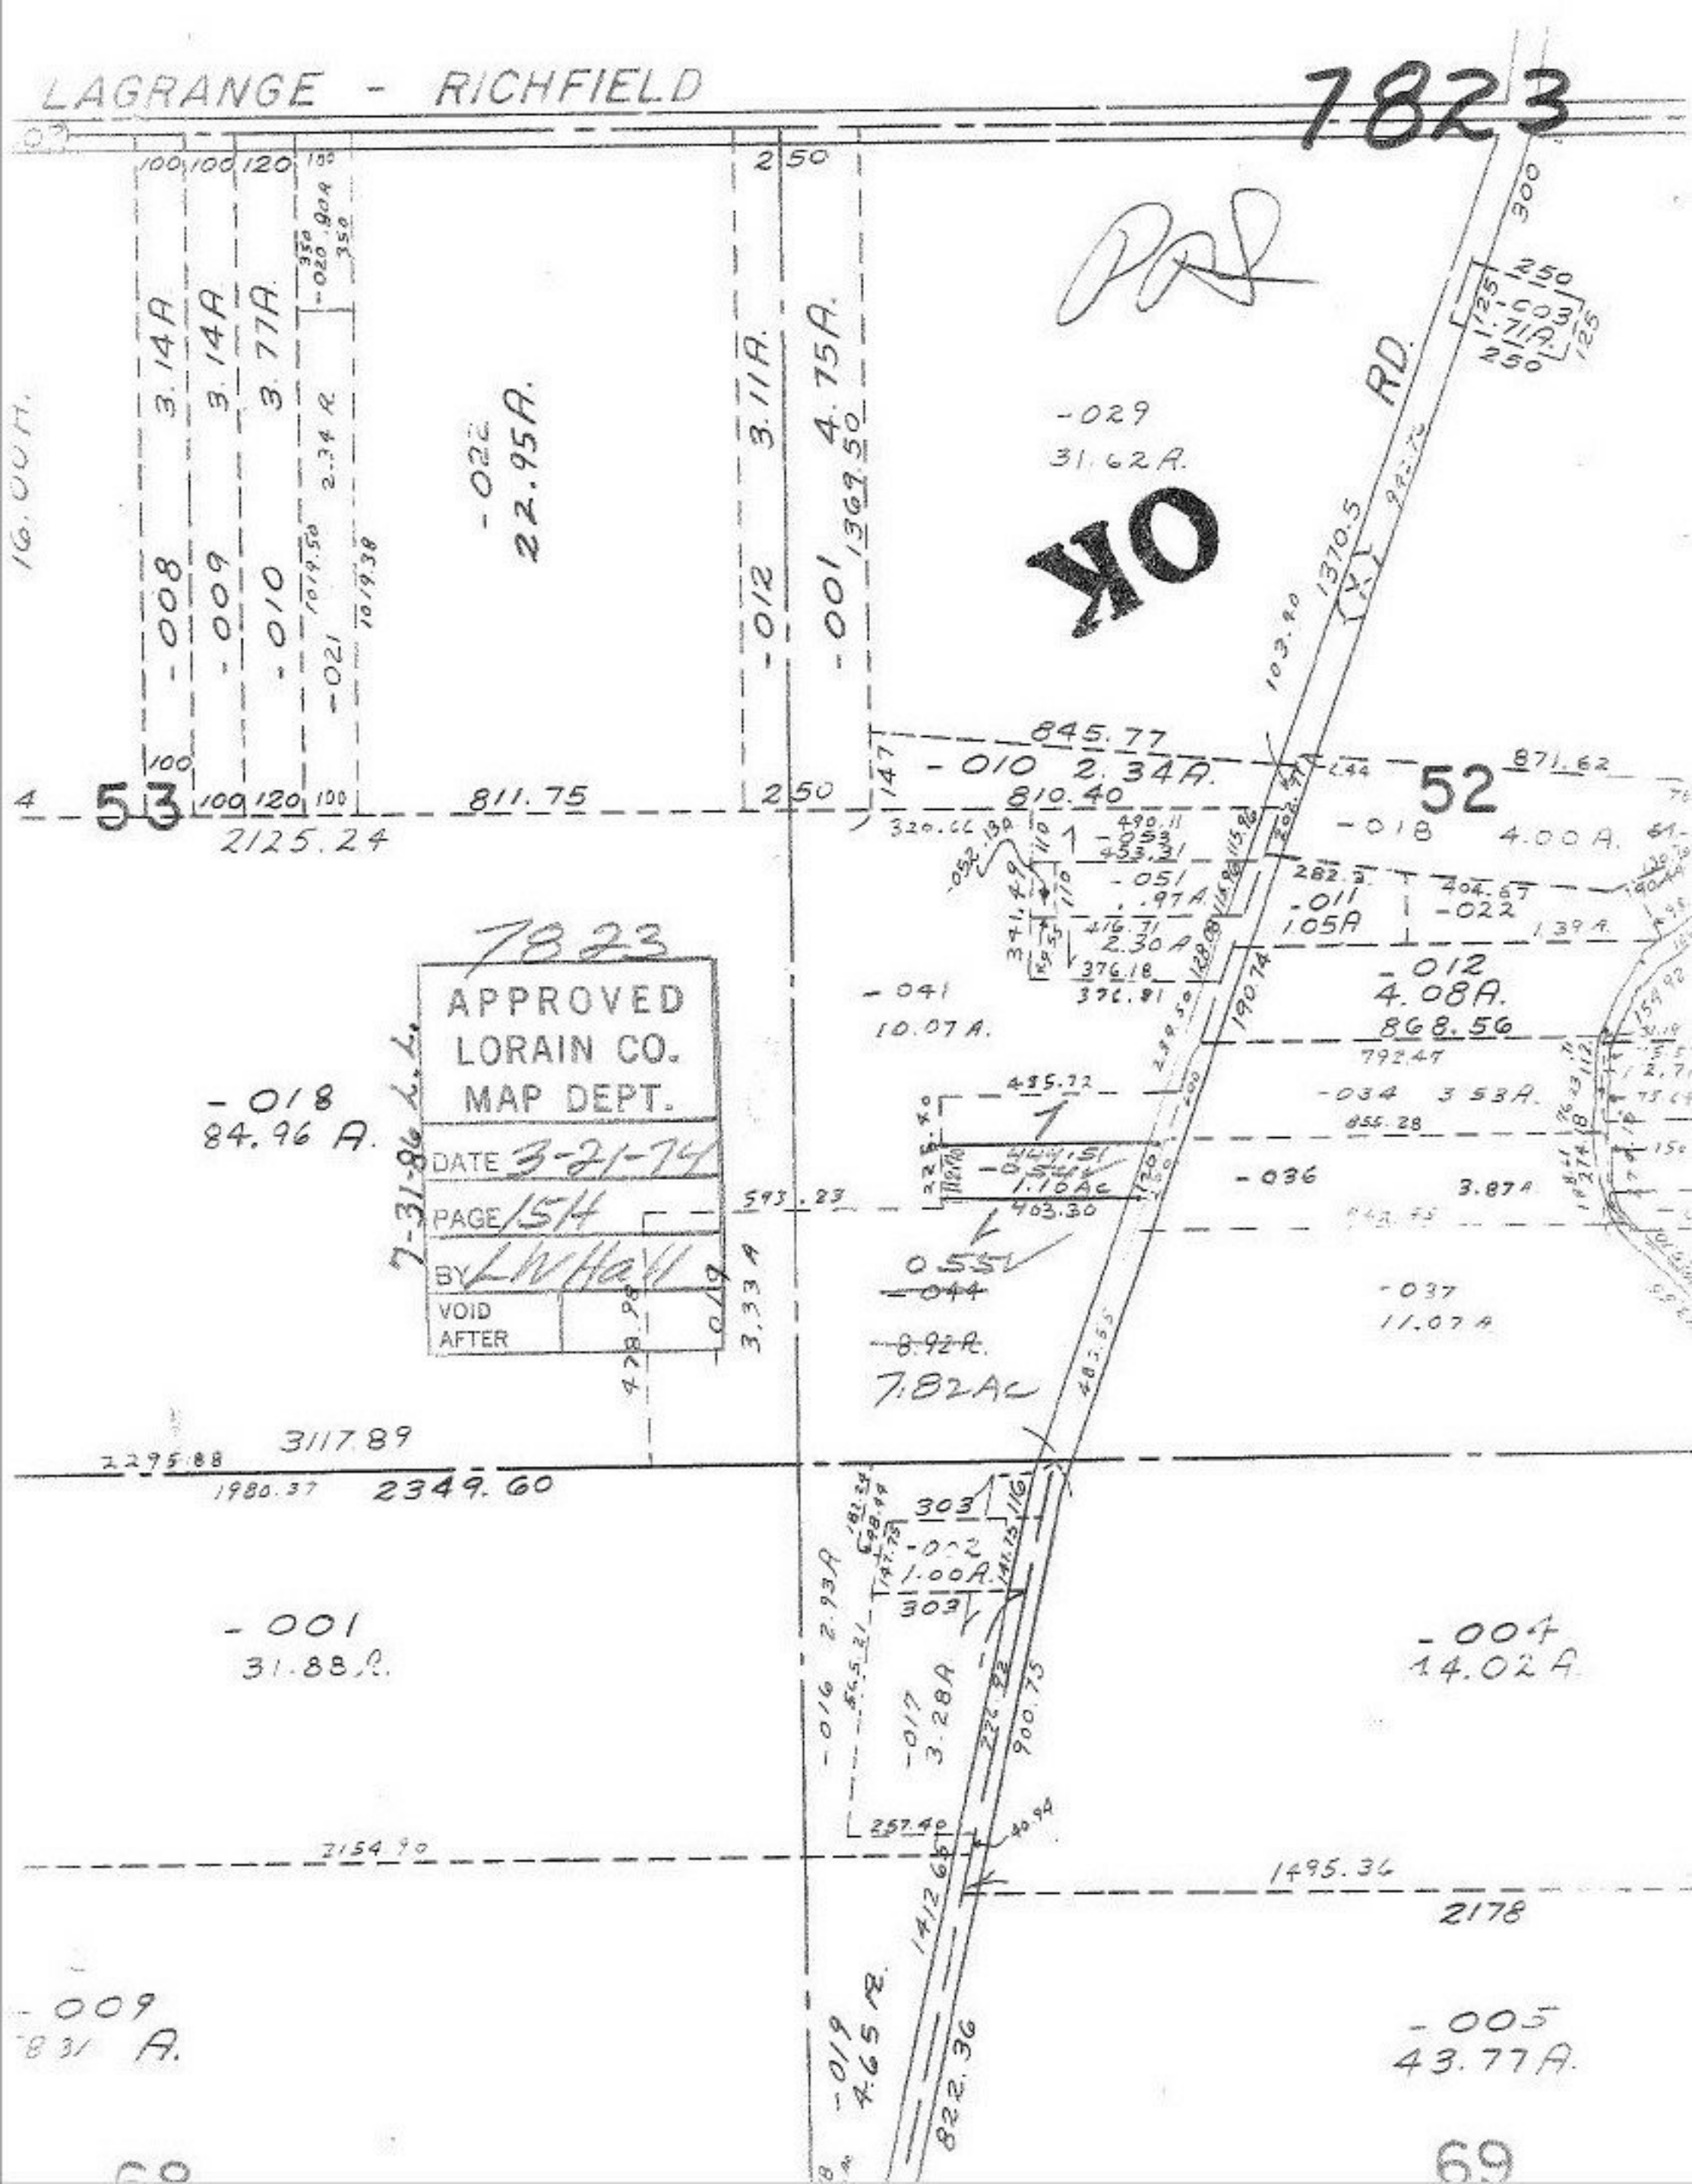
LAGRANGE - RICHFIELD
7823
OK
RD.
53
52
-008 3.14A
-009 3.14A
-010 3.77A
-021 2.34 R
-022 22.95A.
-012 3.11A.
-001 4.75A.
-029 31.62A.
-010 2.34A.
-018 4.00A.
-011 1.05A
-012 4.08A.
-034 3.53A.
-036 3.87A
-037 11.07A
-041 10.07A.
-018 84.96 A.
-001 31.88A.
-004 14.02A.
-005 43.77A.
-009 8.31 A.
-019 4.65 R.
-016 2.93A
-017 3.28A
-002 1.00A.
-003 .71A.
2125.24
811.75
845.77
810.40
871.62
868.56
792.47
855.28
593.23
3117.89
2349.60
2295.88
1980.37
2154.90
1495.36
2178
822.36
900.75
1412.65
1370.5
1369.50
7823
APPROVED
LORAIN CO.
MAP DEPT.
DATE 3-21-74
PAGE 154
BY LWHall
VOID AFTER
7-31-86 L.L.