7849

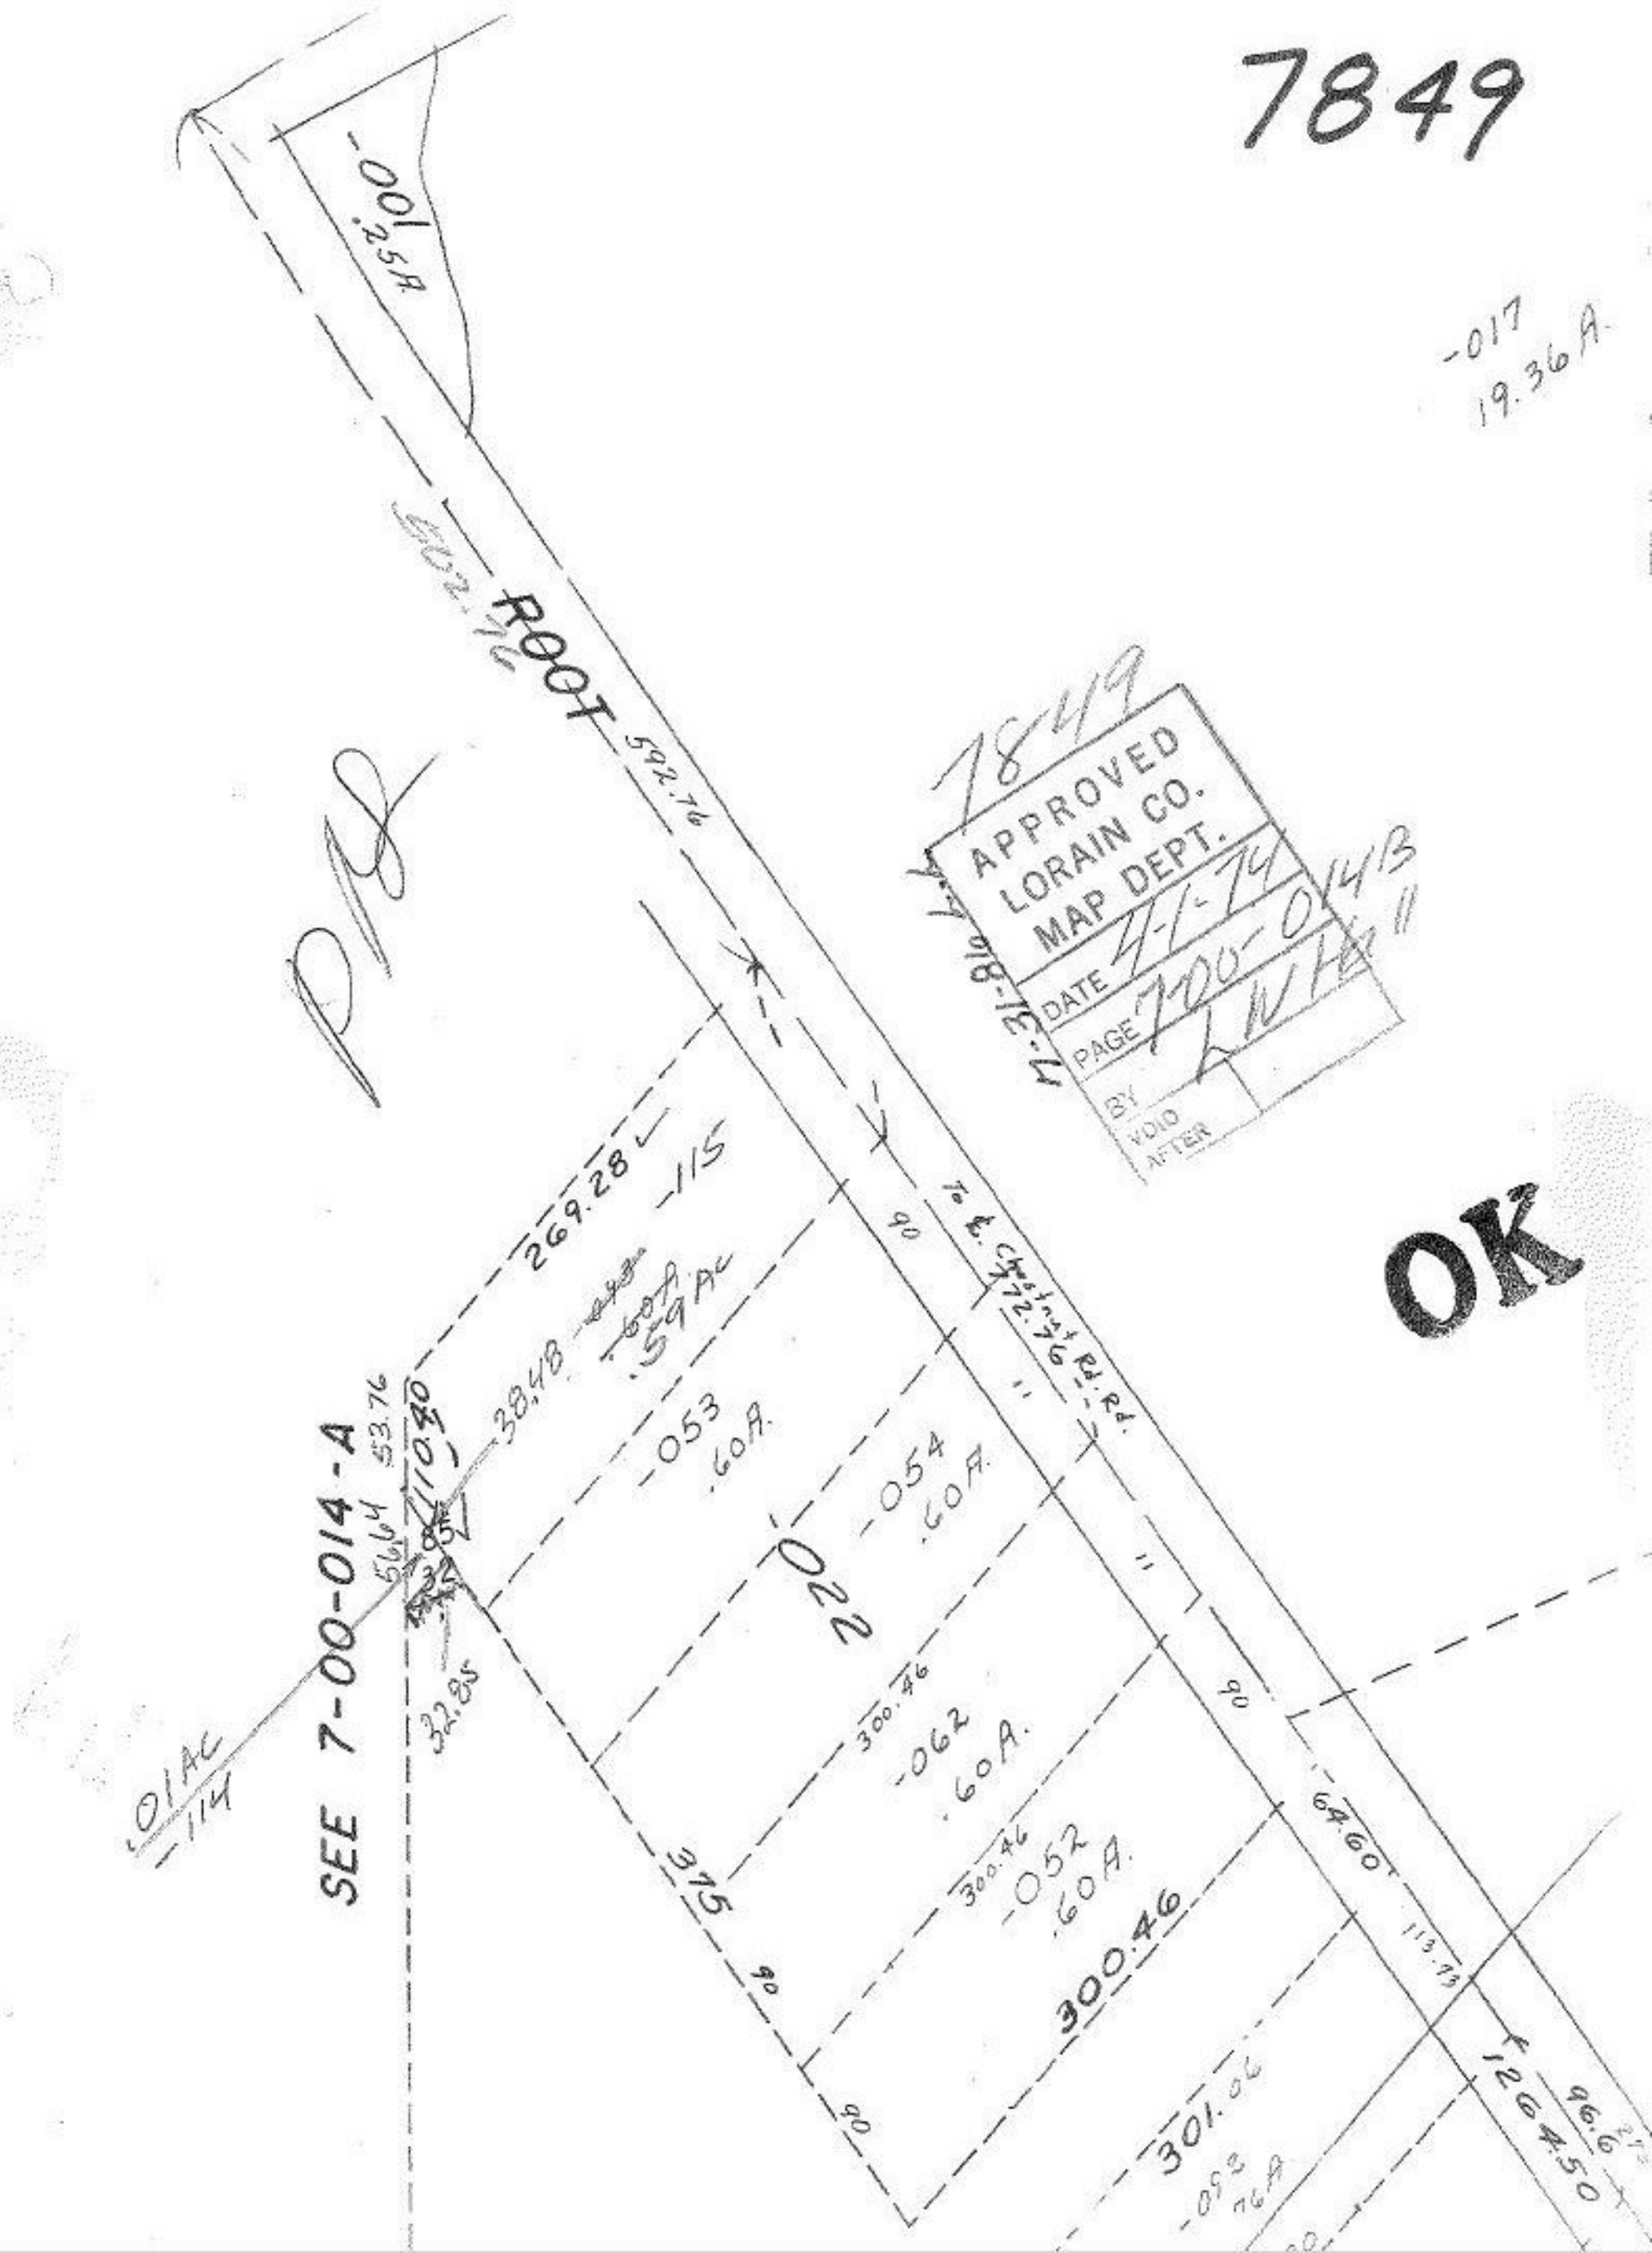

-001
.25A
ROOT
592.76
-017
19.36A.
7849
APPROVED
LORAIN CO.
MAP DEPT.
DATE 4-1-74
PAGE 7-00-014B
BY
VOID
AFTER
OK
269.28
-115
38.48
.59AC
-053
.60A.
-054
.60A.
-022
300.46
-062
.60A.
300.46
-052
.60A.
300.46
375
90
64.60
113.73
301.06
-093
.76A
1264.50
96.6
SEE 7-00-014-A
53.76
56.64
32.85
.01AC
-114