


7889

41

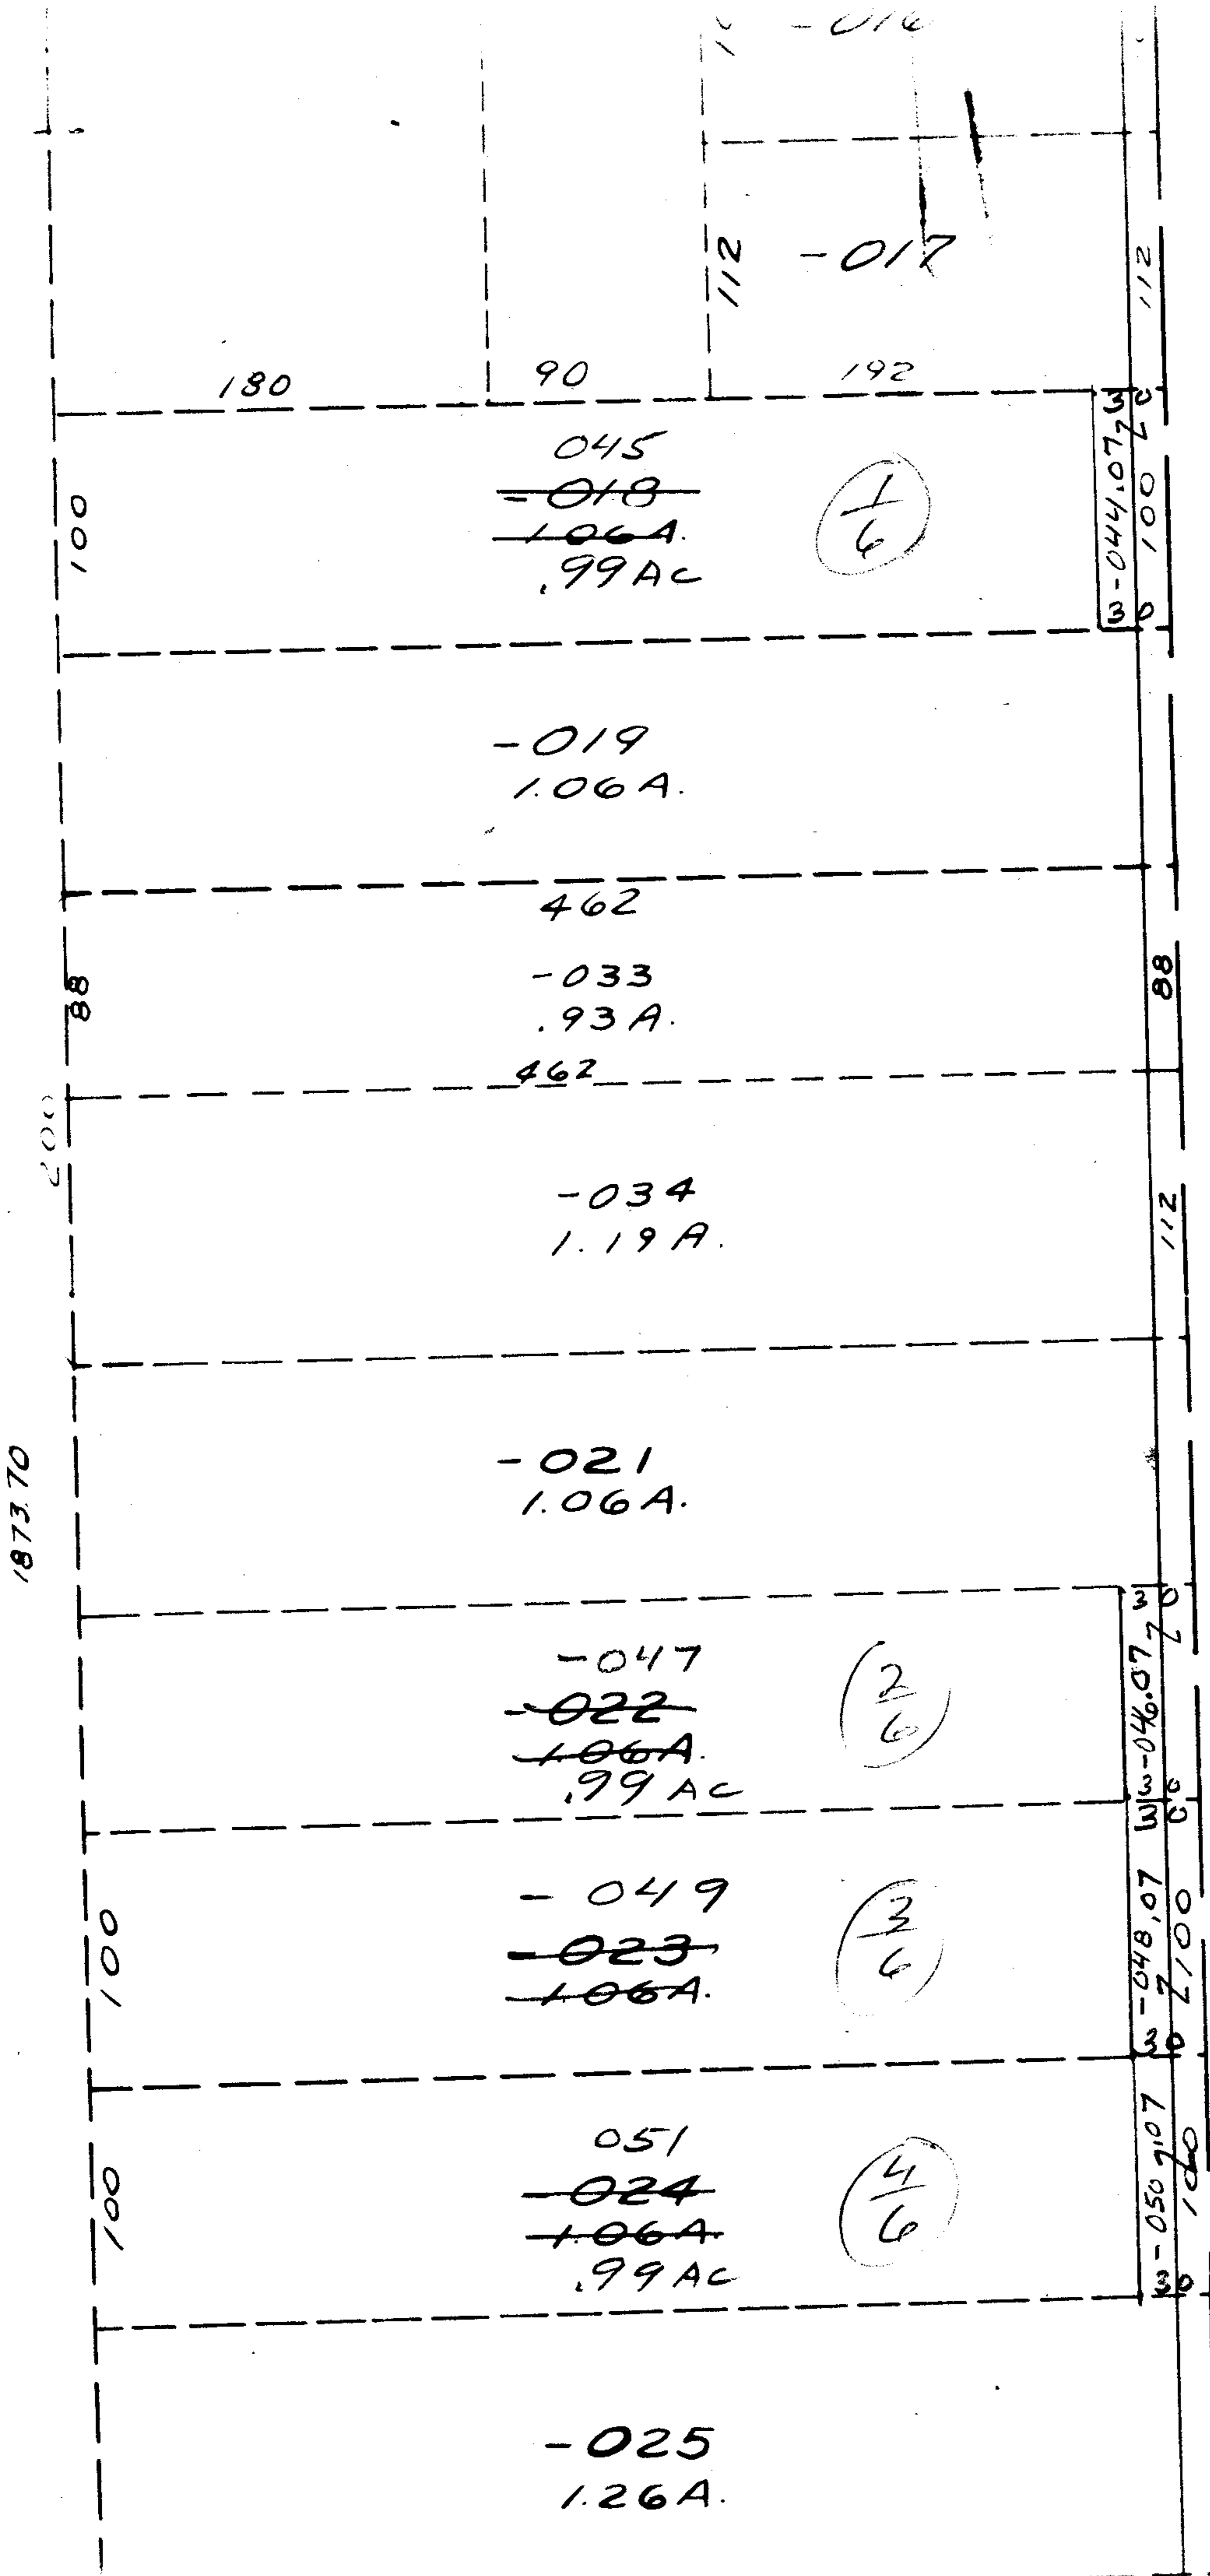

7889

7-31-86 L.S.L.

APPROVED	
LORAIN	
MAP DEPT.	
DATE 4-18-74	
PAGE 4-00-026A	
BY L W Hall	
VOID	
AFTER	



SEE 4-L