


SEE 4-00-026-F

CT

7889

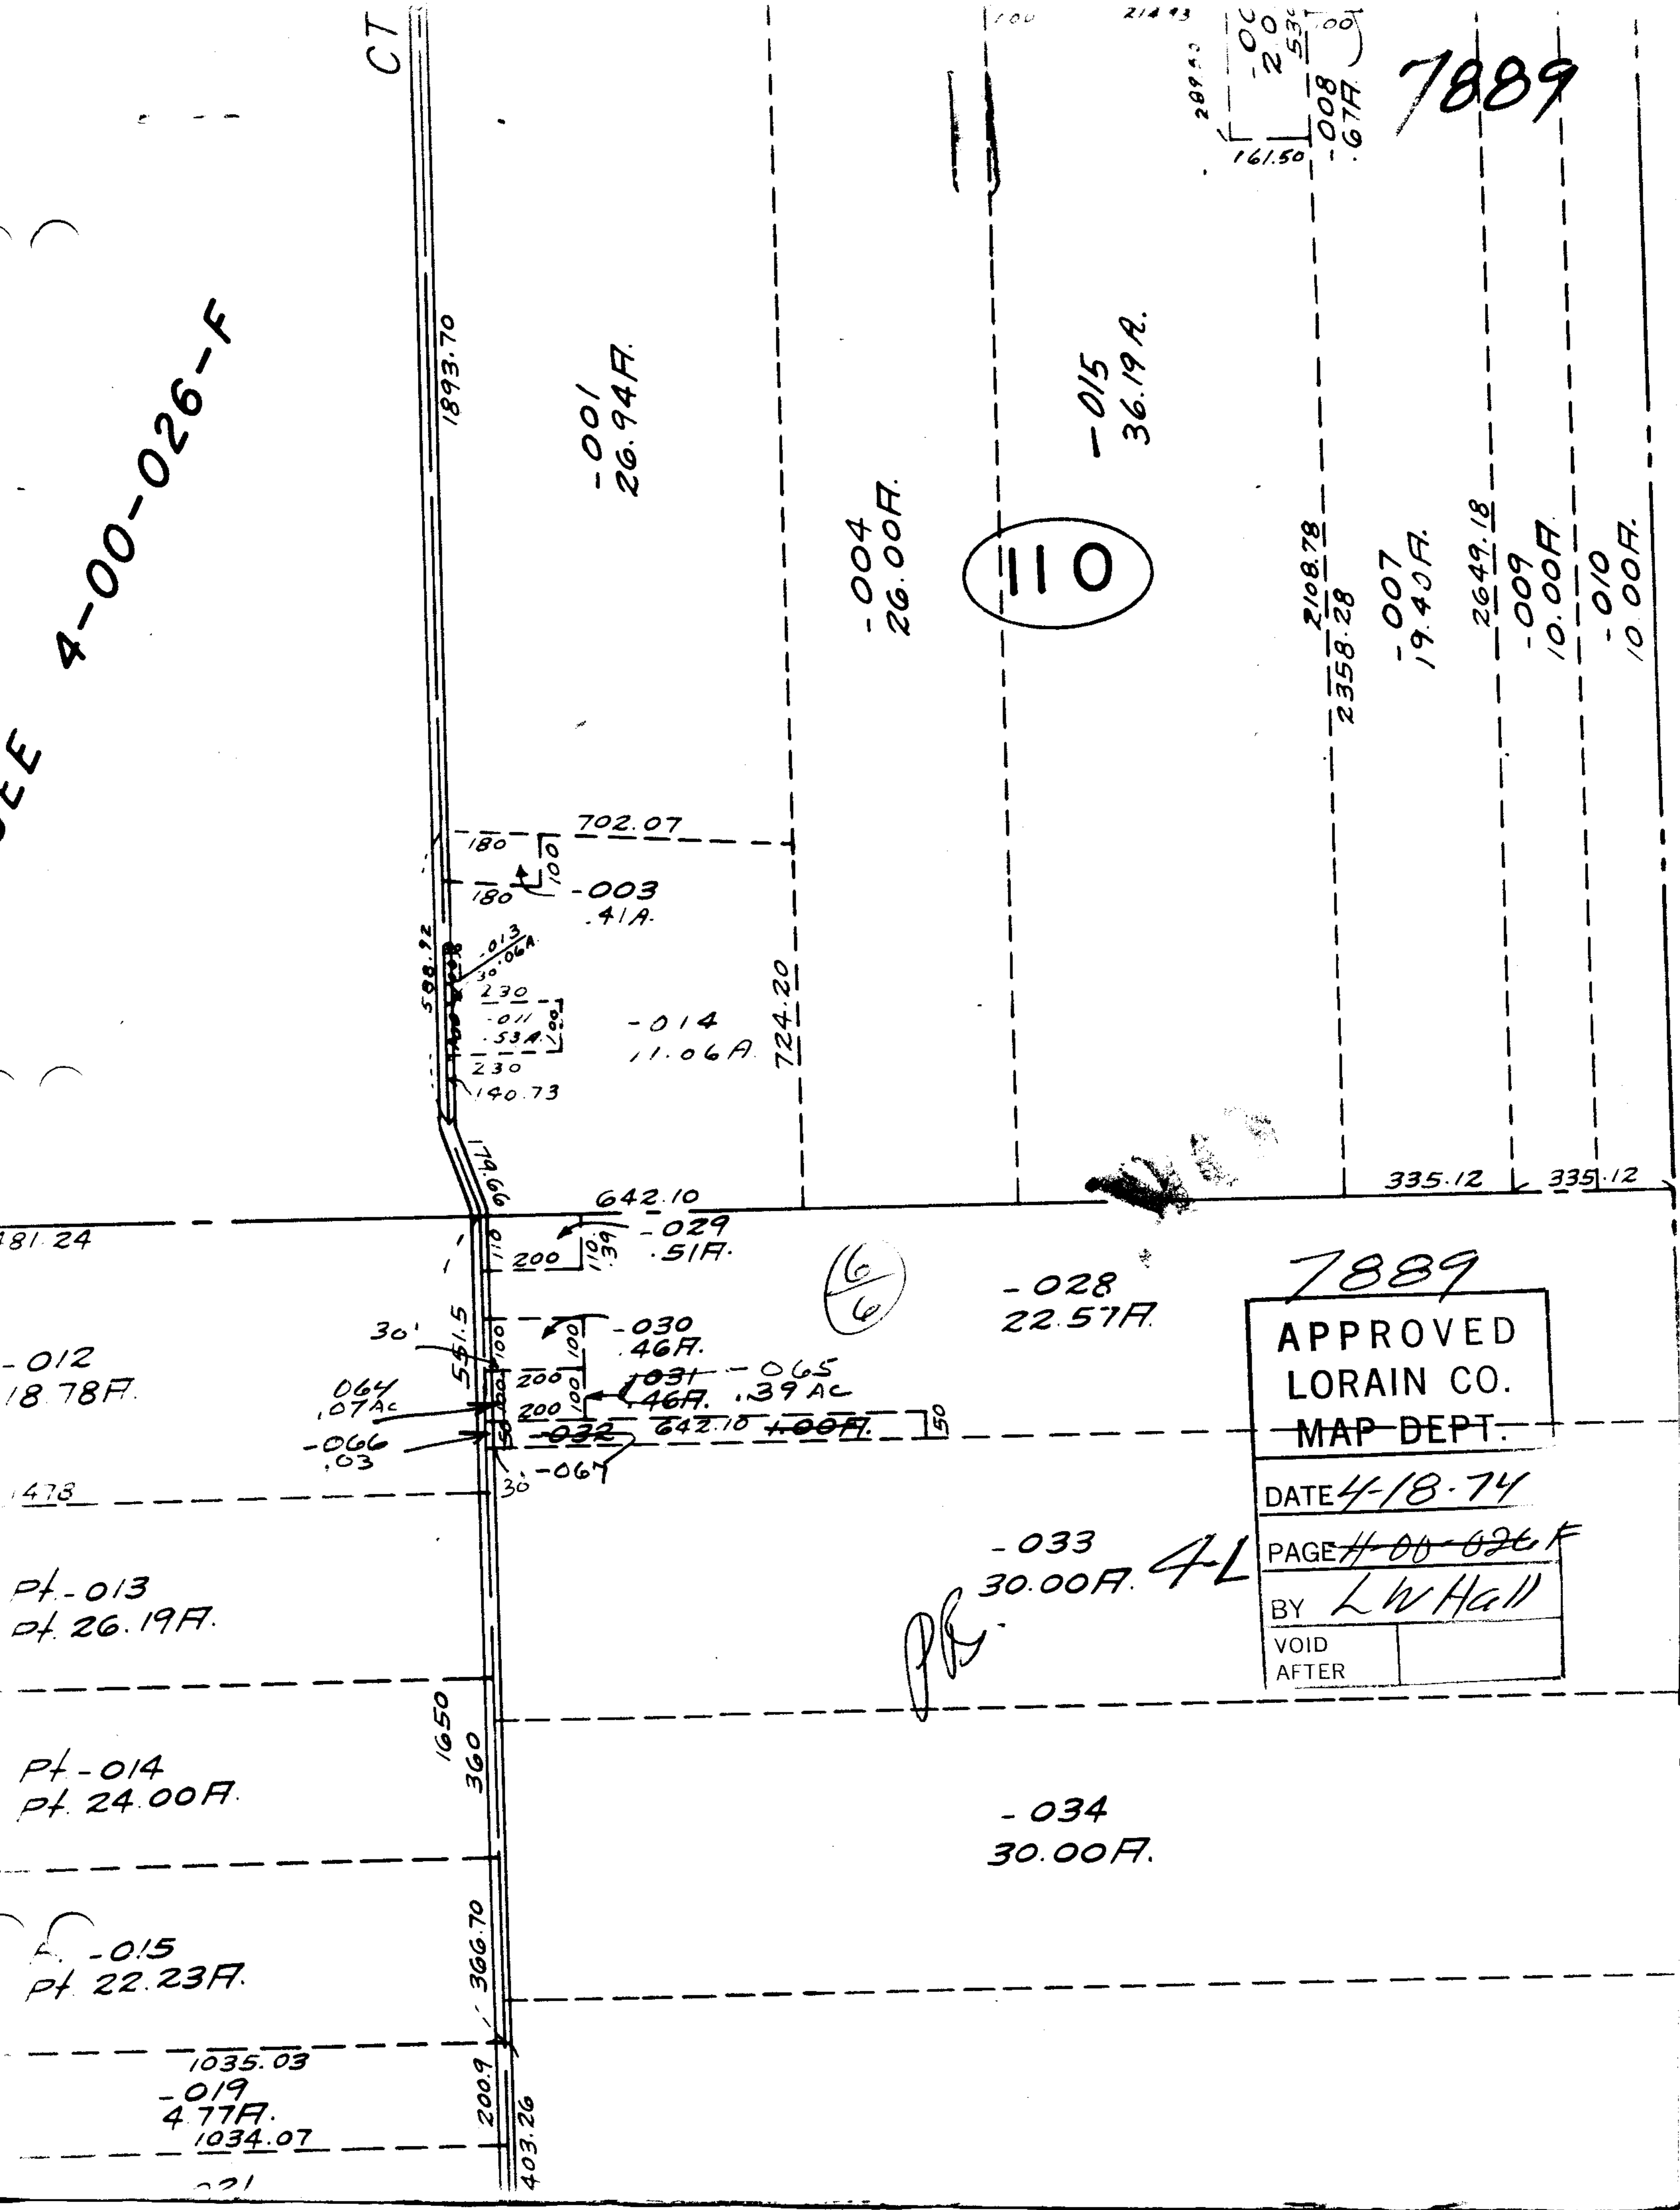

7889

APPROVED
LORAIN CO.
MAP DEPT.

DATE 4-18-74

PAGE 4-00-026-F

BY LWHall

VOID
AFTER

4L

pk