


7893

10-00-007-F

Pt. 10-00-007-105-020  
Pt. 31.41 A.

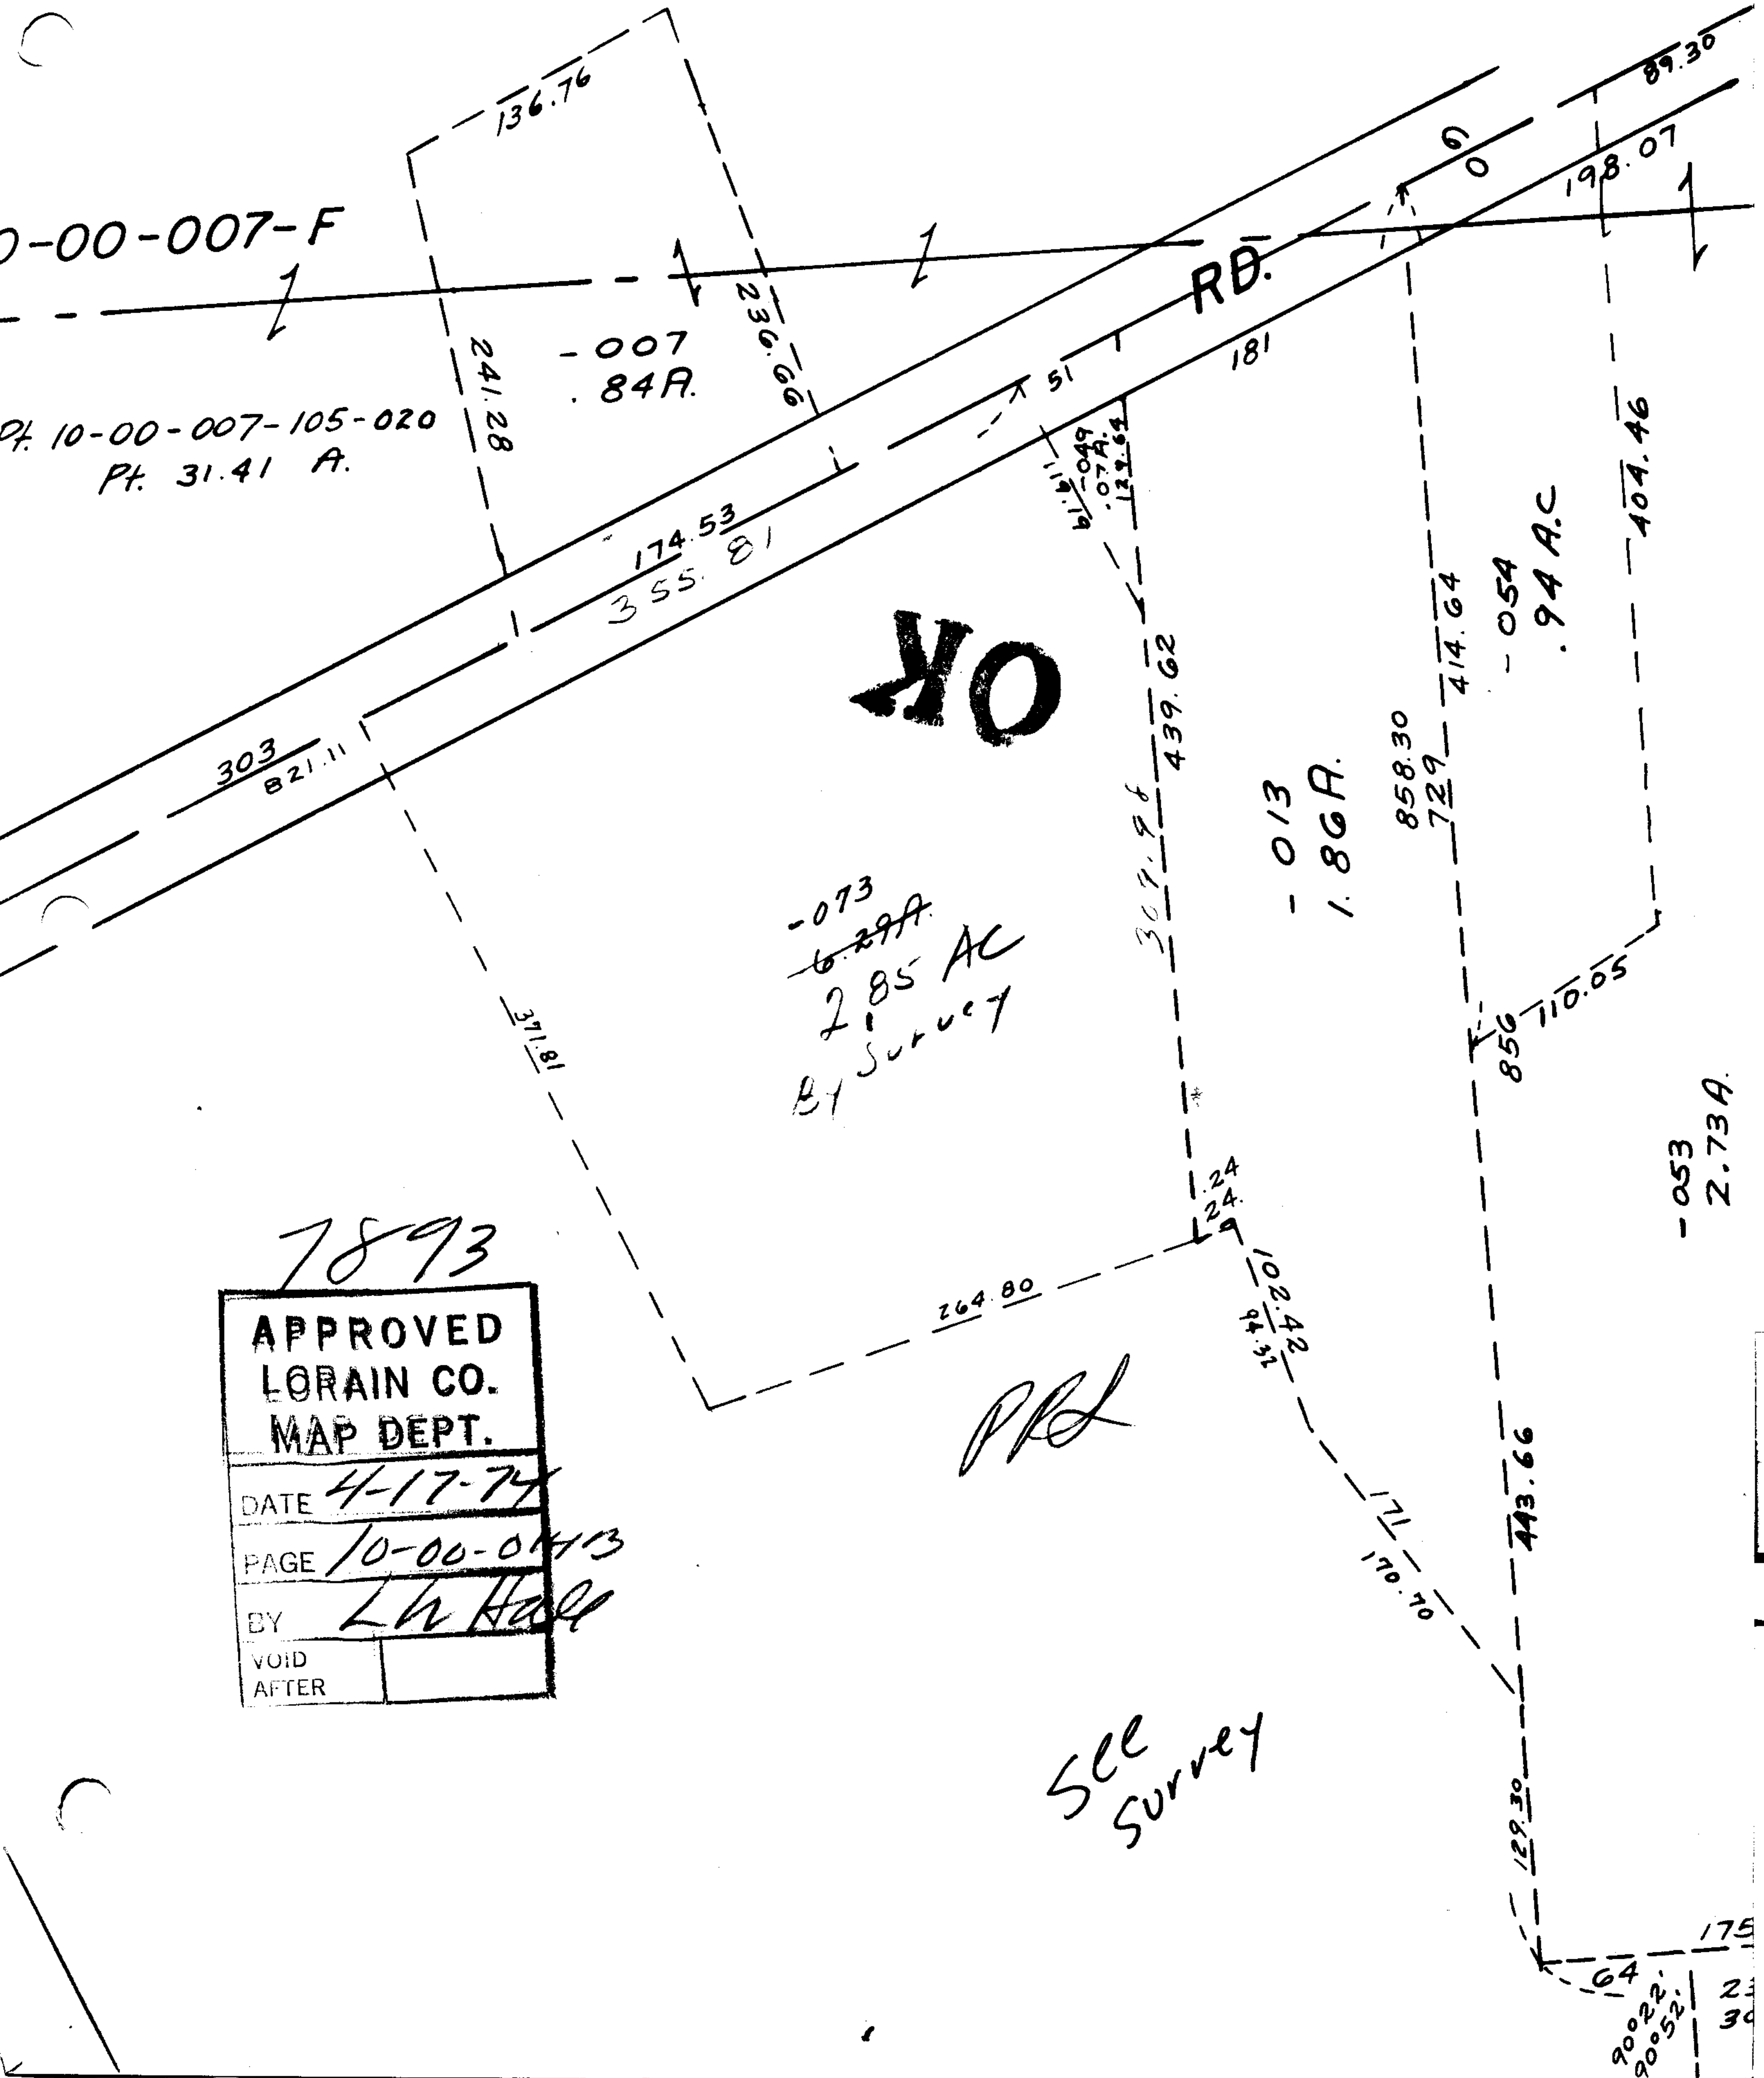

7893

APPROVED	
LORAIN CO.	
MAP DEPT.	
DATE	4-17-74
PAGE	10-00-0413
BY	LW Hall
VOID AFTER	