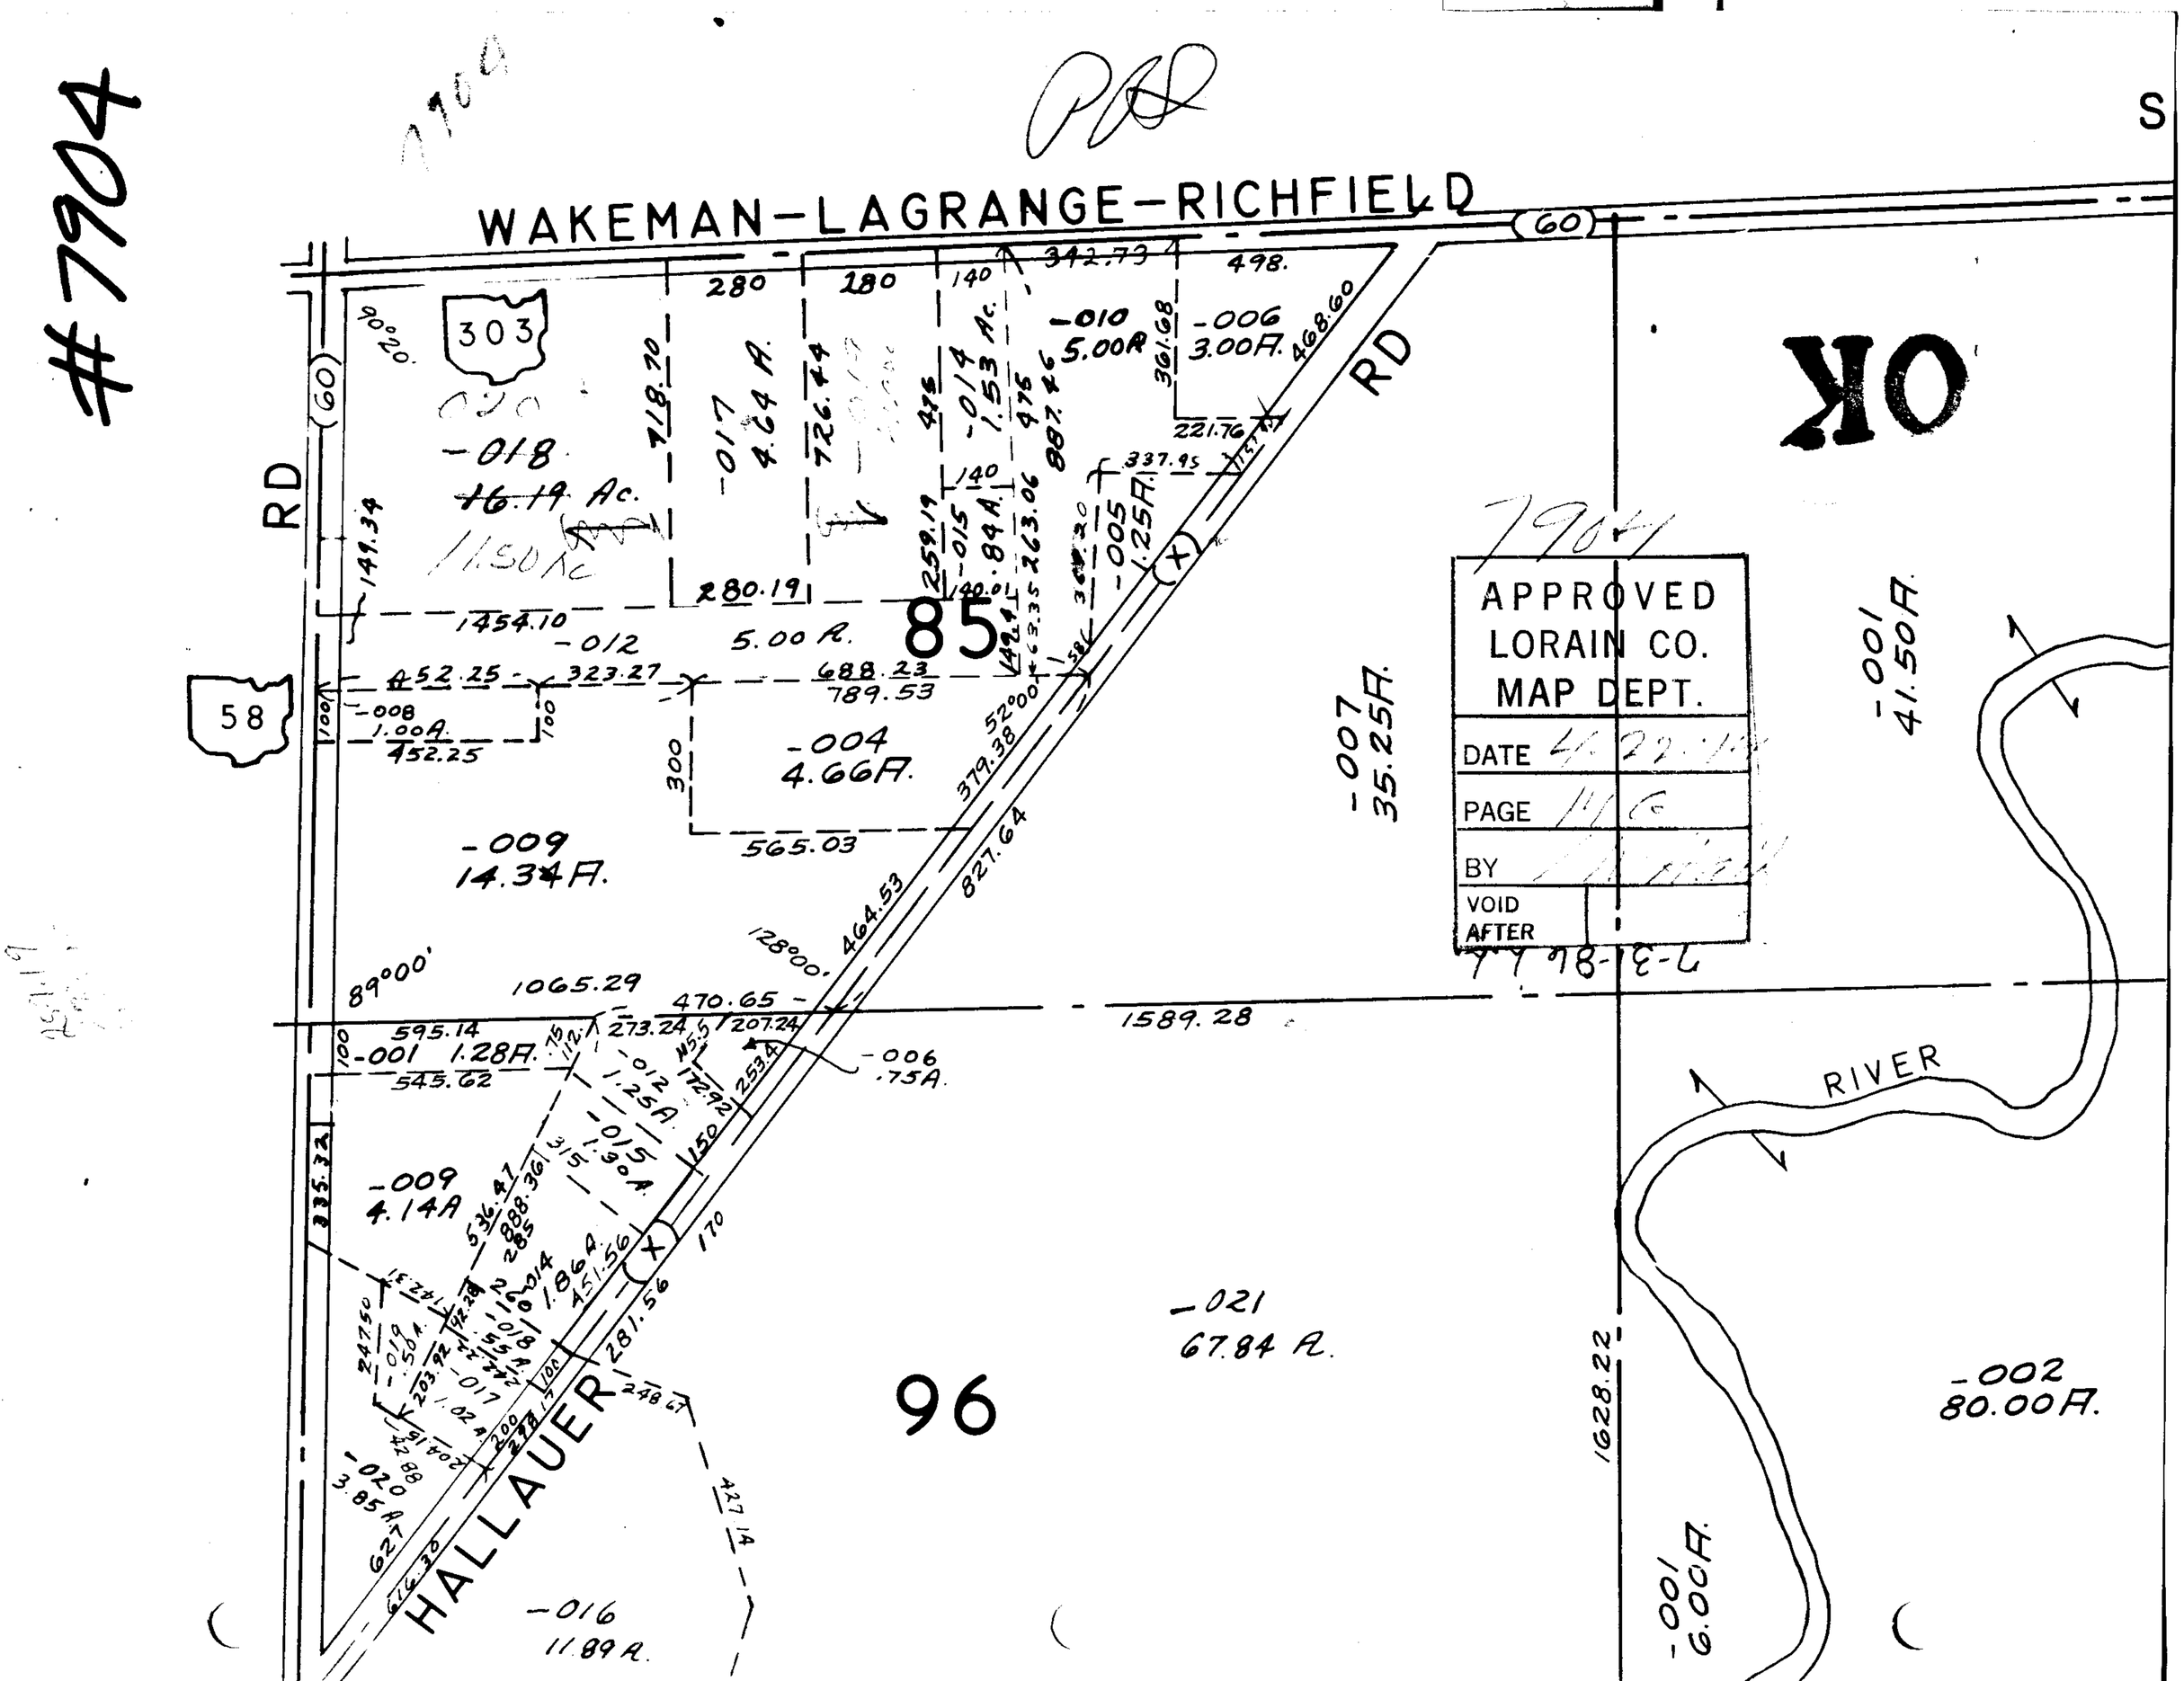

#7904
WAKEMAN-LAGRANGE-RICHFIELD
RD
RD
HALLAUER
RIVER
OK
85
96
303
58
-018
16.19 Ac.
-017
4.64 A.
-014
1.53 Ac.
-010
5.00A
-006
3.00A.
-005
1.25A.
-012
5.00 A.
-004
4.66A.
-009
14.34A.
-007
35.25A.
-001
41.50A.
-001
1.28A.
-006
.75A.
-009
4.14A
-021
67.84 A.
-002
80.00A.
-001
6.00A.
-016
11.89 A.
-020
3.85 A.
APPROVED
LORAIN CO.
MAP DEPT.
DATE
PAGE
BY
VOID
AFTER