


SEE 7-00-009-L

7-00-004C

7908

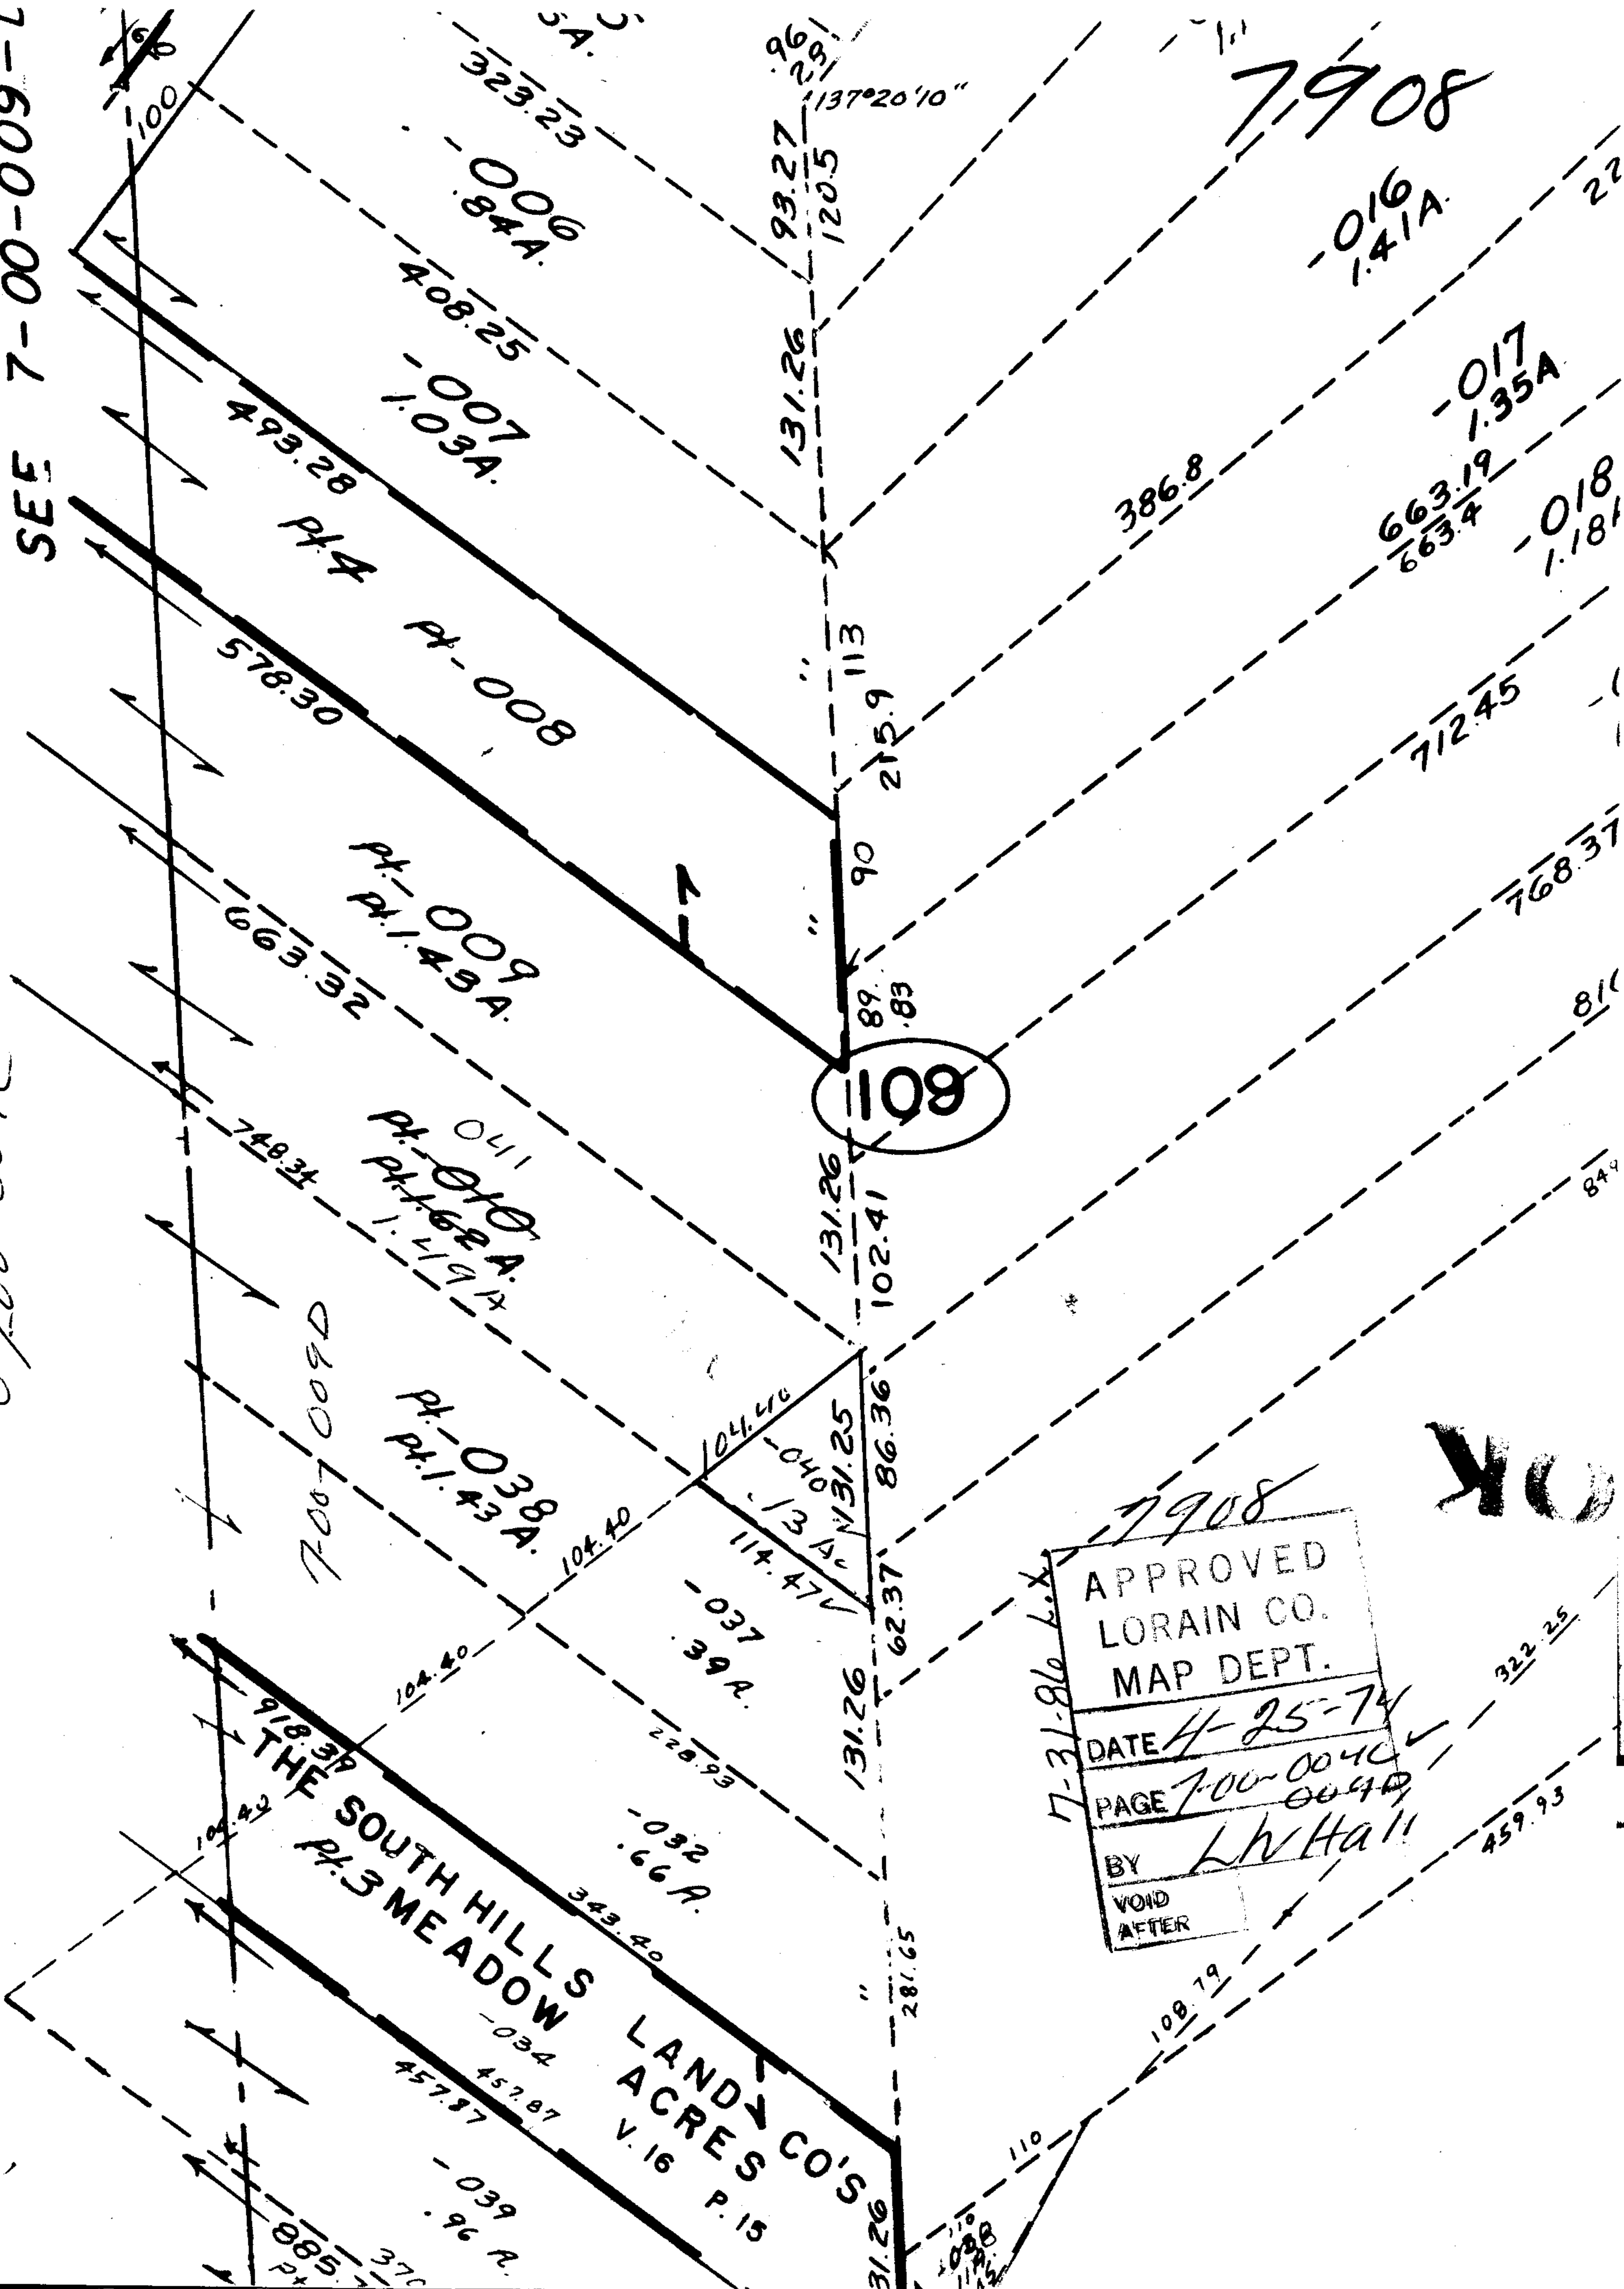

7908

APPROVED  
LORAIN CO.  
MAP DEPT.

DATE 4-25-74

PAGE 7-00-004C ✓  
004D

BY L.V. Hall

VOID  
AFTER

17-31-86 L.V.

322.25

459.93

40