


SEE 10-00-015-A

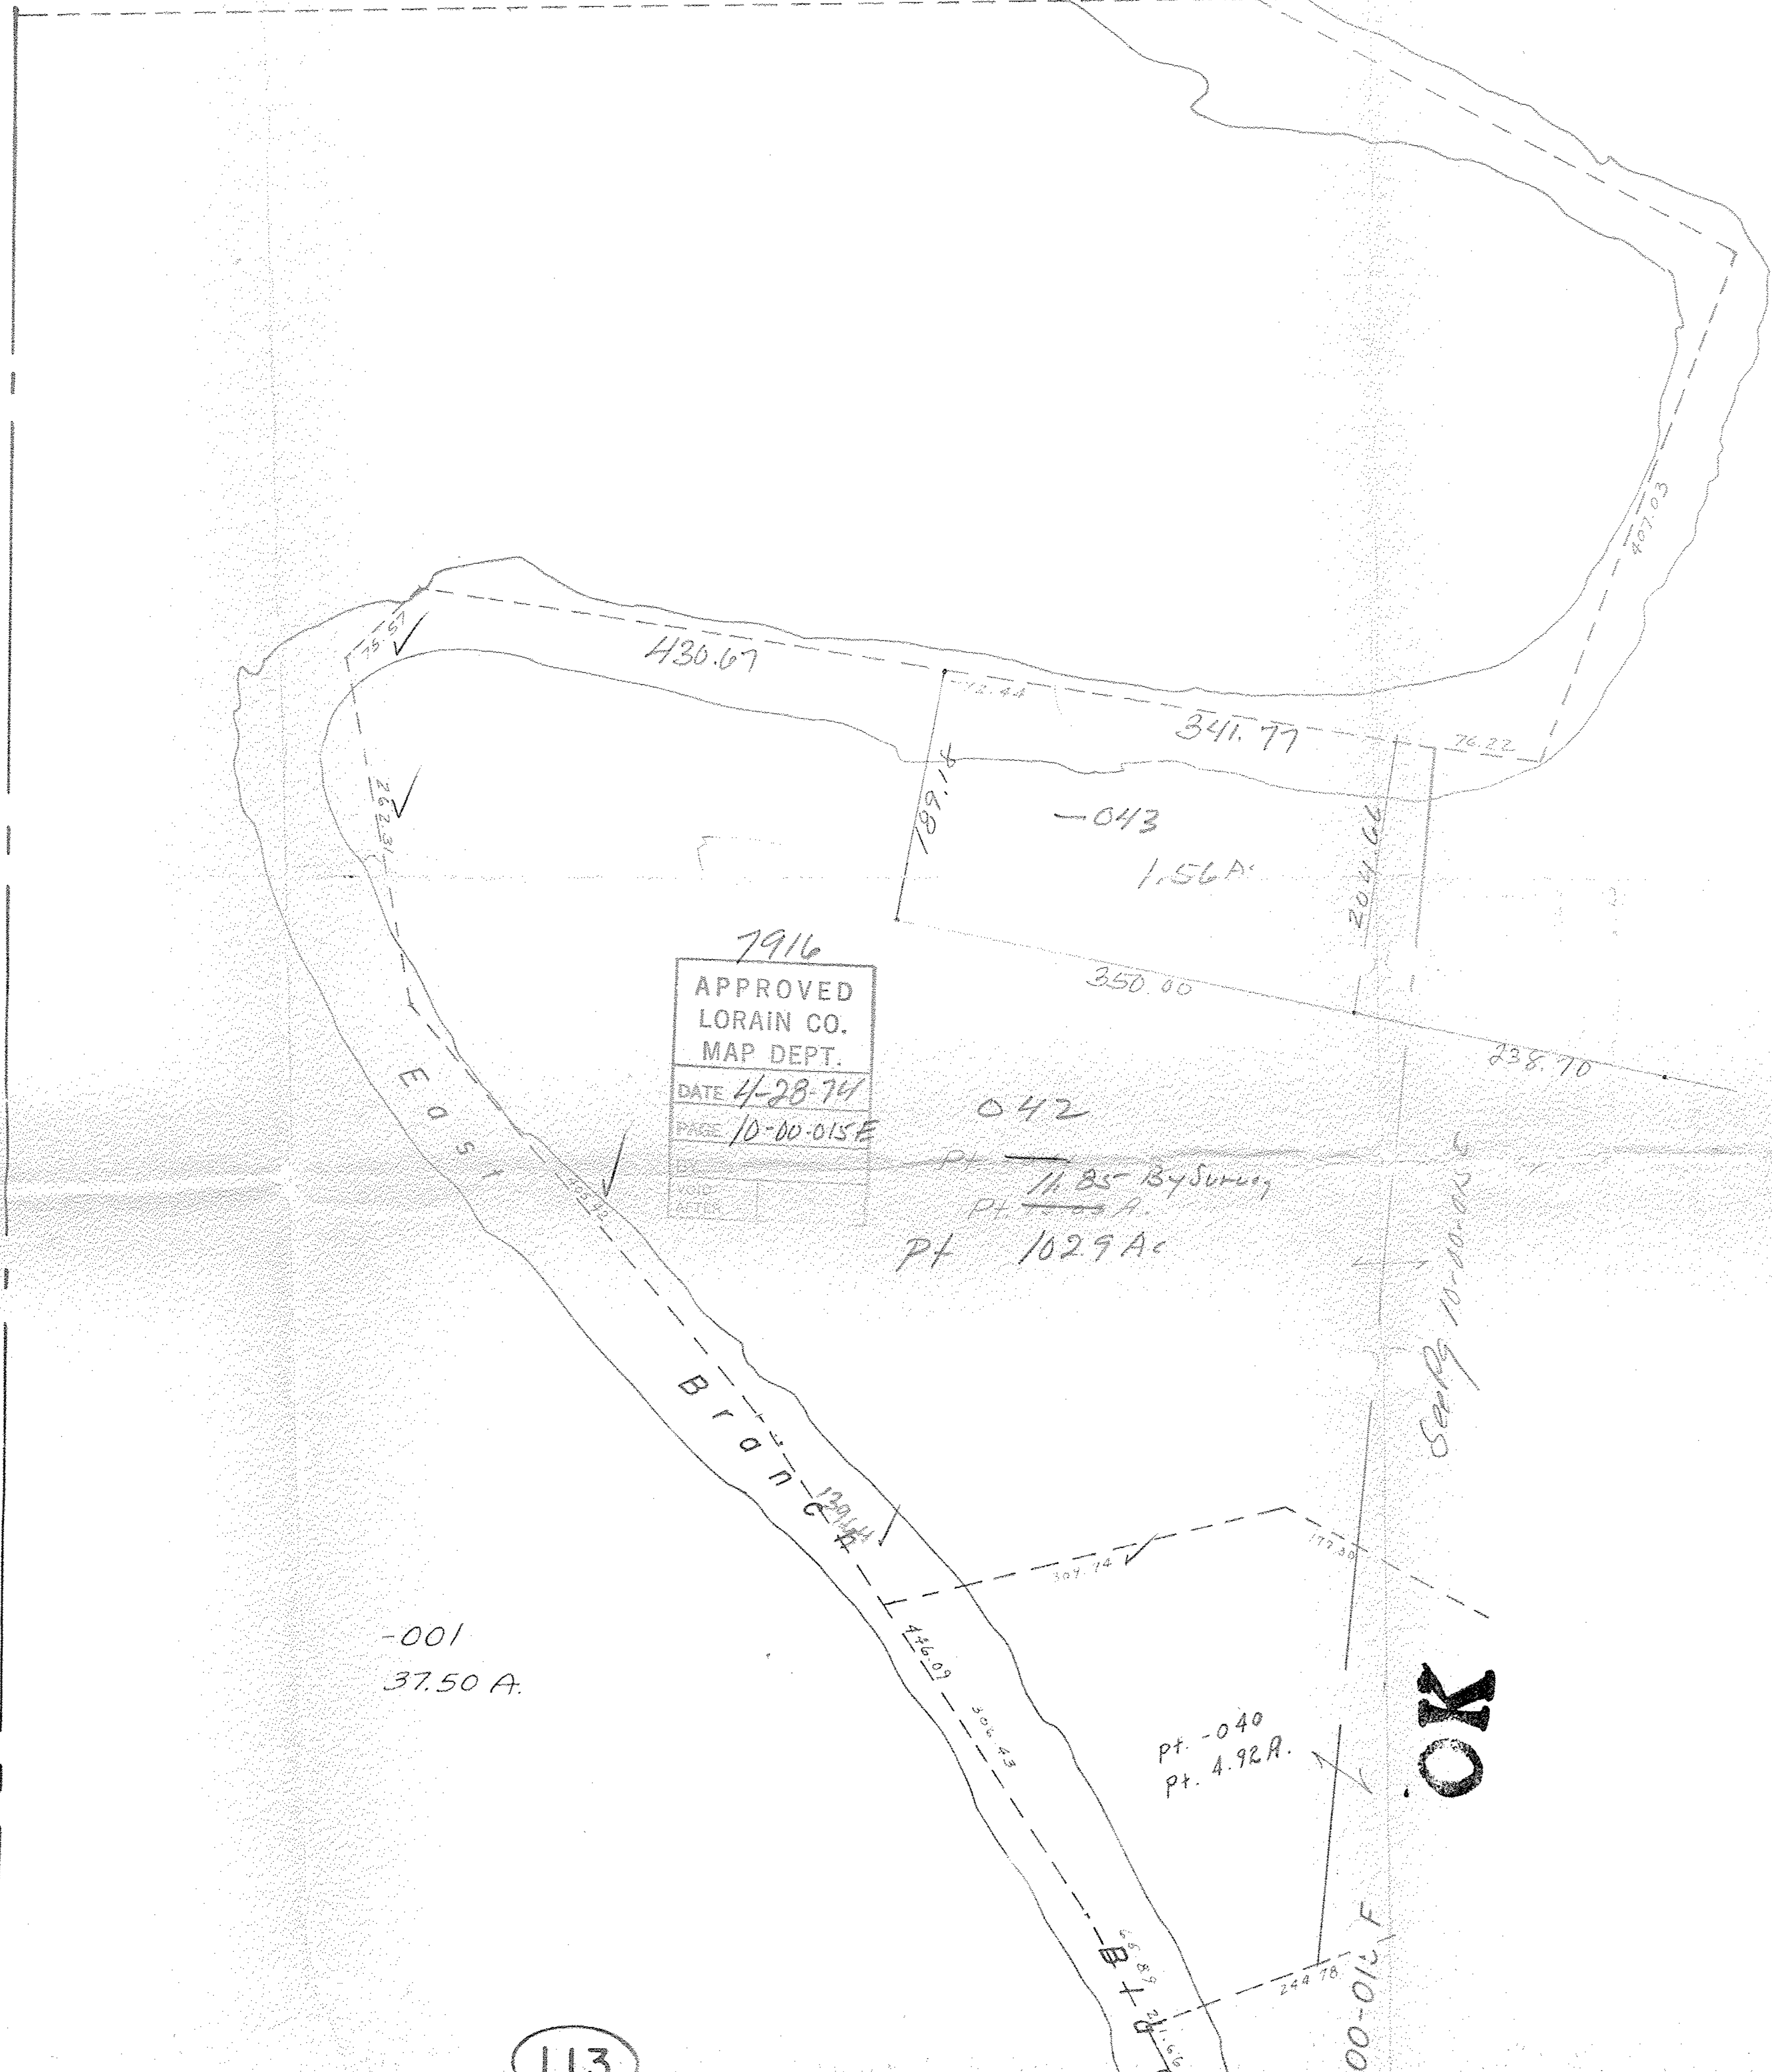

7916
 APPROVED
 LORAIN CO.
 MAP DEPT.
 DATE 4-28-74
 PAGE 10-00-015-E

042
 Pt. 11 B^s By Survey
 Pt. 1029 A.

-001
 37.50 A.

Pt. -040
 Pt. 4.92 A.

OK

P.R.

SEE 10-00-014-H

113