


 APPROVED  
 LORAIN CO.  
 MAP DEPT.  
 DATE *5-2-74*  
 PAGE *10-00-004-C*  
 BY *R. W. [Signature]*  
 VOID AFTER *10'*

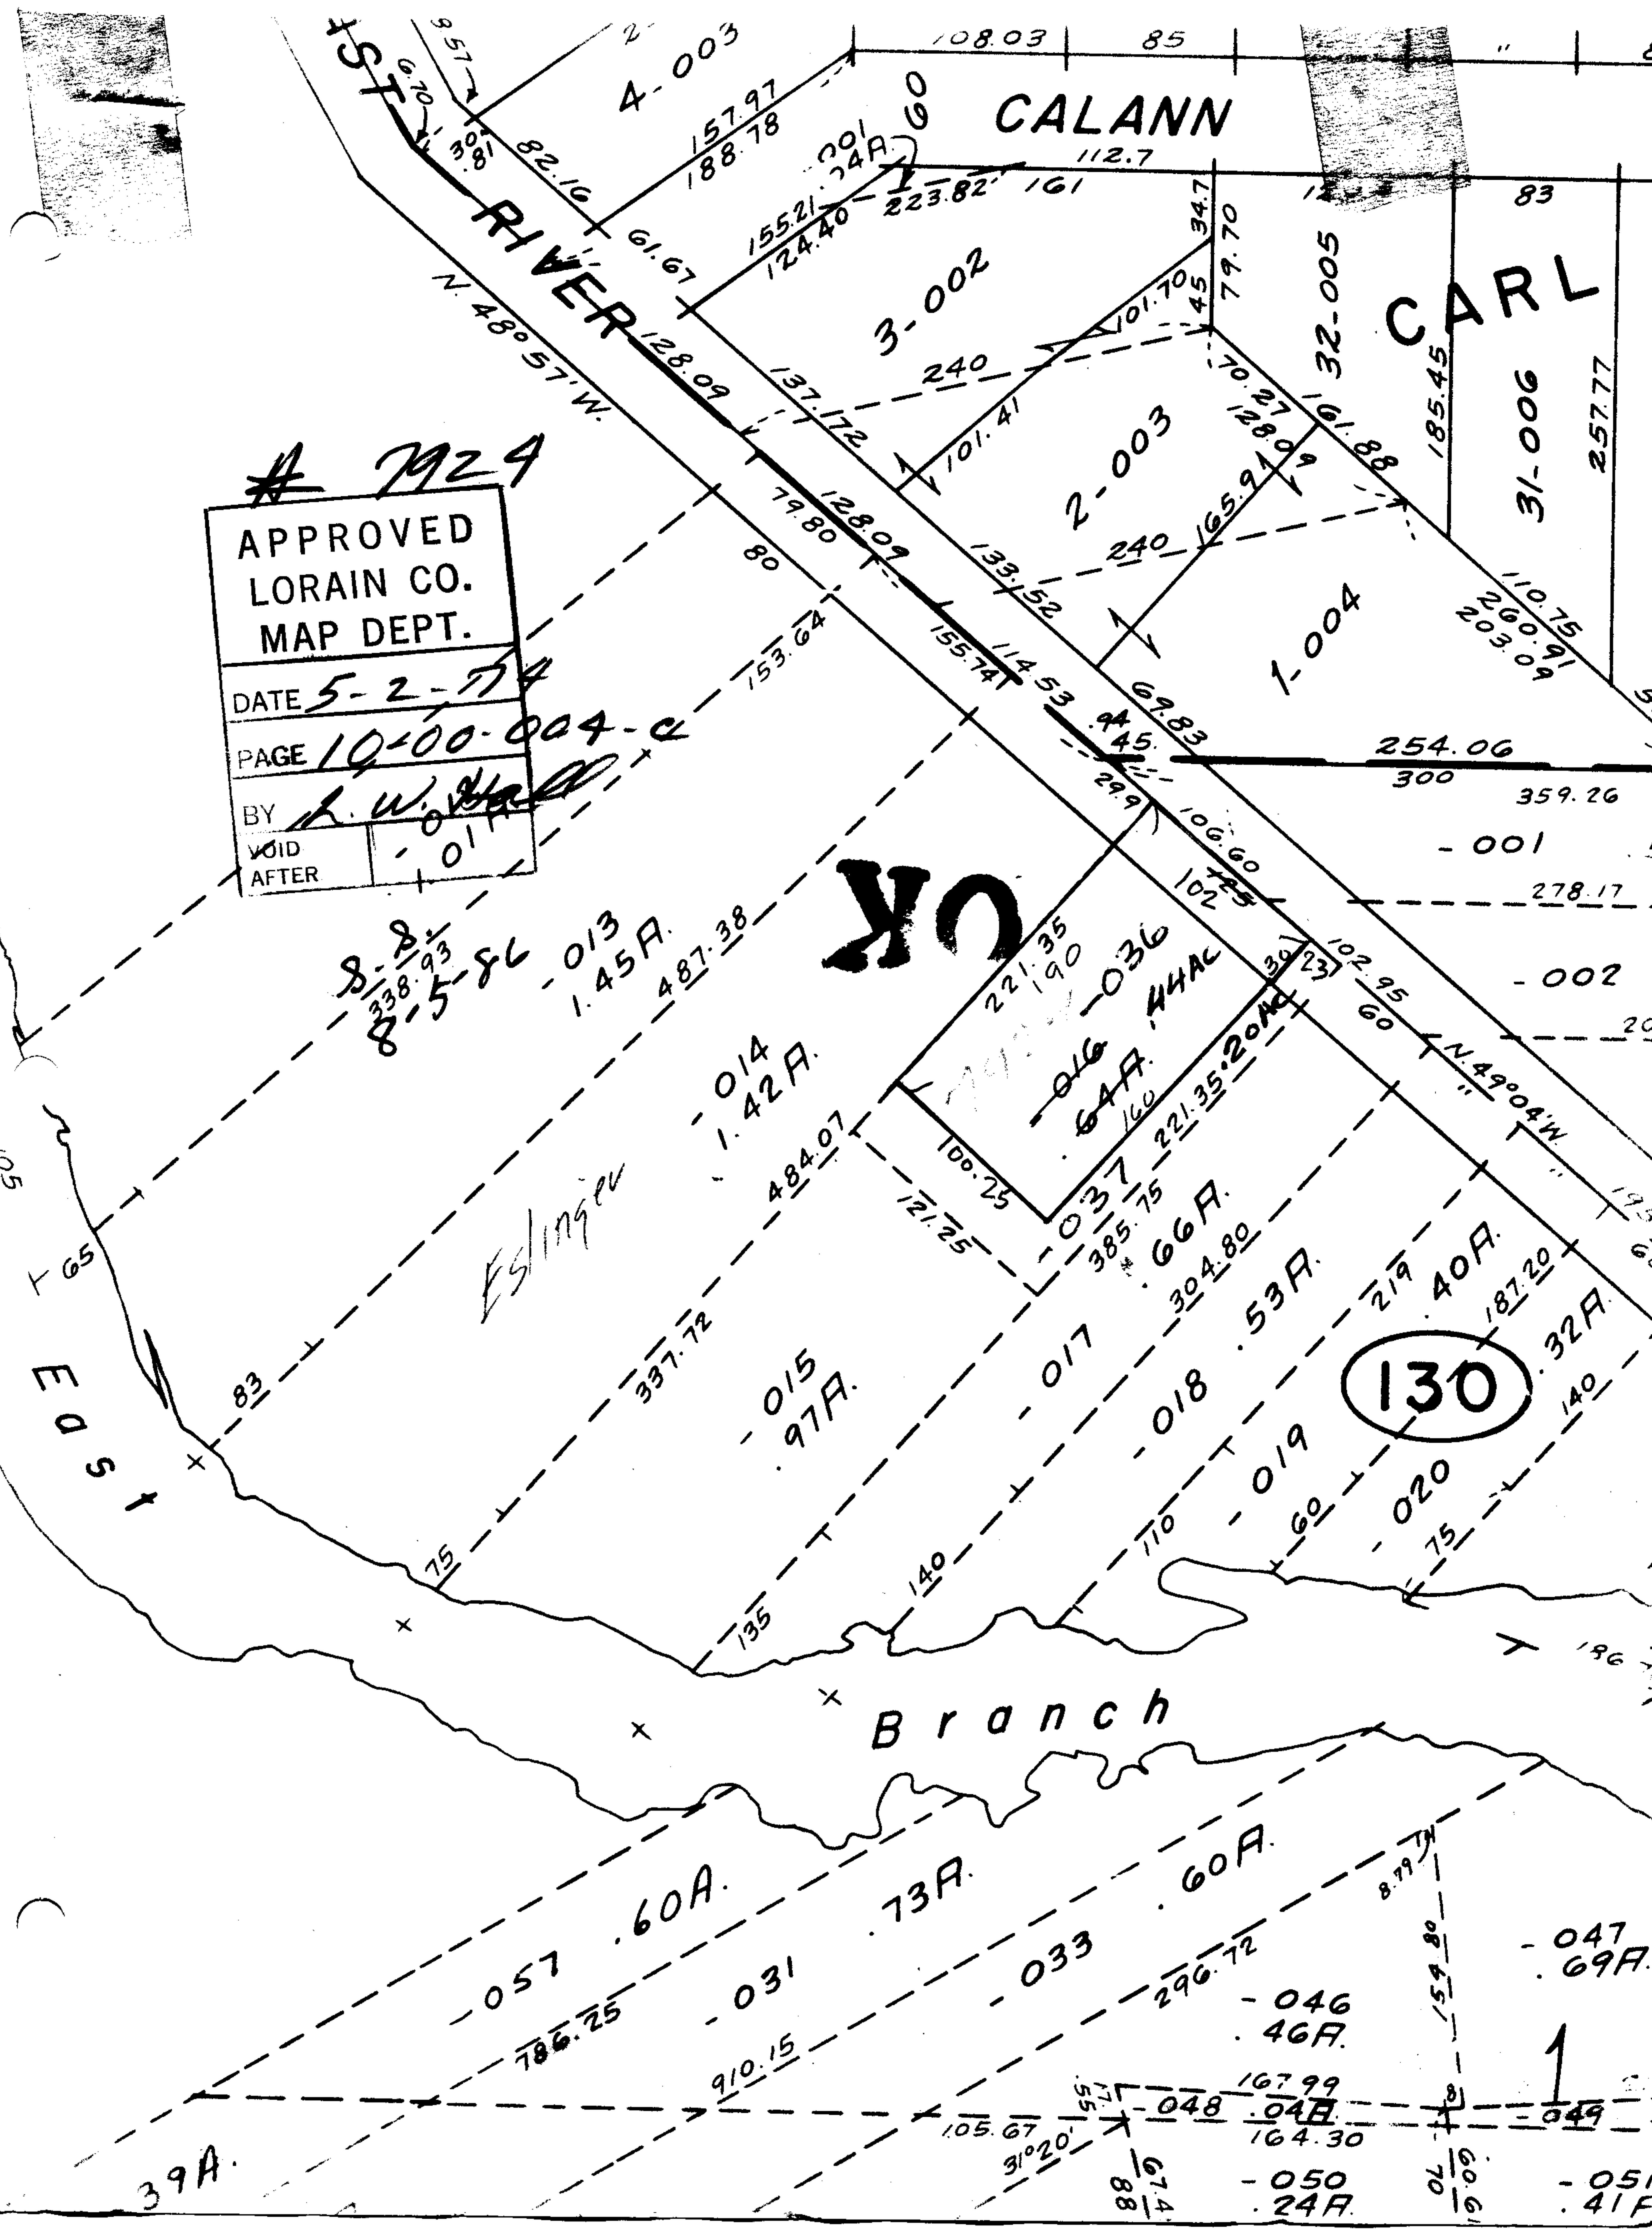


APPROVED  
 LORAIN CO.  
 MAP DEPT.  
 DATE *5-2-74*  
 PAGE *10-00-004-C*  
 BY *R. W. [Signature]*  
 VOID AFTER *10'*

*8-8-86*  
*8-5-86*  
*013*  
*1.45F.*  
*487.38*

**CR**

*Eslinger*

**130**

**Branch**

*39A.*

*67A*

*047*  
*69F.*

*051*  
*41F*