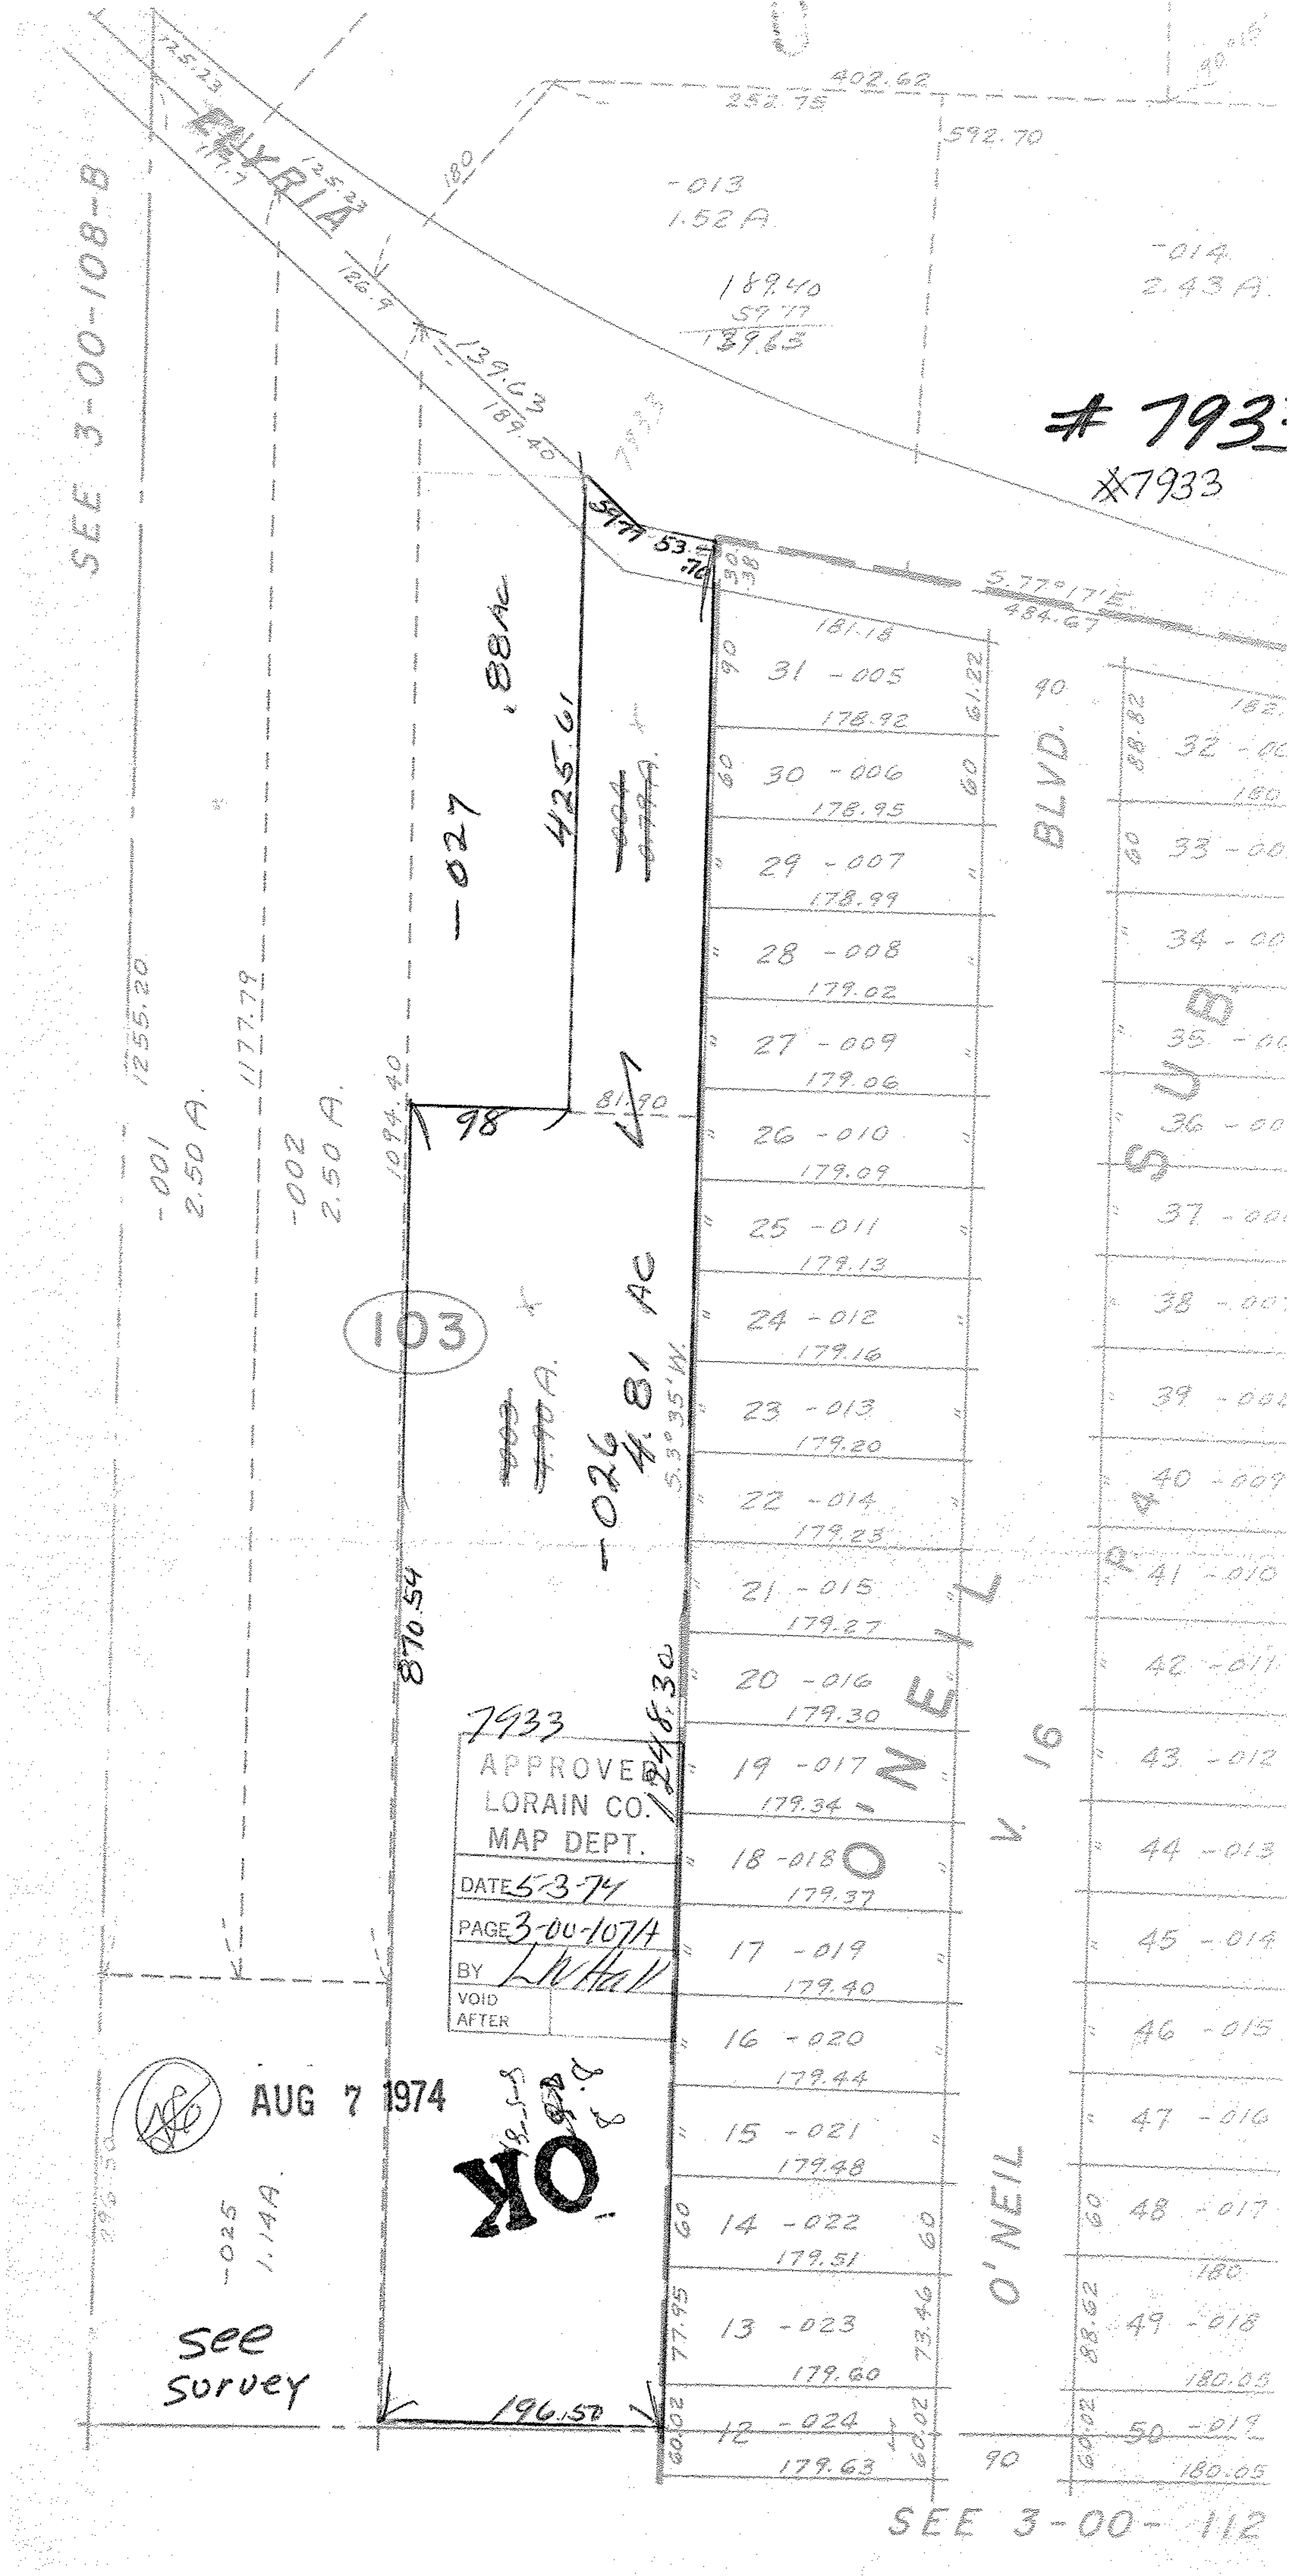

SEE 3-00-108-B
ELYRIA
402.62
252.75
592.70
-013
1.52 A.
-014
2.43 A.
189.40
59.77
139.63
126.9
139.63
189.40
793
#7933
5.77°17'E.
484.67
181.18
31 -005
178.92
30 -006
178.95
29 -007
178.99
28 -008
179.02
27 -009
179.06
26 -010
179.09
25 -011
179.13
24 -012
179.16
23 -013
179.20
22 -014
179.23
21 -015
179.27
20 -016
179.30
19 -017
179.34
18 -018
179.37
17 -019
179.40
16 -020
179.44
15 -021
179.48
14 -022
179.51
13 -023
179.60
12 -024
179.63
32 -00
33 -00
34 -00
35 -00
36 -00
37 -00
38 -00
39 -00
40 -009
41 -010
42 -011
43 -012
44 -013
45 -014
46 -015
47 -016
48 -017
49 -018
180.05
50 -019
180.05
BLVD.
O'NEIL
V. 16
SUB
-027
.88 AC
425.61
98
81.90
1094.40
-026
4.81 AC
S.3°35'W.
870.54
1248.30
103
-001
2.50 A.
-002
2.50 A.
1255.20
1177.79
-025
1.14 A.
196.50
7933
APPROVED
LORAIN CO.
MAP DEPT.
DATE 5-3-74
PAGE 3-00-107A
BY LWHall
VOID AFTER
AUG 7 1974
OK
see survey
SEE 3-00-112