

7934

7934

APPROVED  
LORAIN CO.  
MAP DEPT.


DATE 5-3-74

PAGE 7A; 7-00-043C

BY L.W. Hall

VOID  
AFTER

AUG 7 1974

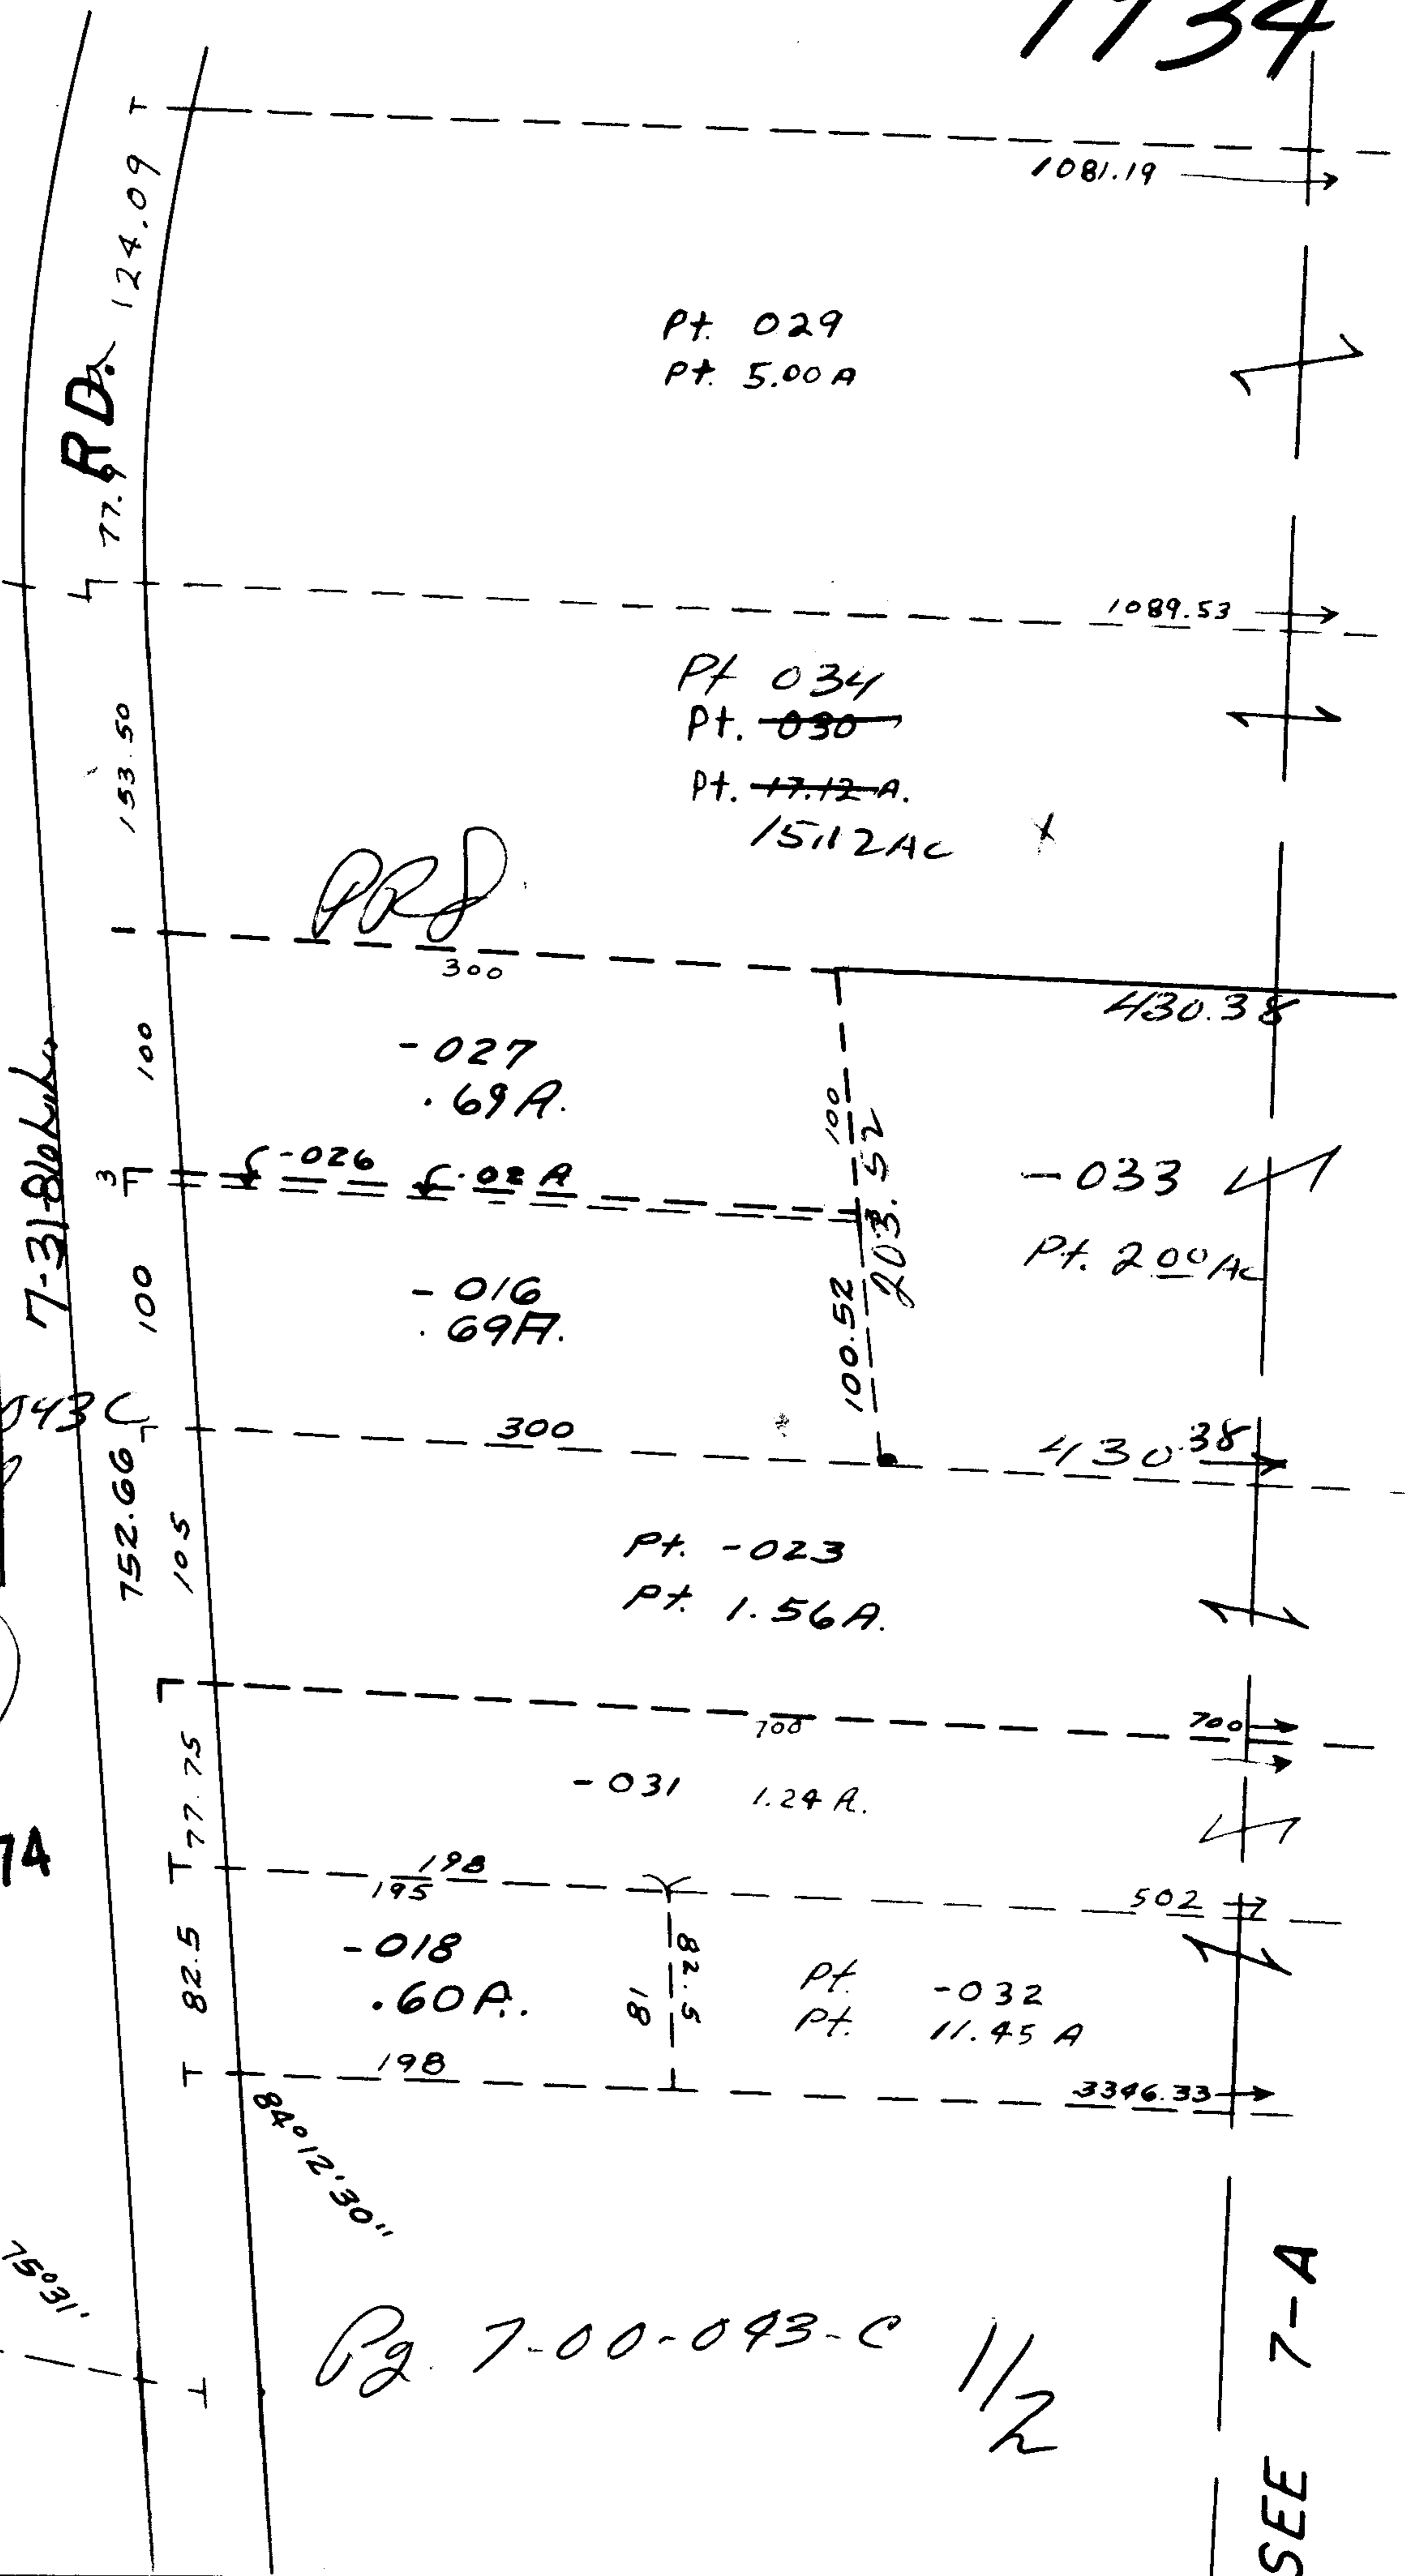

SEE 7-A