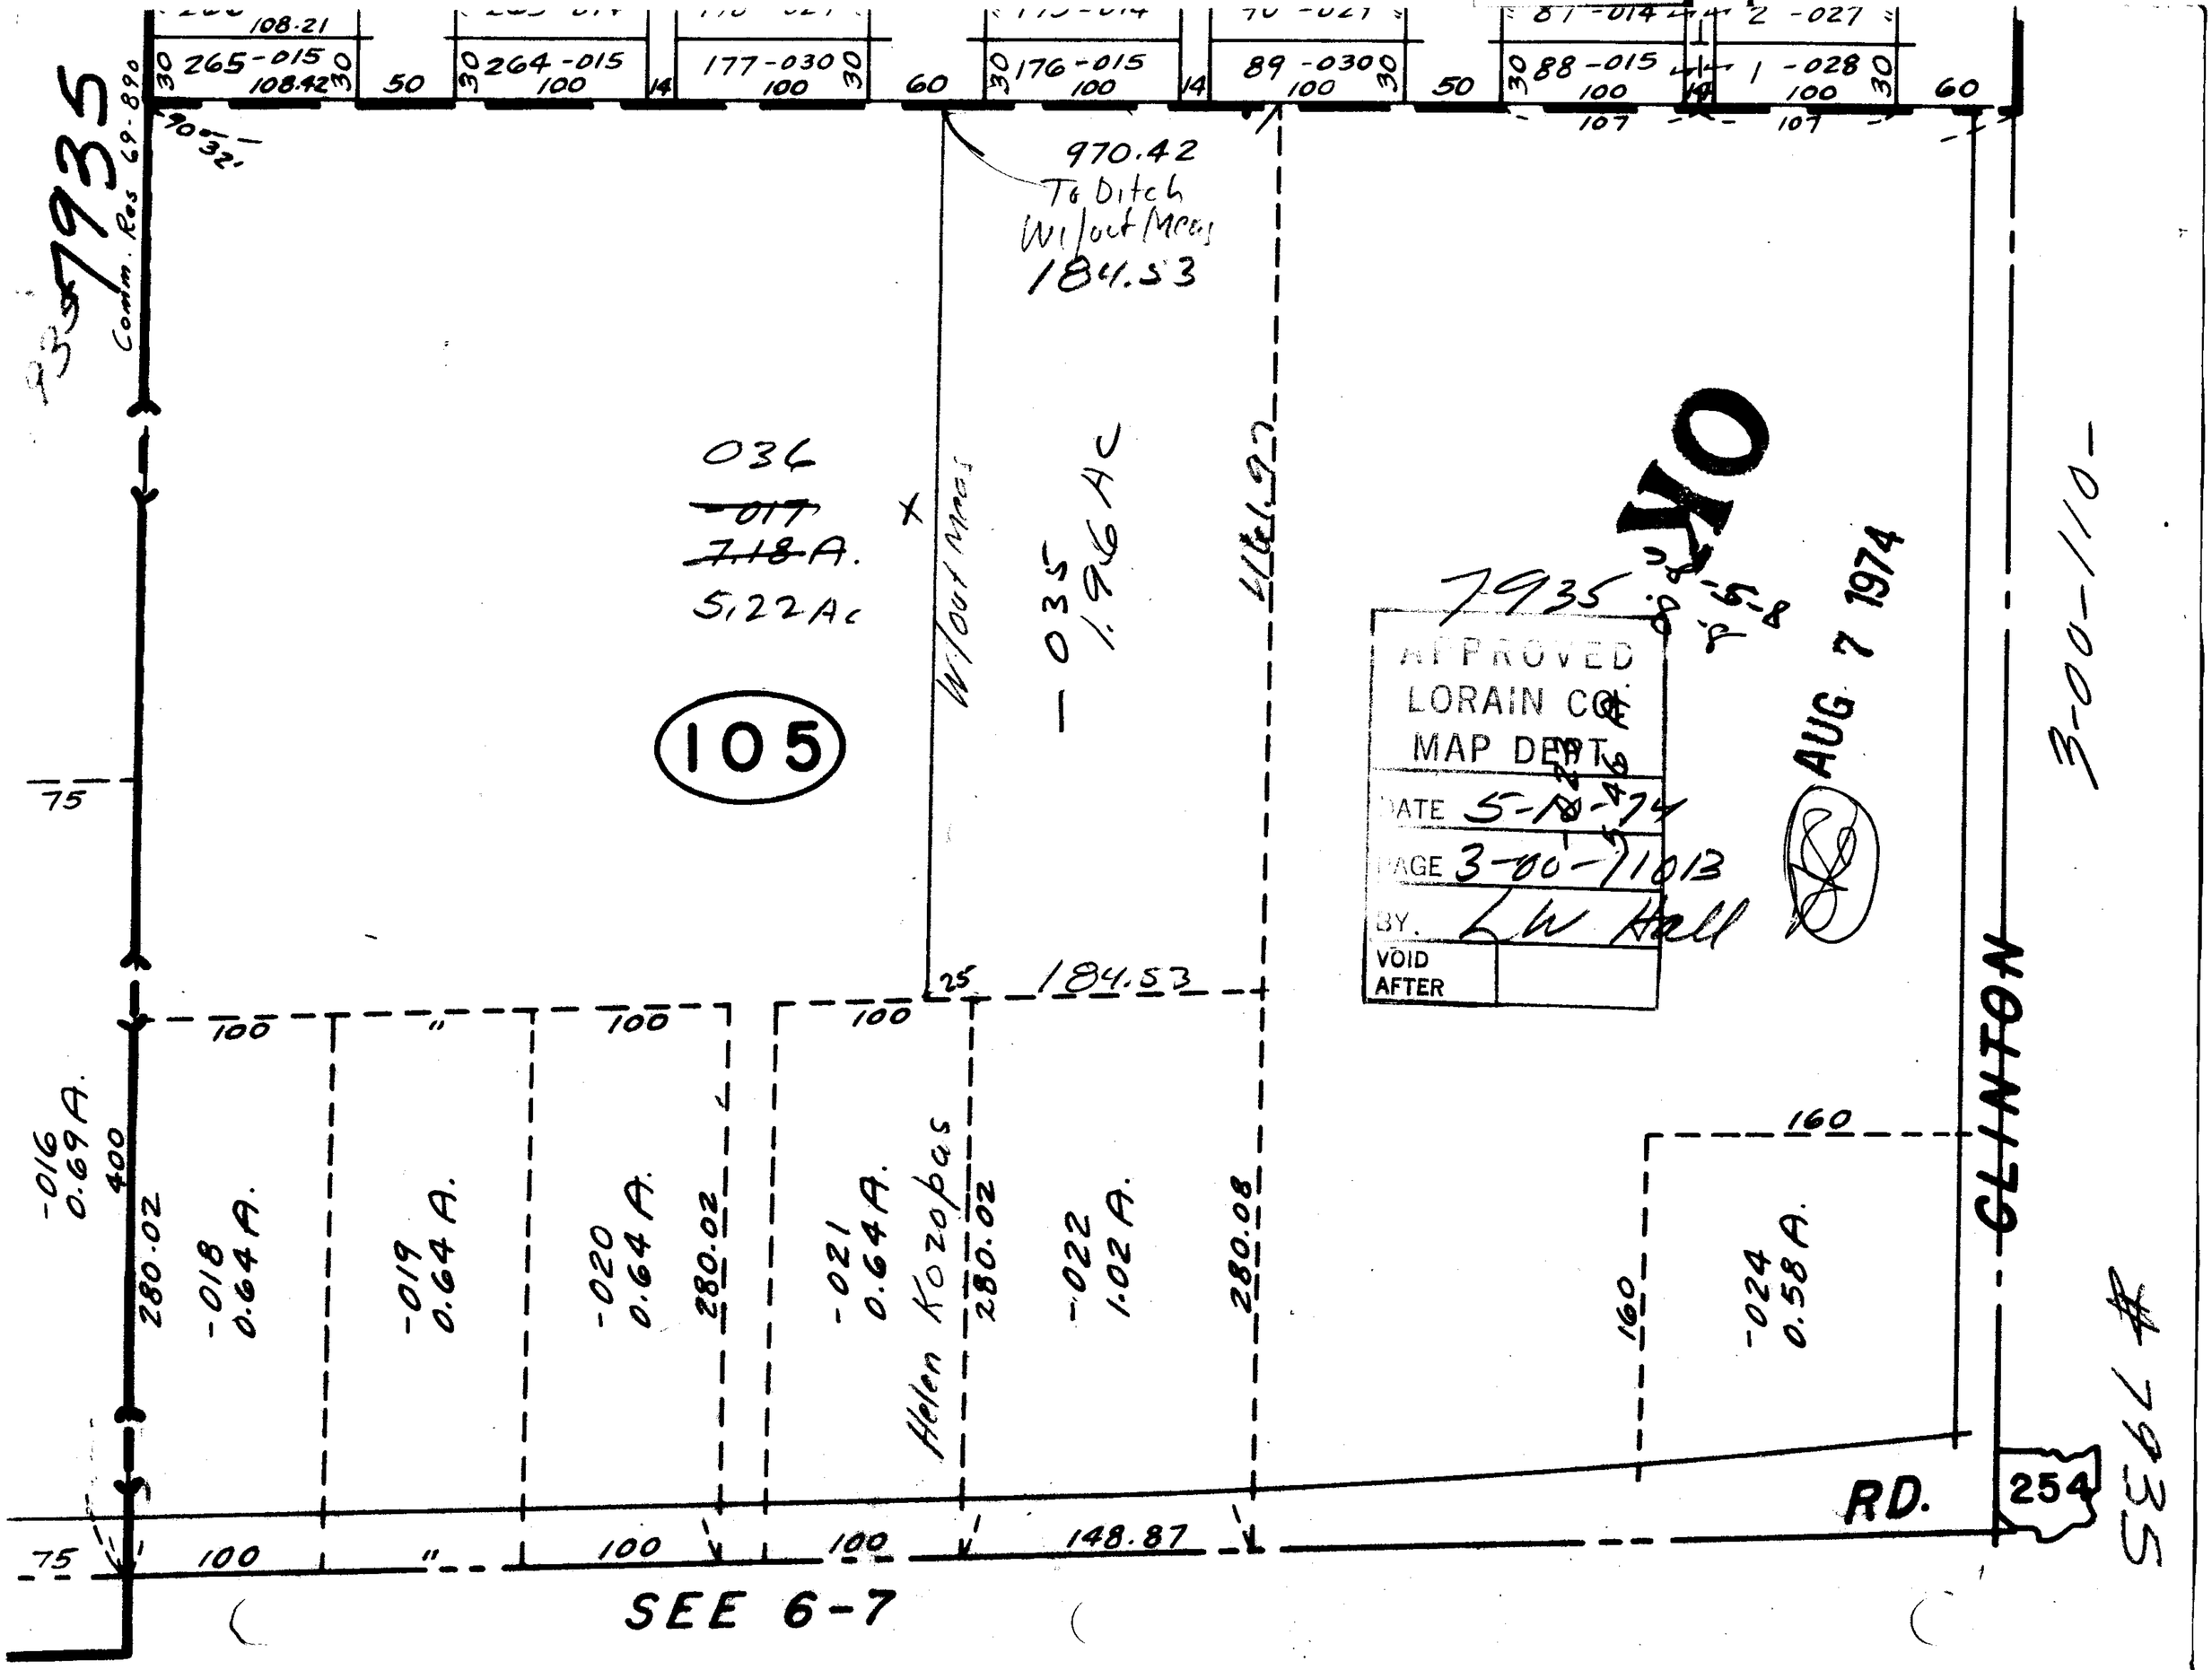

7935
Comm. Res 69-890
108.21
265-015
108.42
264-015
177-030
176-015
89-030
88-015
2-027
1-028
970.42
To Ditch
W/out Meas
184.53
036
~~-017~~
~~7.18~~ A.
5.22 Ac
W/out Meas
-035
1.96 Ac
105
7935
APPROVED
LORAIN CO.
MAP DEPT.
DATE 5-10-74
PAGE 3-00-11013
BY. L W Hall
VOID AFTER
AUG 7 1974
3-00-110-
CLINTON
-016
0.69 A.
-018
0.64 A.
-019
0.64 A.
-020
0.64 A.
-021
0.64 A.
Helen Kozopas
-022
1.02 A.
-024
0.58 A.
280.02
280.08
148.87
RD.
254
SEE 6-7