


7940

FR

PARK

Co. Comm Res

254

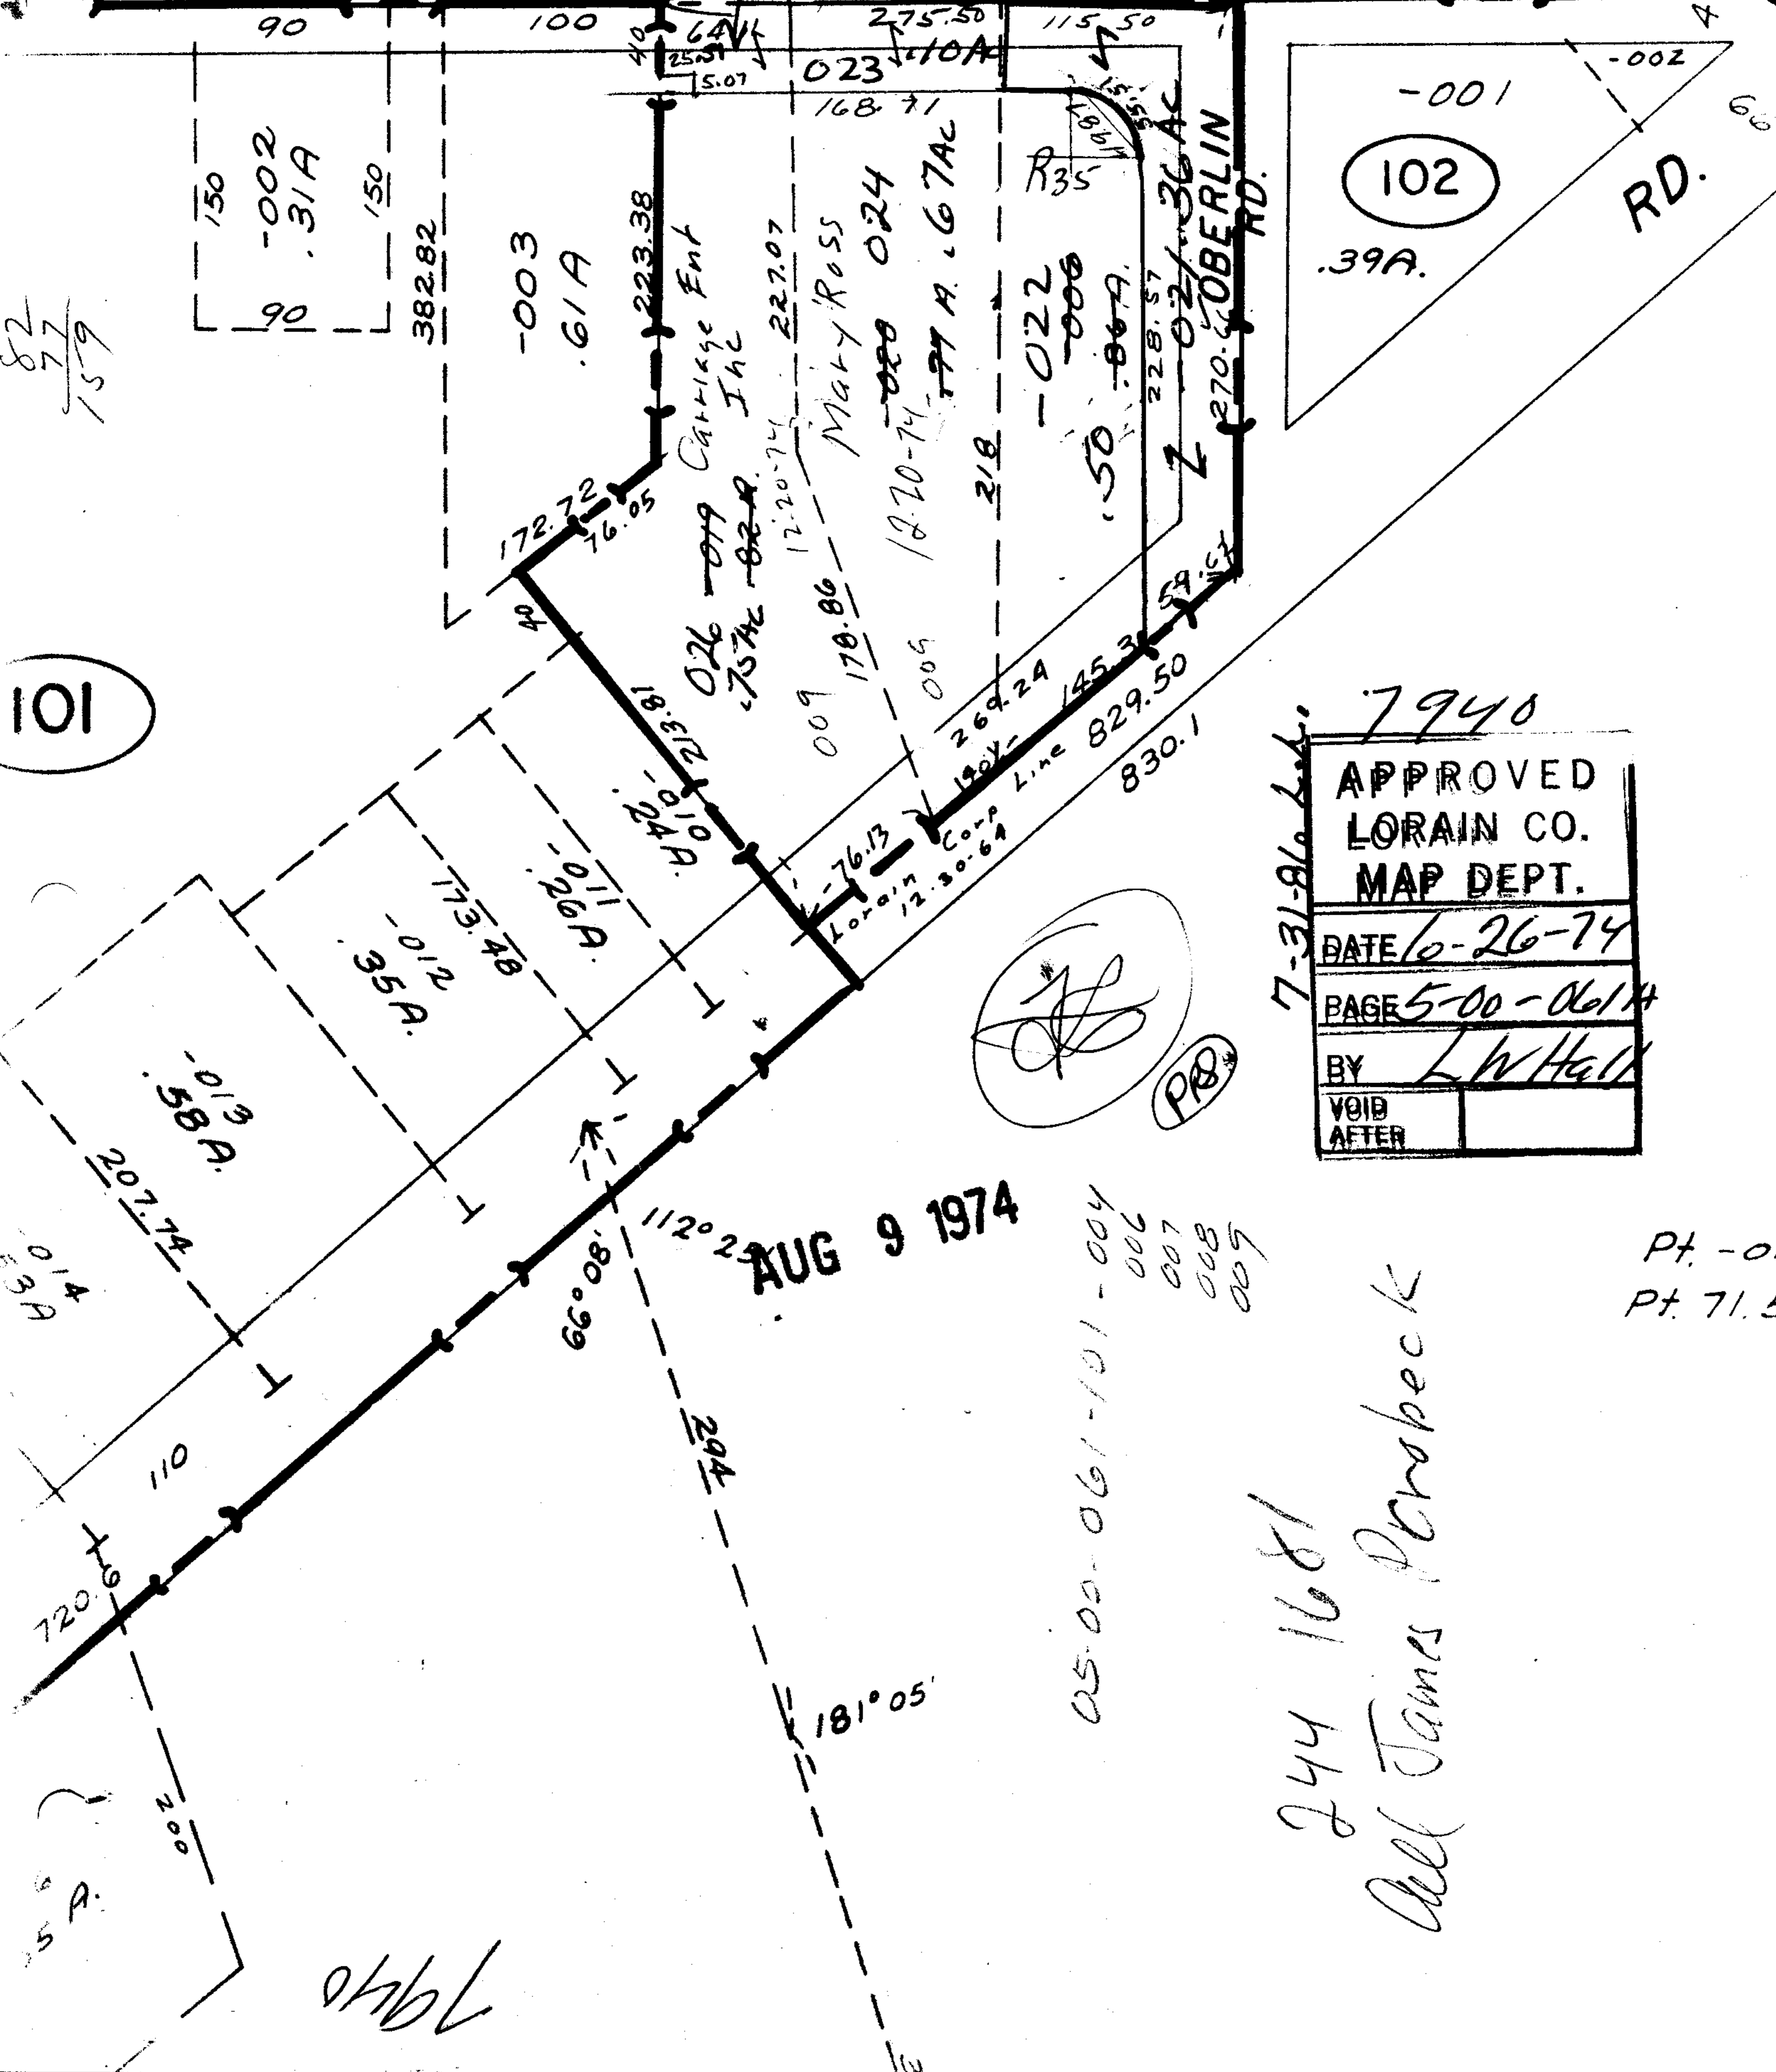

7940

APPROVED  
LORAIN CO.  
MAP DEPT.

DATE 6-26-74

PAGE 5-00-061A

BY LWH

VOID  
AFTER

AUG 9 1974

05-02-061-101-004  
 006  
 007  
 008  
 009

244 1681  
 All James Pirobeck

Pt. -010  
 Pt. 71.5

7940