

03-00-033 74
 005- 50
 006- 50
 007- 4516
 008- 14516
 009- 130
 1516


42
 26.22
 68.22
 45.22
 23.22

7946

50.00

243.91
 1-0
 213.91

SEE 3-00-034-A

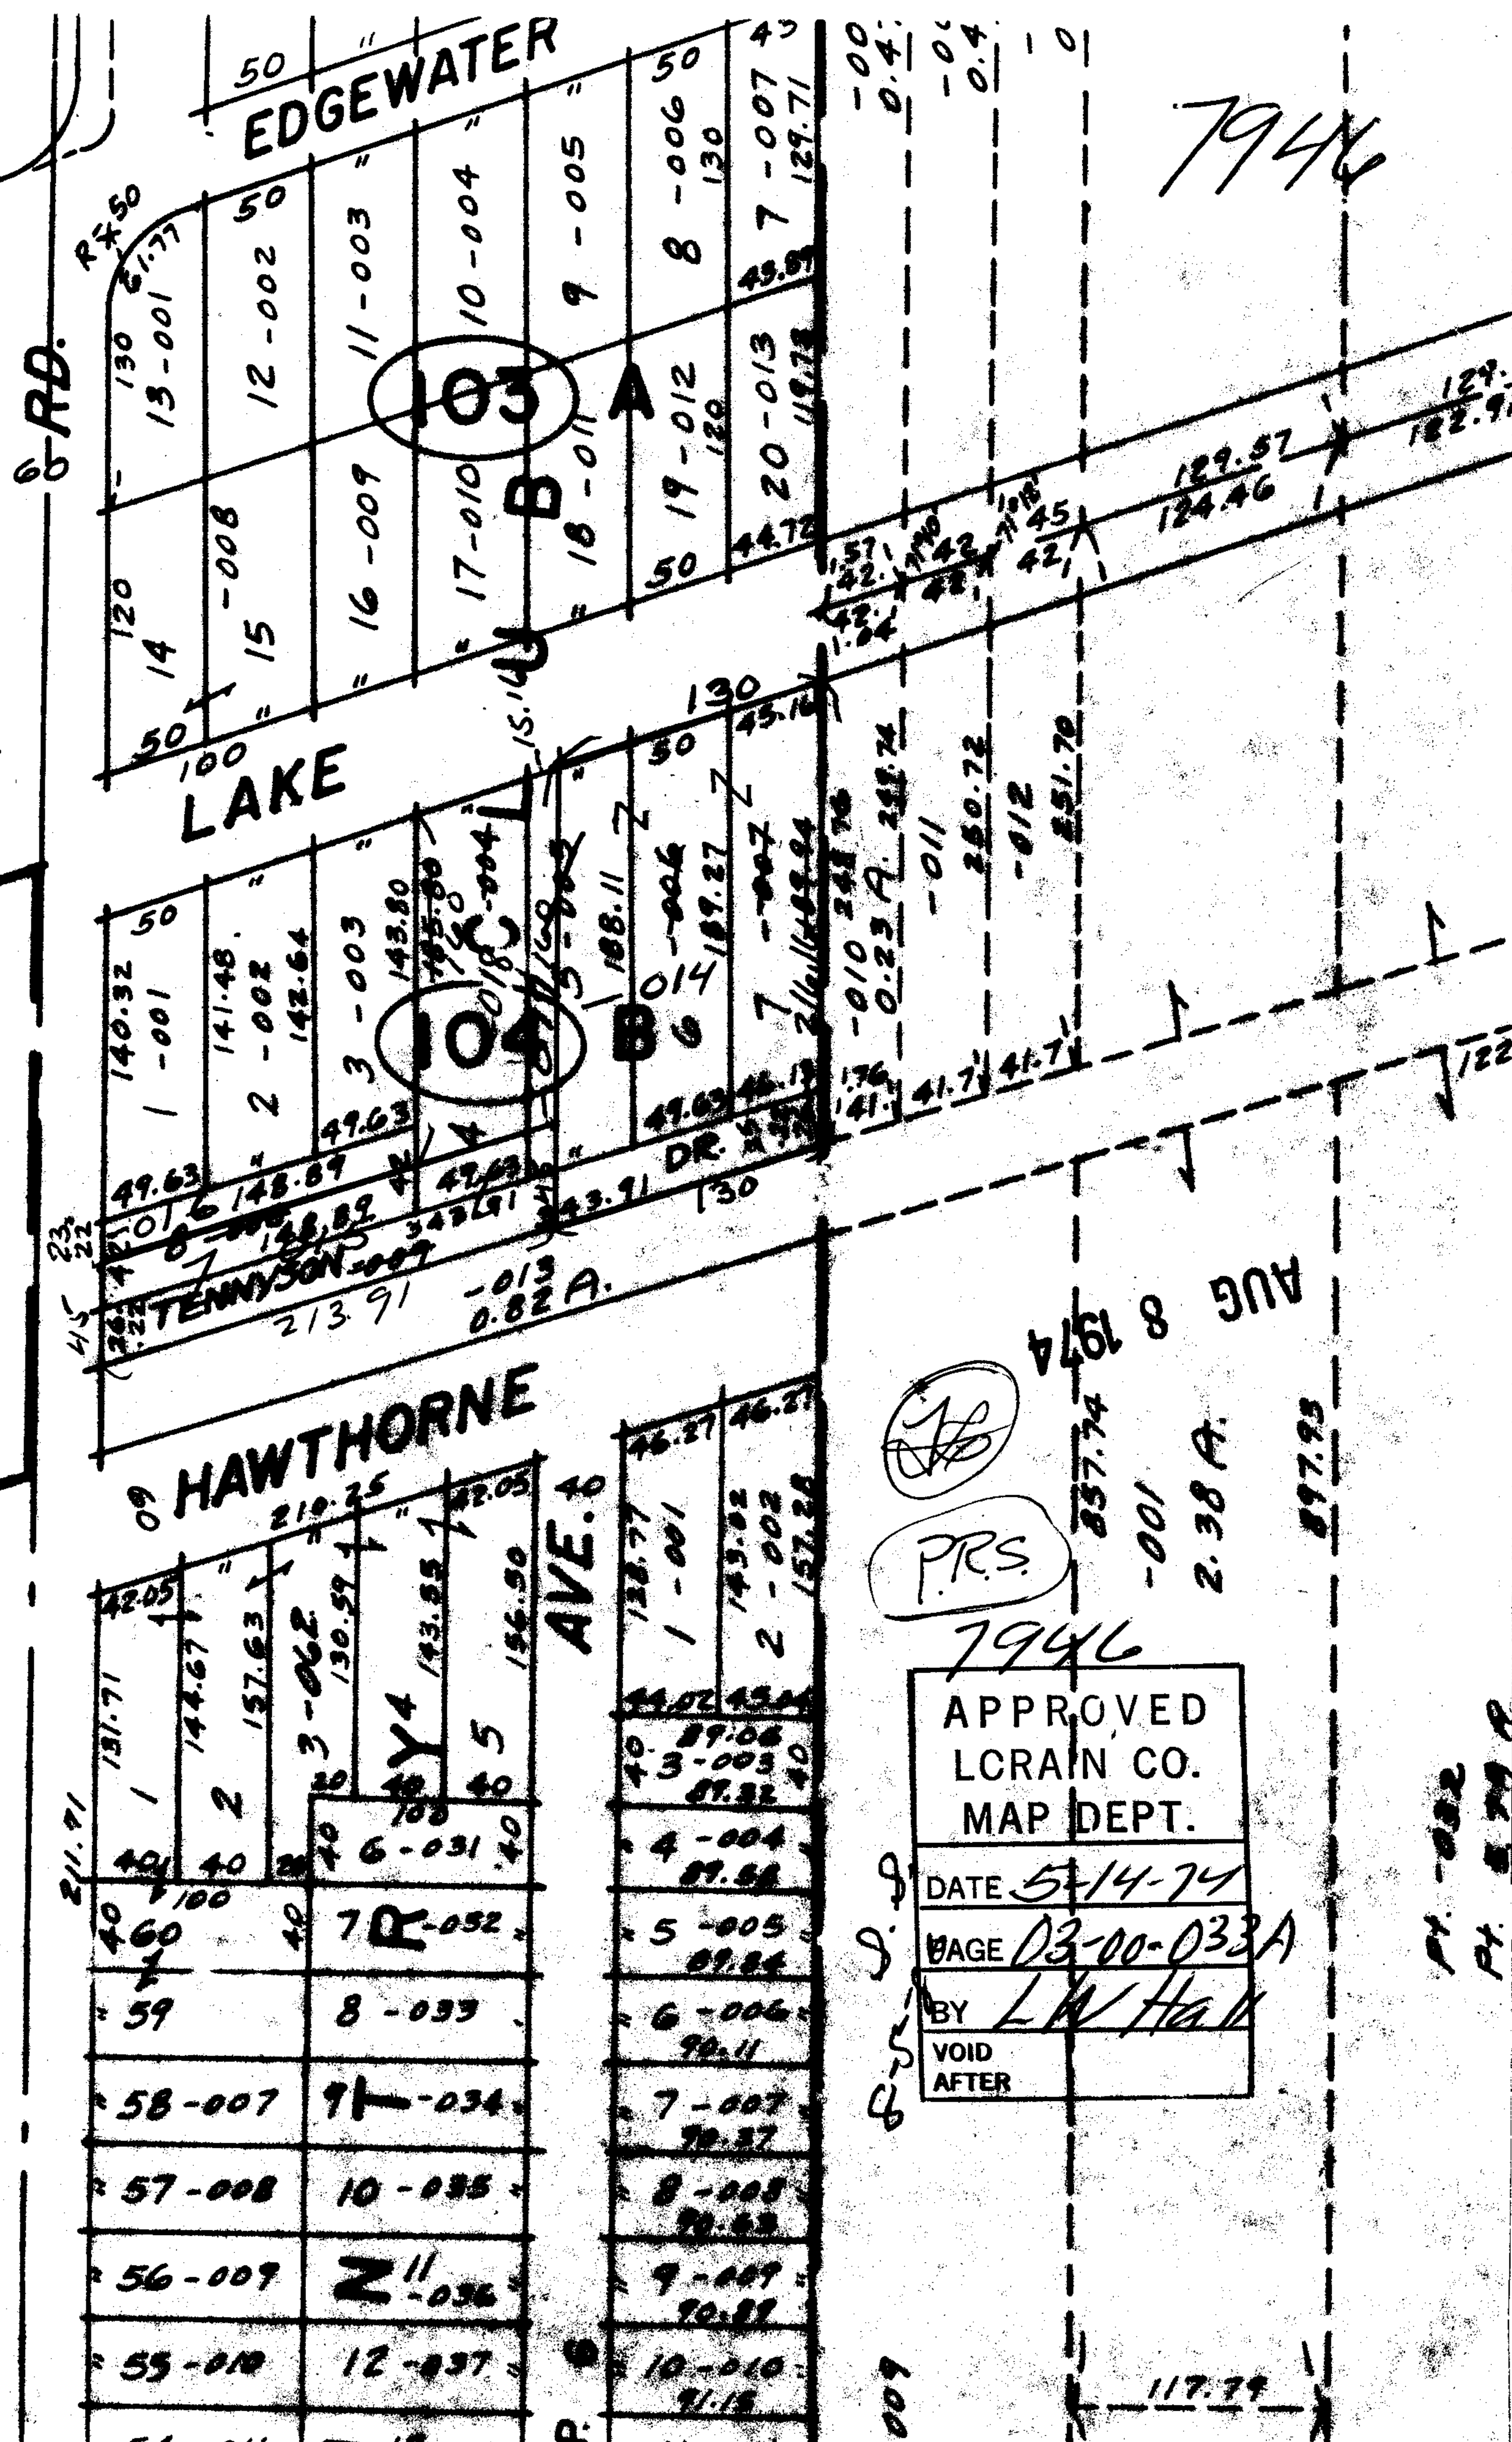

7946

PR.S.

APPROVED
 LCRAIN CO.
 MAP DEPT.
 DATE 5-14-74
 PAGE 03-00-033A
 BY L.W. Hall
 VOID AFTER

AUG 8 1974

8-5-74

009

PT. -002
 PT. 579.8

117.79