


7953
 APPROVED
 LORAIN CO.
 MAP DEPT.
 DATE 5-13-74
 PAGE 11B
 BY *LW Hall*
 VOID
 AFTER

SEE 11-00-010

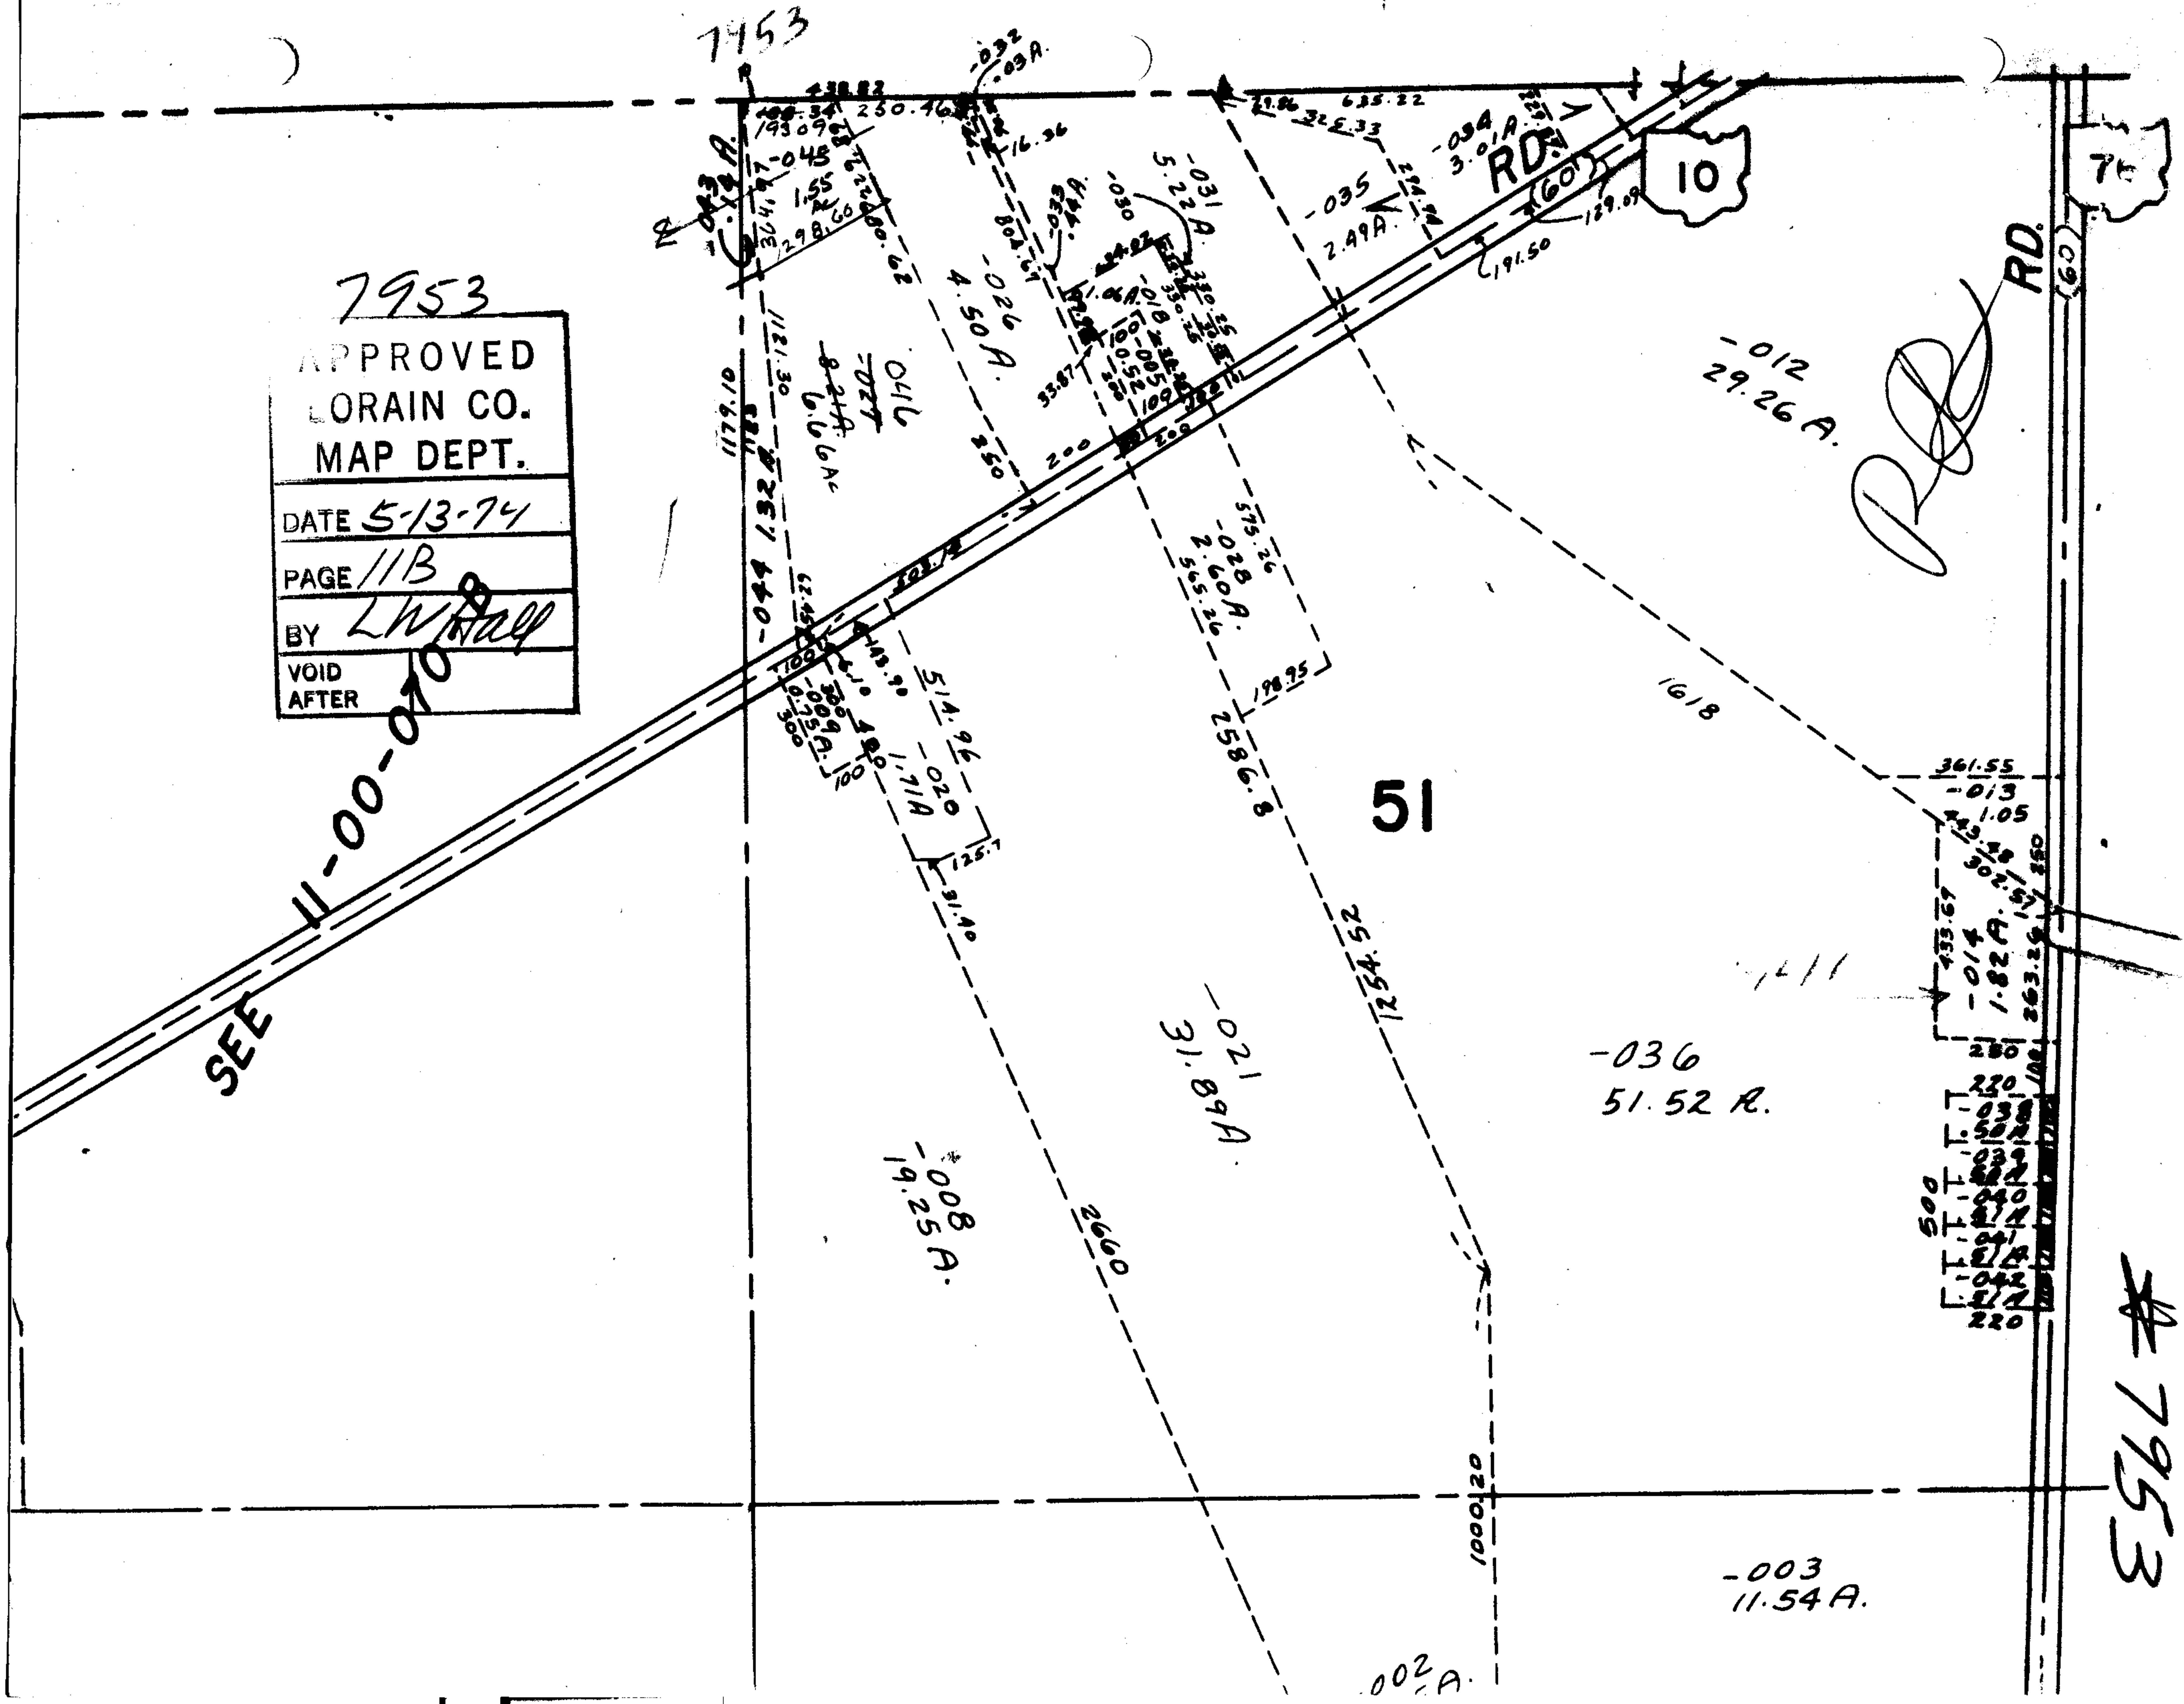

7953