


1965 RD. 7965

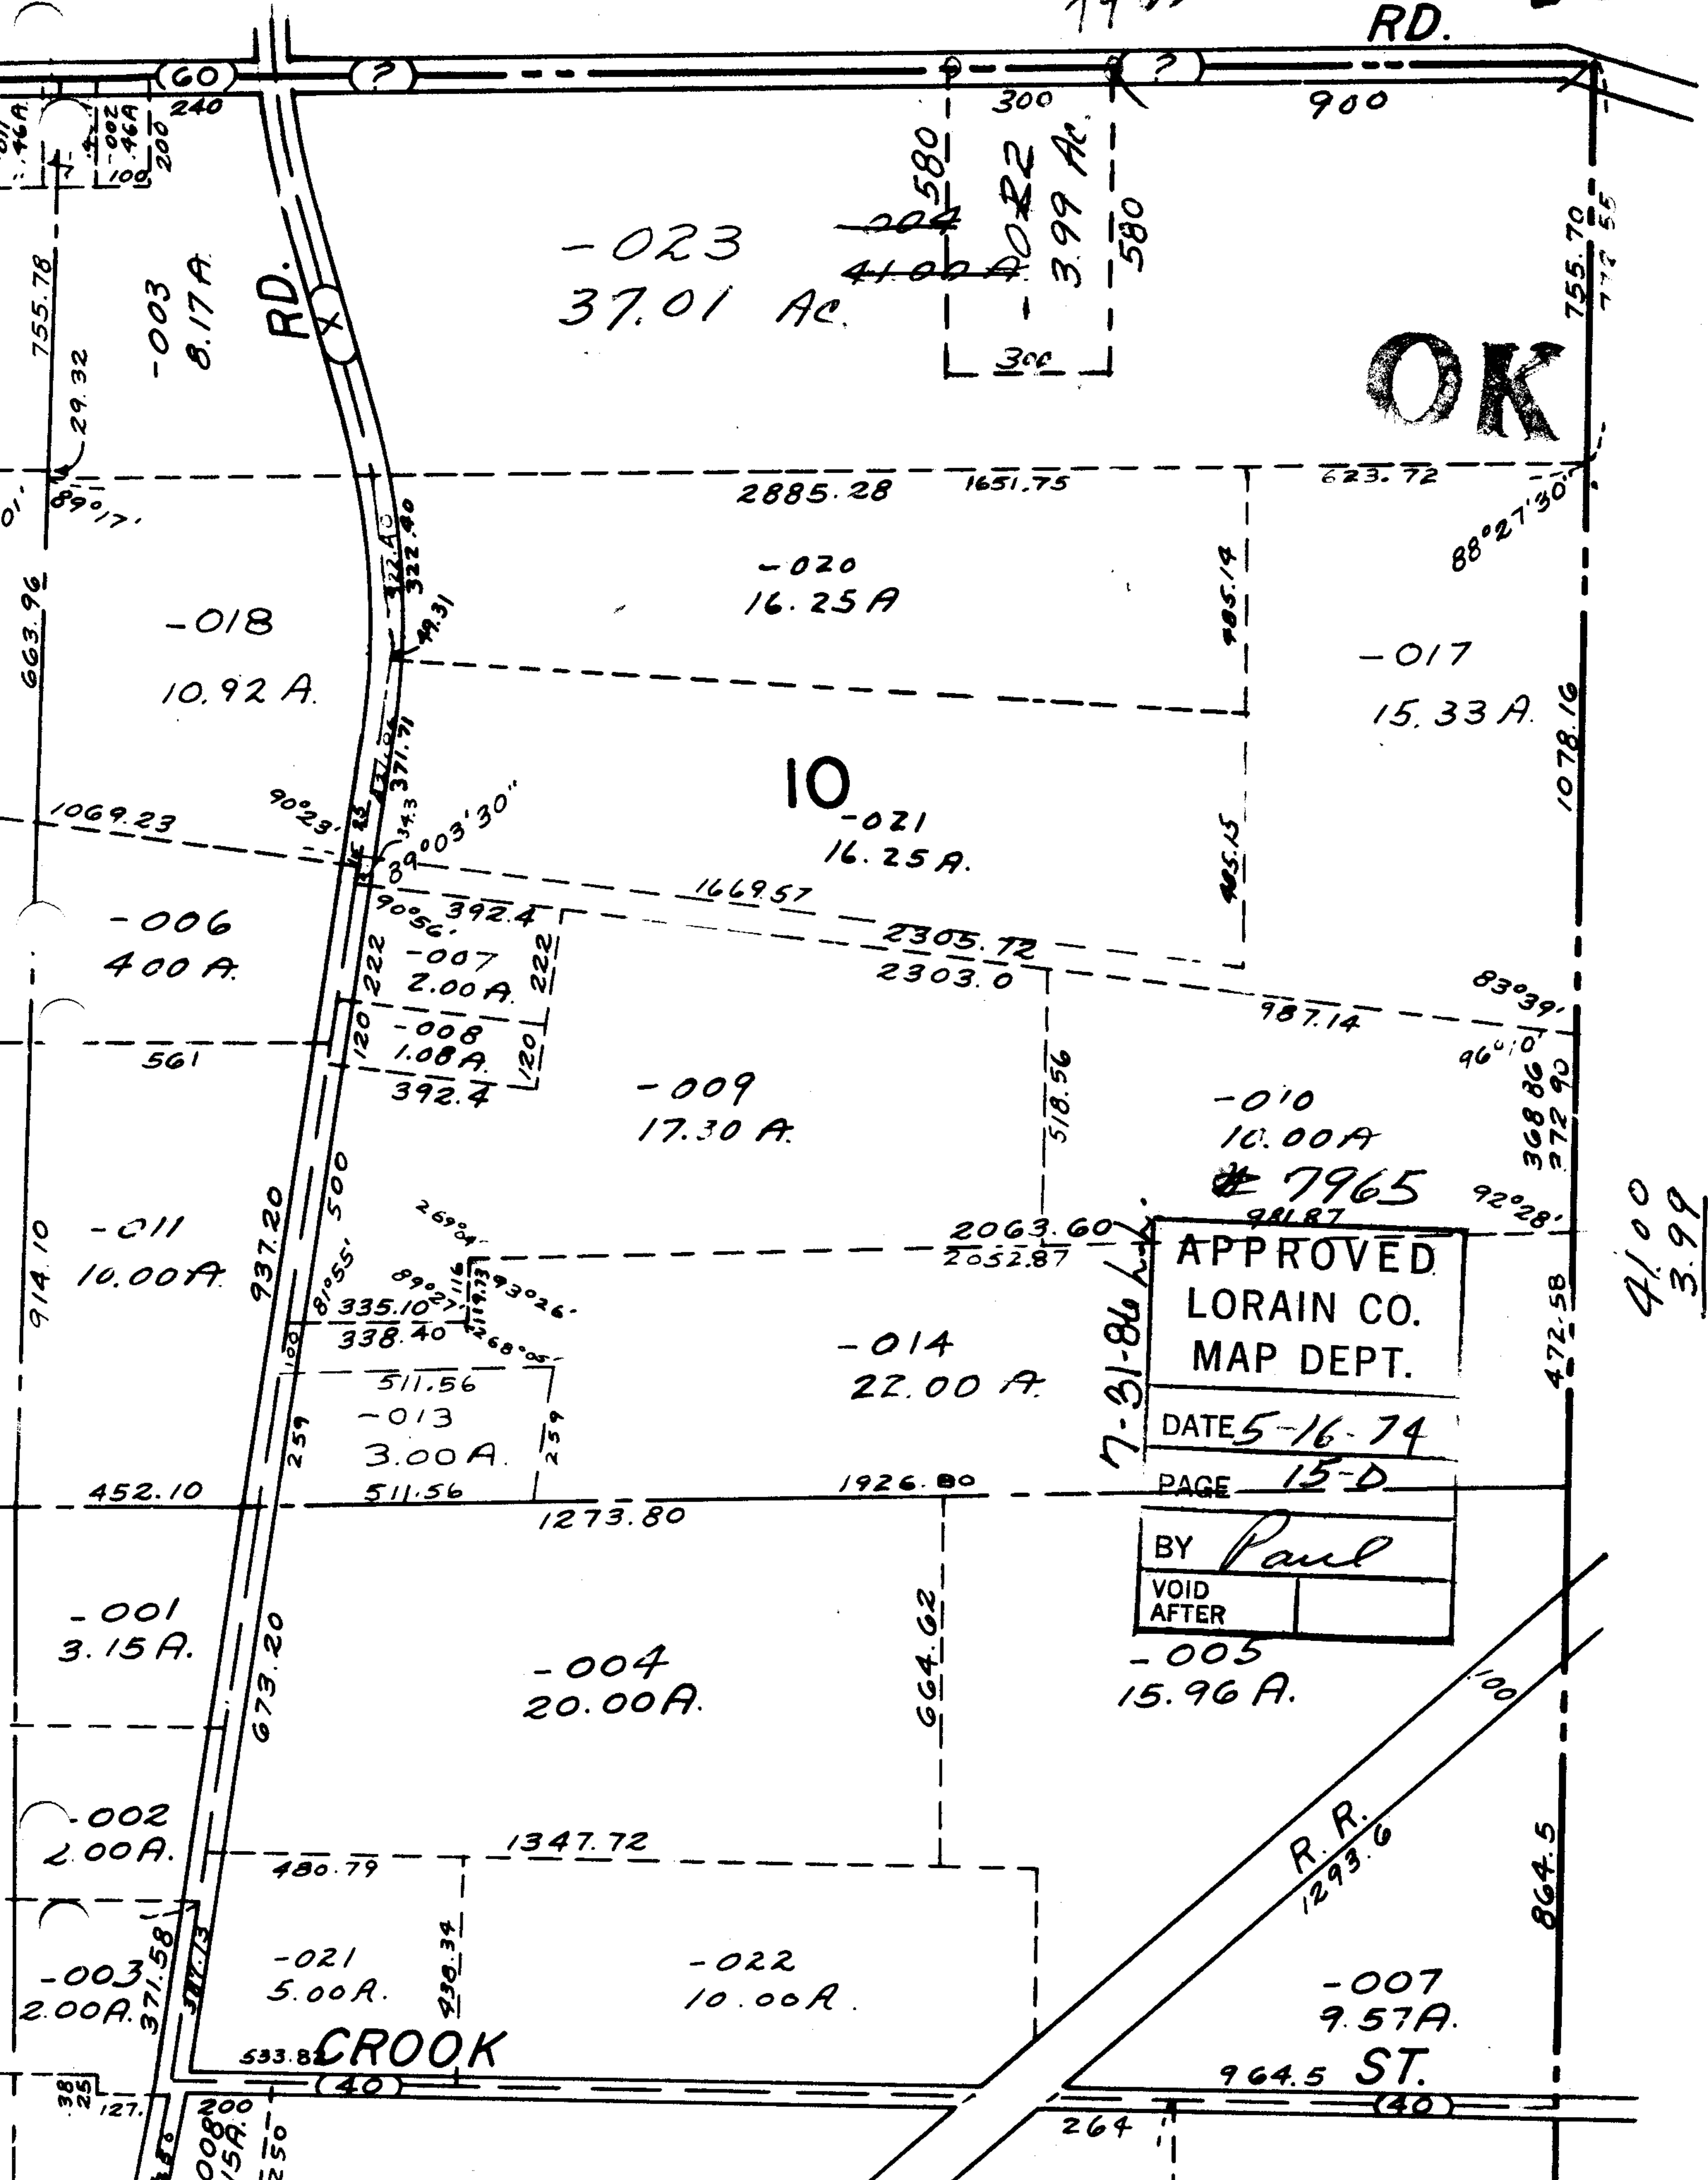

OK

10

APPROVED
LORAIN CO.
MAP DEPT.
DATE 5-16-74
PAGE 15-D
BY Paul
VOID AFTER

41.00
3.99
37.01

CROOK

964.5 ST.

R.R.