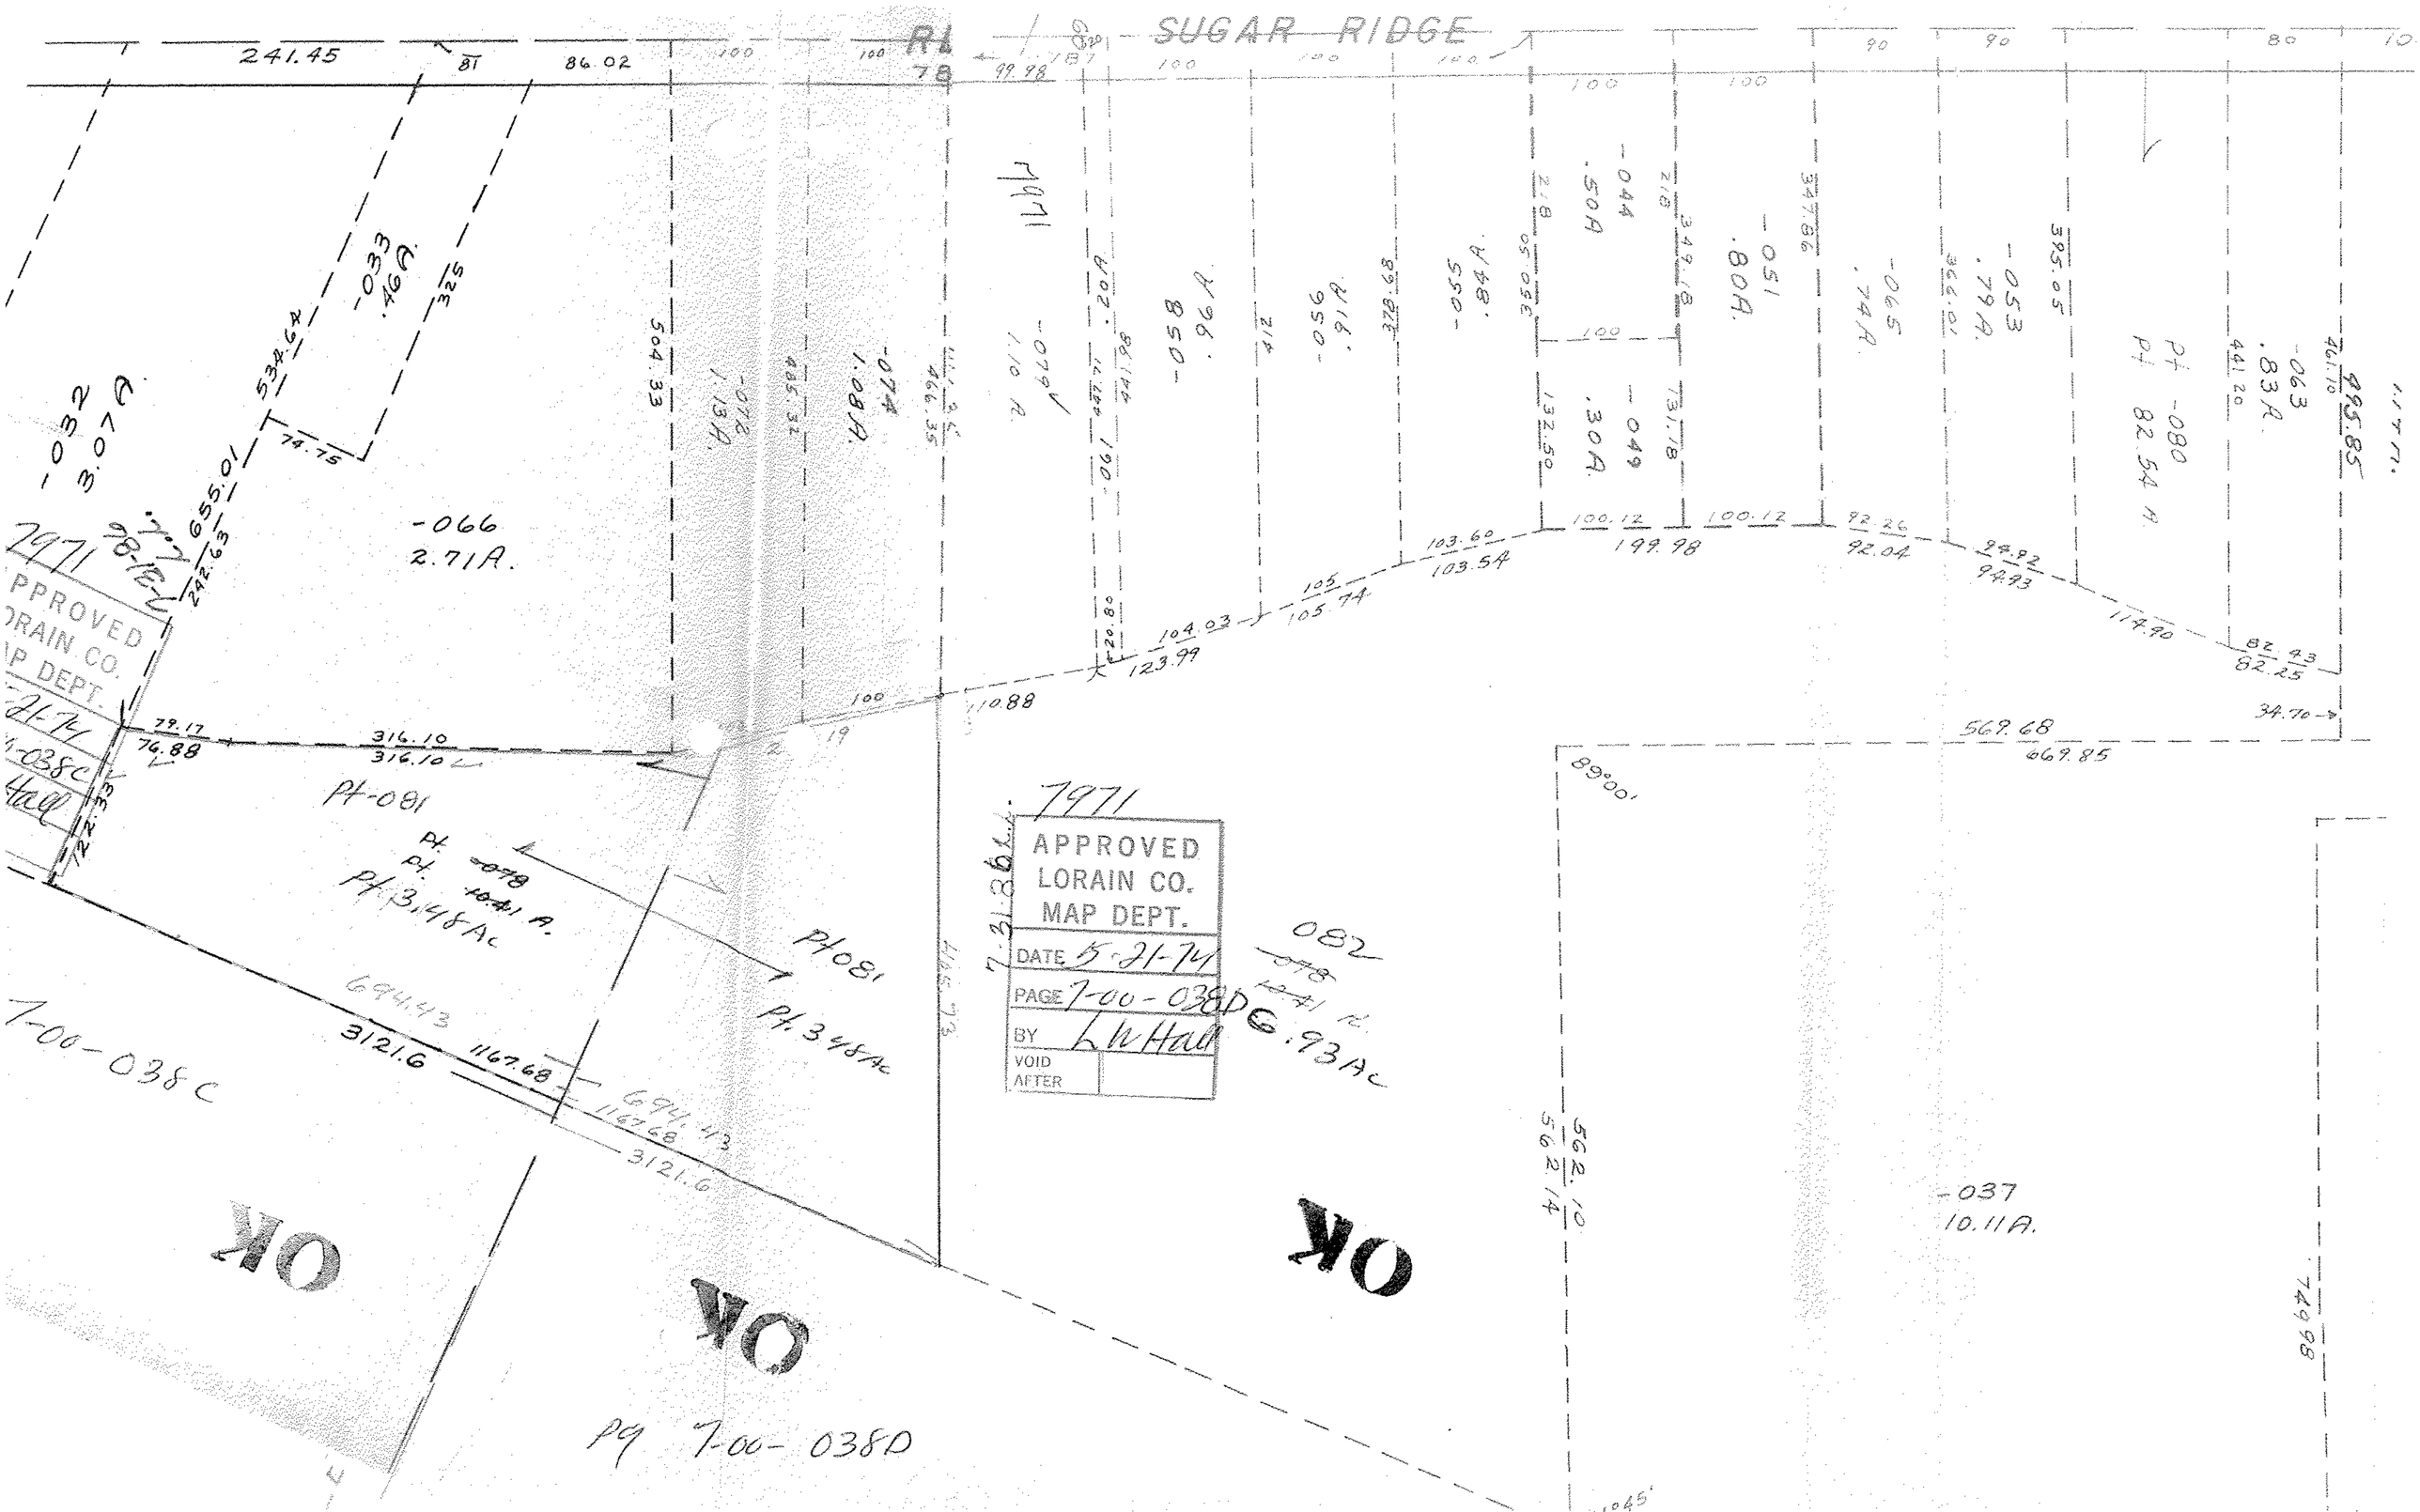
SUGAR RIDGE
241.45
86.02
99.98
-033
.46A.
-032
3.07A.
-066
2.71A.
-072
1.13A.
-074
1.08A.
-079
1.10 A.
-058
.96A.
-056
.91A.
-055
.84A.
-044
.50A.
-049
.30A.
-051
.80A.
-065
.74A.
-053
.79A.
-063
.83A.
Pt -080
Pt 82.54 A.
7971
APPROVED
LORAIN CO.
MAP DEPT.
DATE 5-21-74
PAGE 7-00-038D
BY L W Hall
VOID AFTER
7971
APPROVED
LORAIN CO.
MAP DEPT.
Pt-081
Pt 3.48Ac
Pt 081
Pt 3.48Ac
7-00-038C
3121.6
1167.68
694.43
082
6.93Ac
-037
10.11A.
OK
OK
OK
Pg 7-00-038D
569.68
669.85
89°00'
562.10
562.14
74998