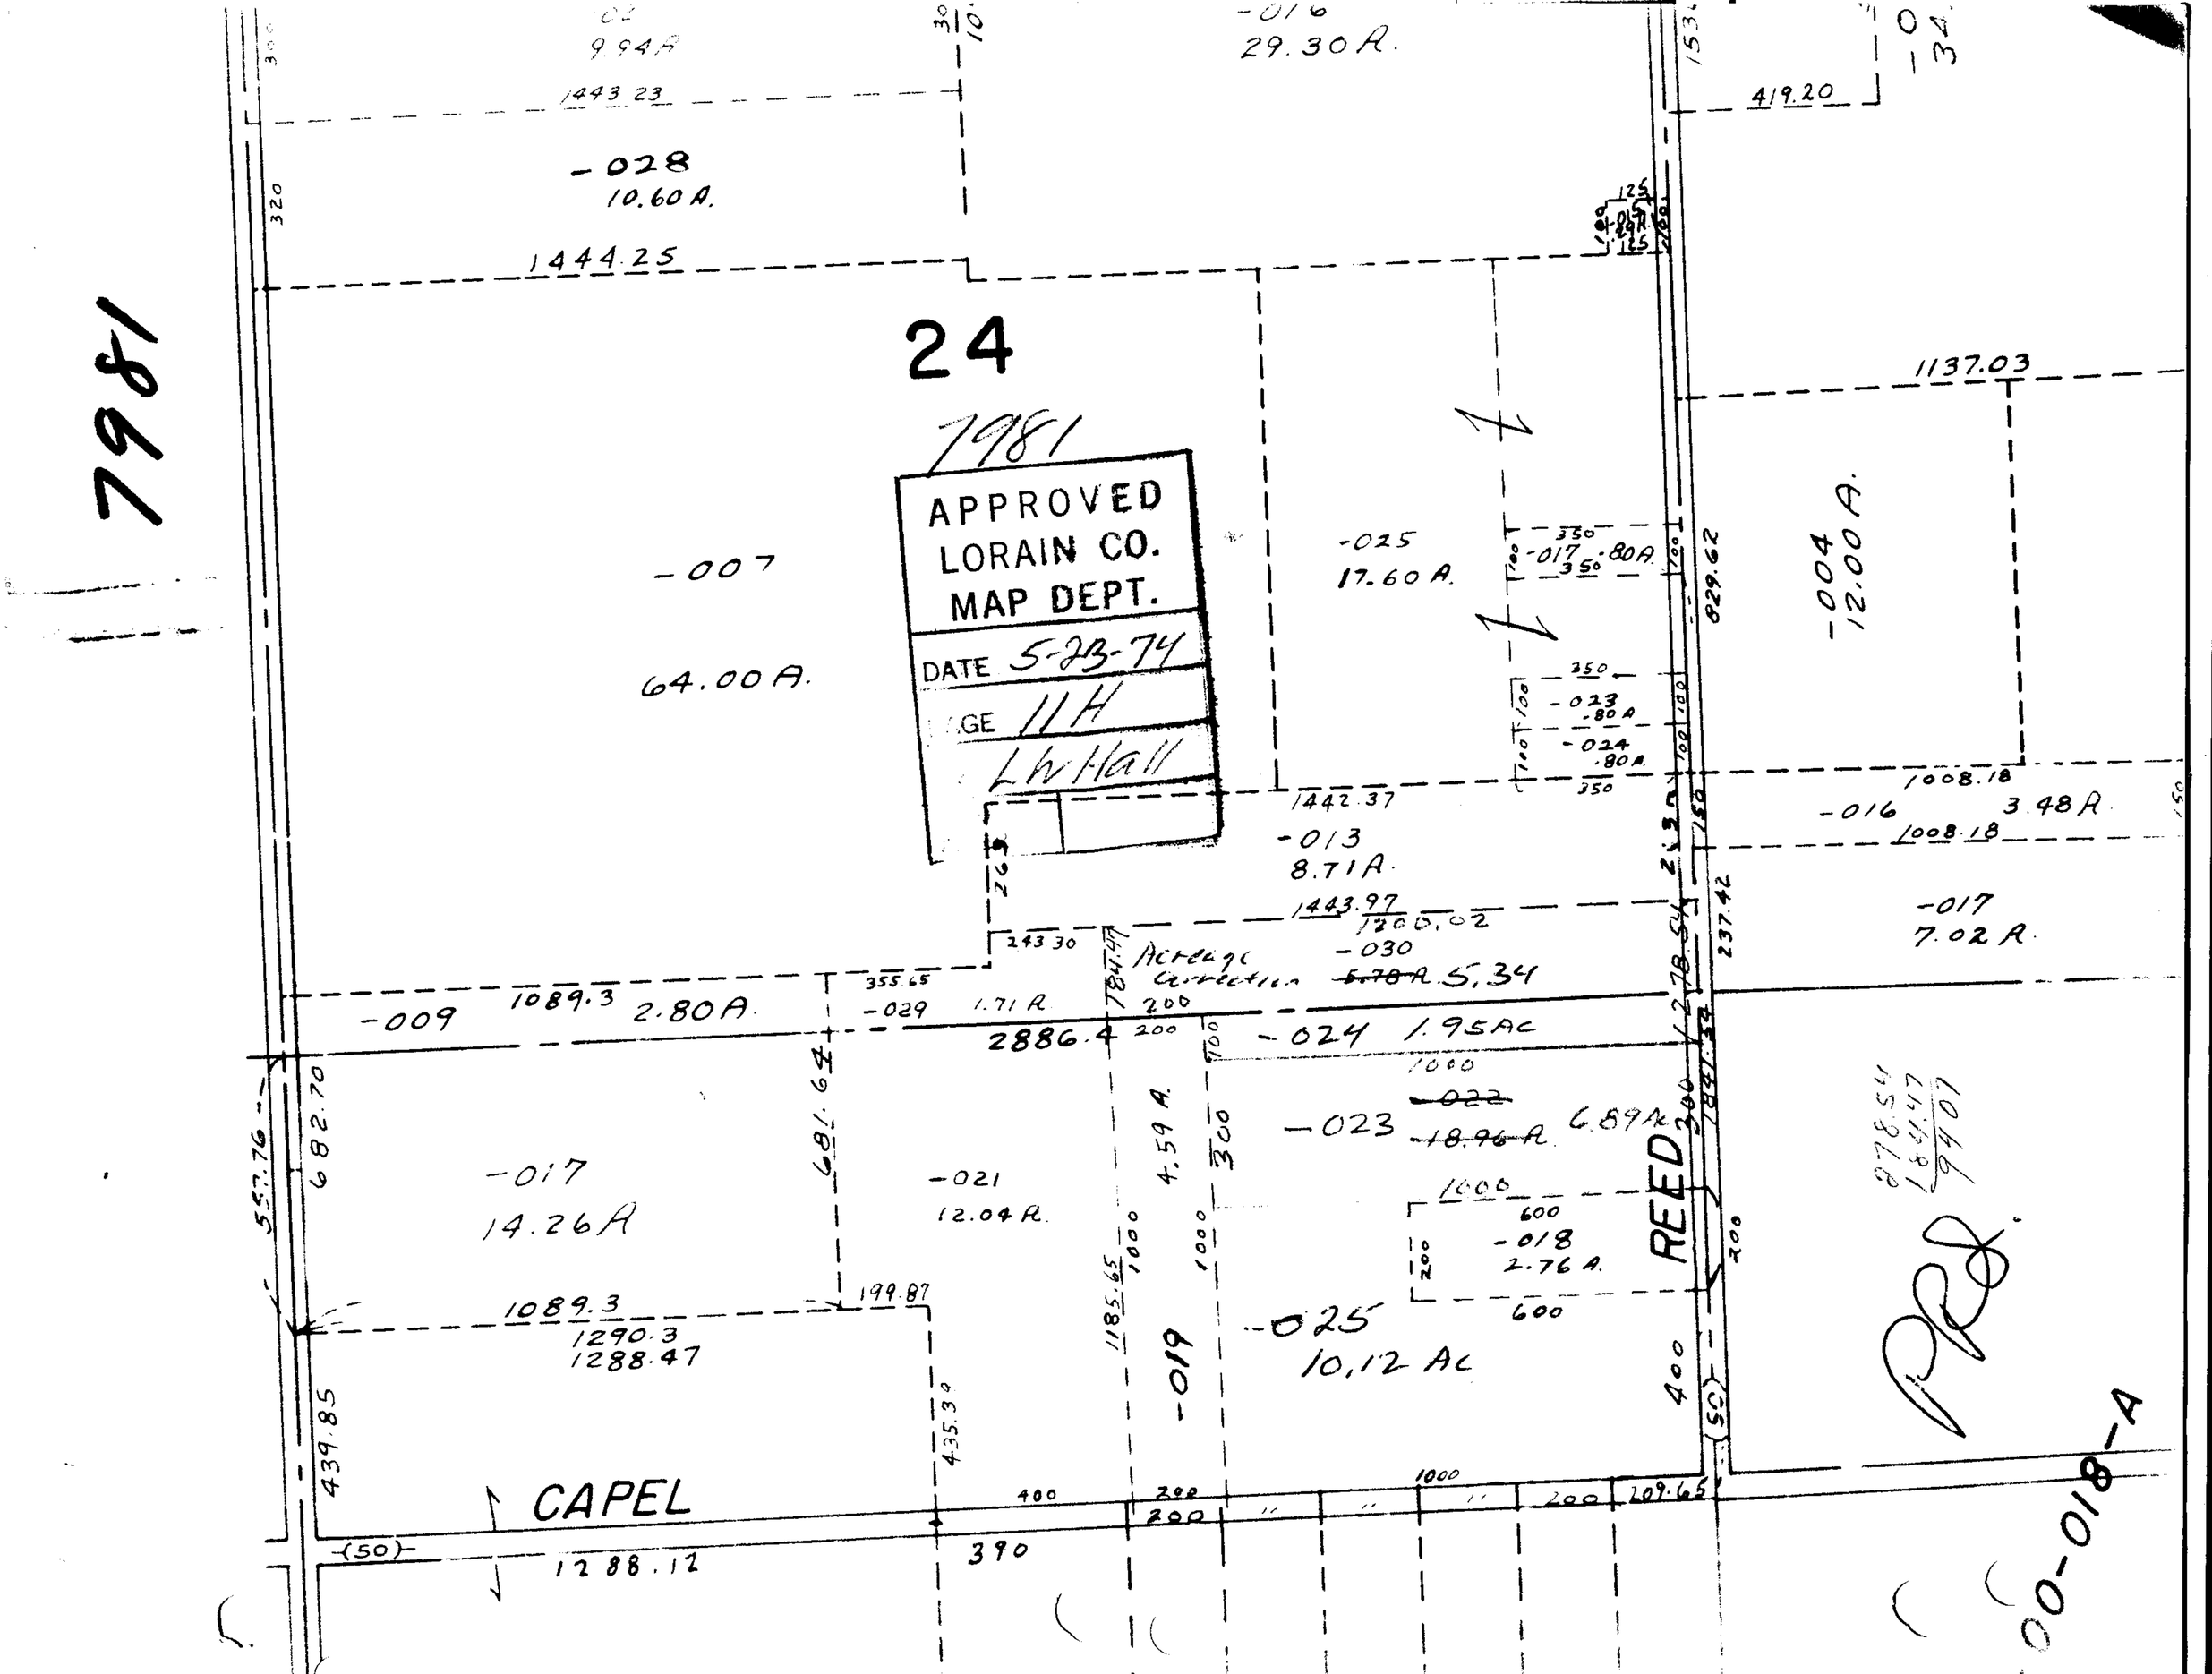

7981
24
7981
APPROVED
LORAIN CO.
MAP DEPT.
DATE 5-23-74
PAGE 11H
LW Hall
-028
10.60 A.
1444.25
-007
64.00 A.
-016
29.30 A.
419.20
1137.03
-025
17.60 A.
-017
.80 A.
-004
12.00 A.
829.62
-023
.80 A
-024
.80 A
1008.18
-016
3.48 A
1008.18
1442.37
-013
8.71 A.
1443.97
1200.02
-030
5.34
-017
7.02 A.
Acreage Correction
-009
1089.3
2.80 A.
-029
1.71 A.
2886.4
-024
1.95 Ac
-023
6.89 Ac
-022
18.96 A.
-017
14.26 A
-021
12.04 A.
4.59 A.
-018
2.76 A.
REED
-025
10.12 Ac
-019
1089.3
1290.3
1288.47
CAPEL
1288.12
390
209.65
00-018-A